
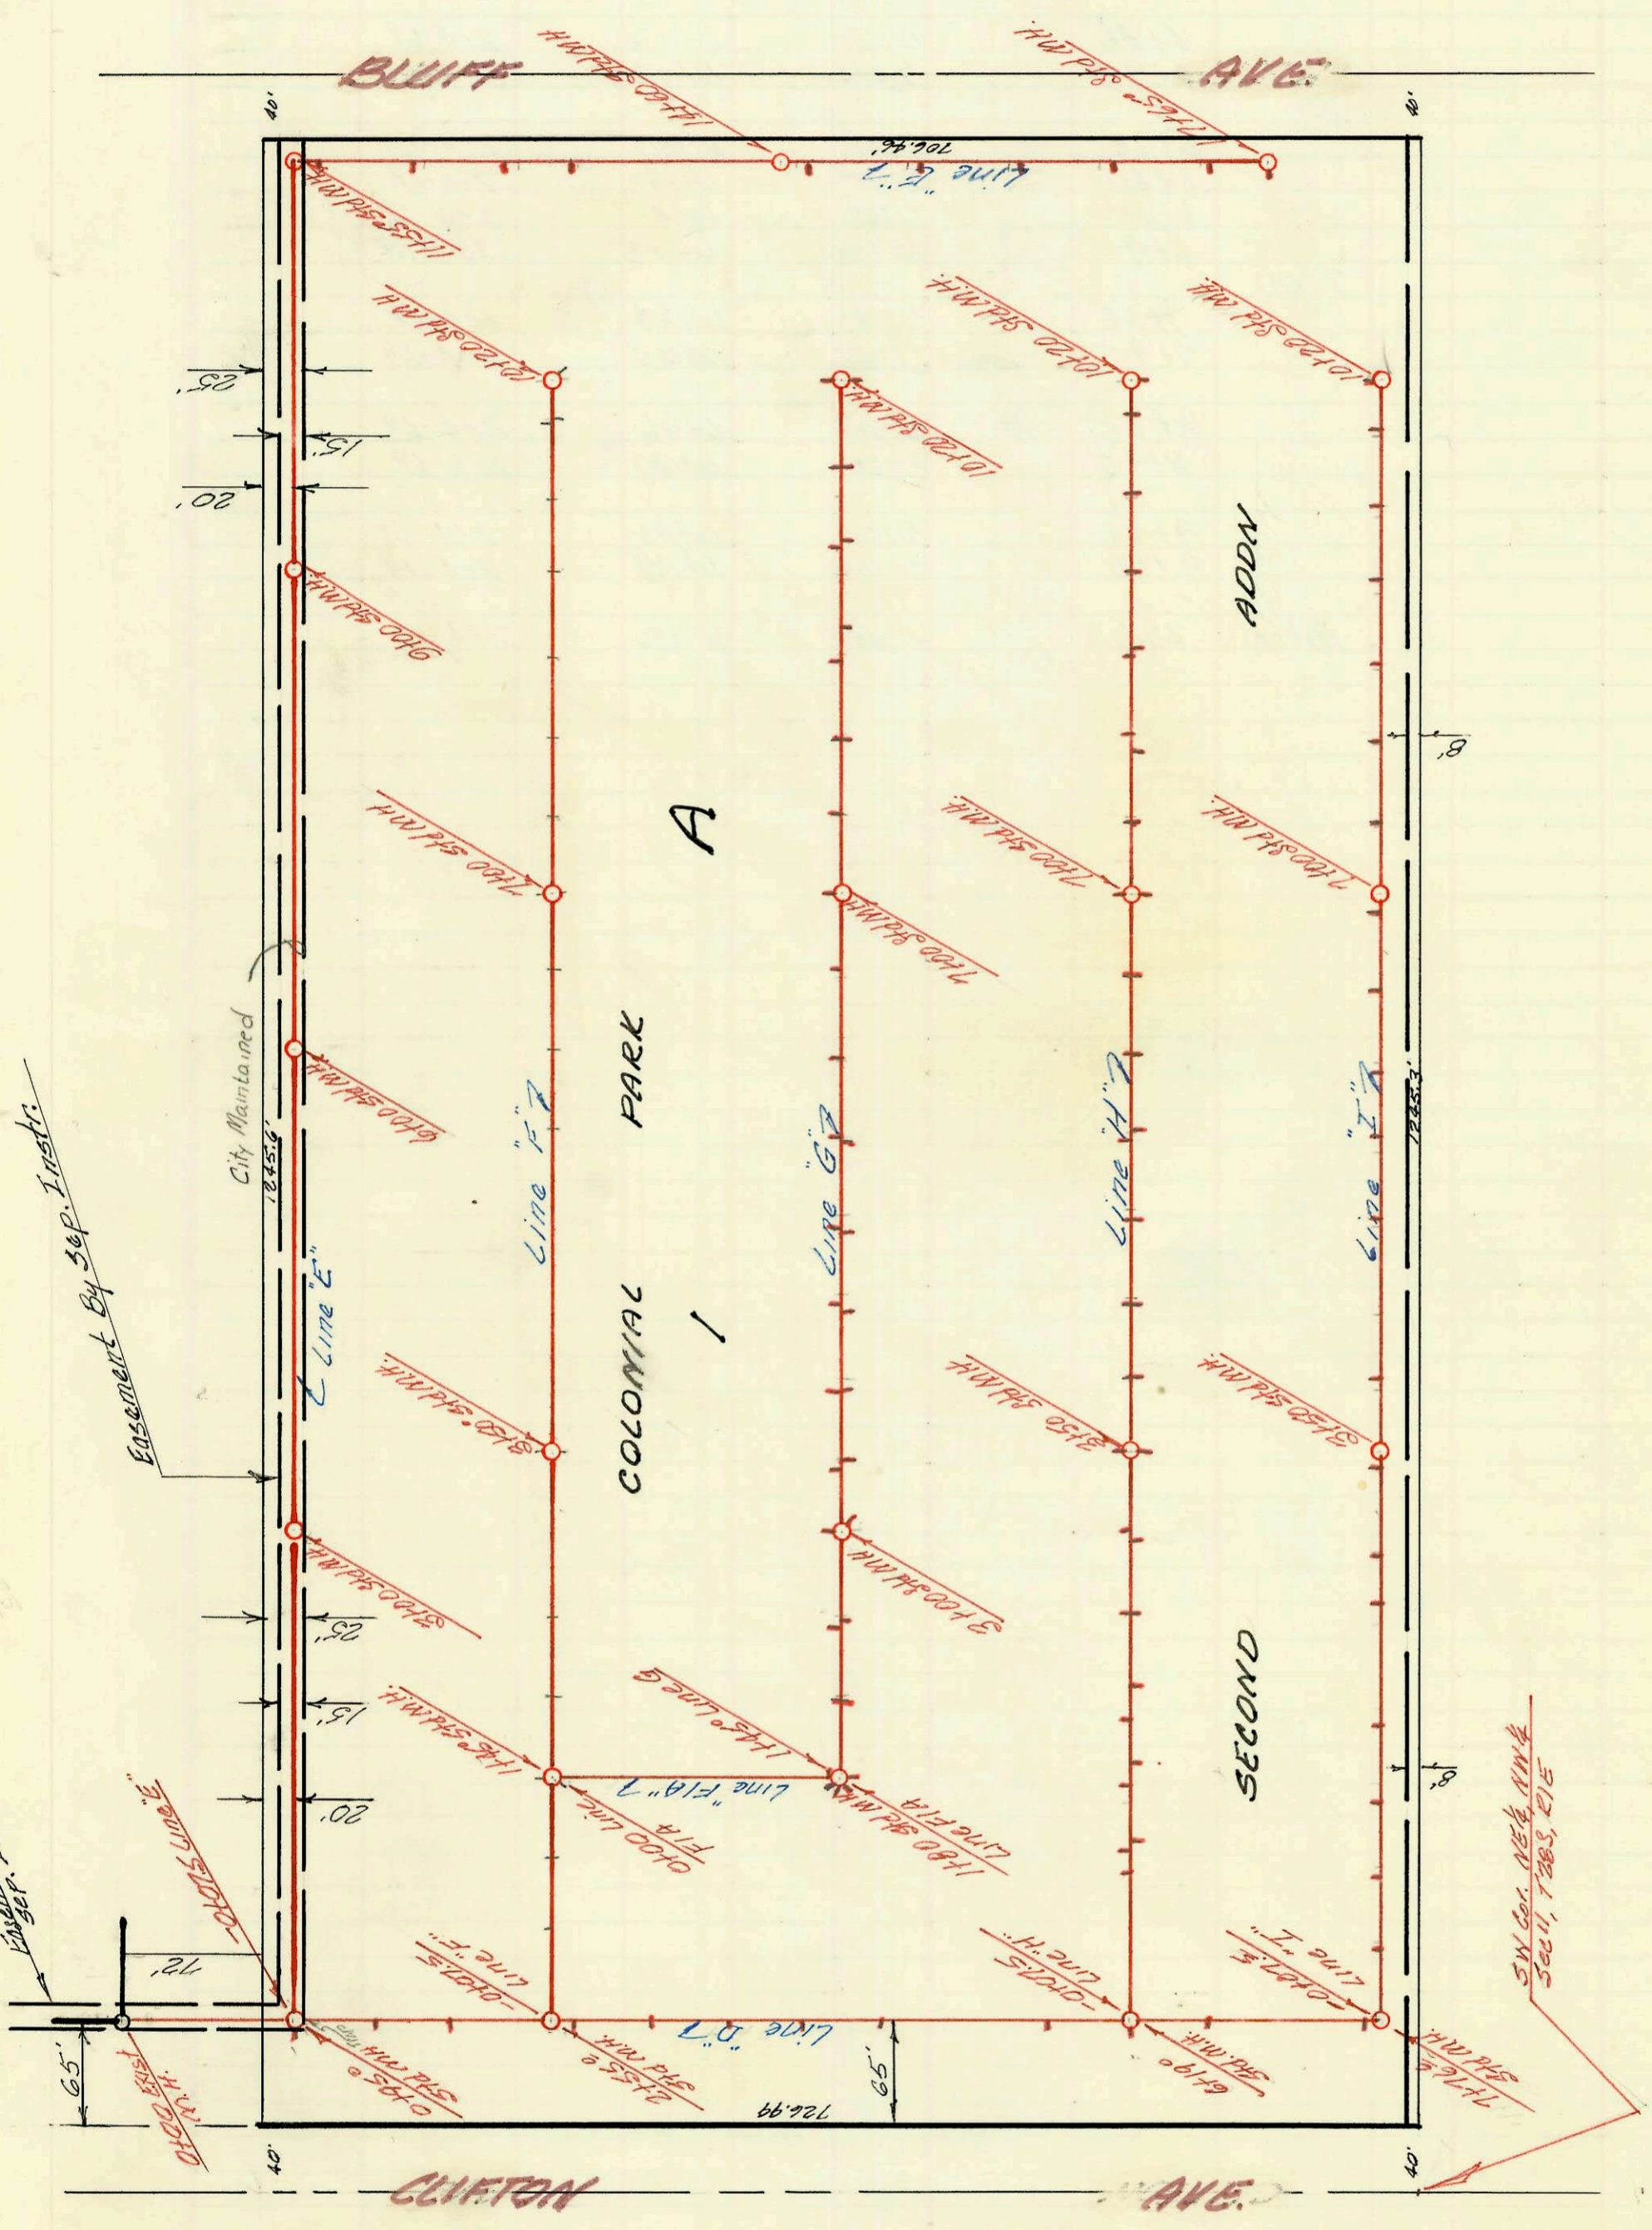


CONSTRUCTION RECORD

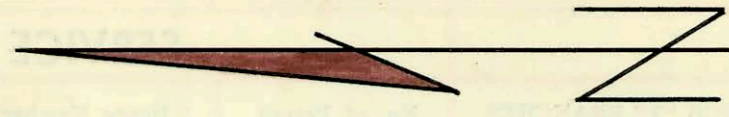

* NOTE: City maintains line E- Sta. 0100 to 117 55
 Remaining lines are private system

PRIVATE SAN SEWER
 COLONIAL PARK 2ND ADDN.
 TRICO CONSTR. Co.
 Constr. Jan 1969 Booked From
 Plan April 1970 Scale 1"=100'

on map

