
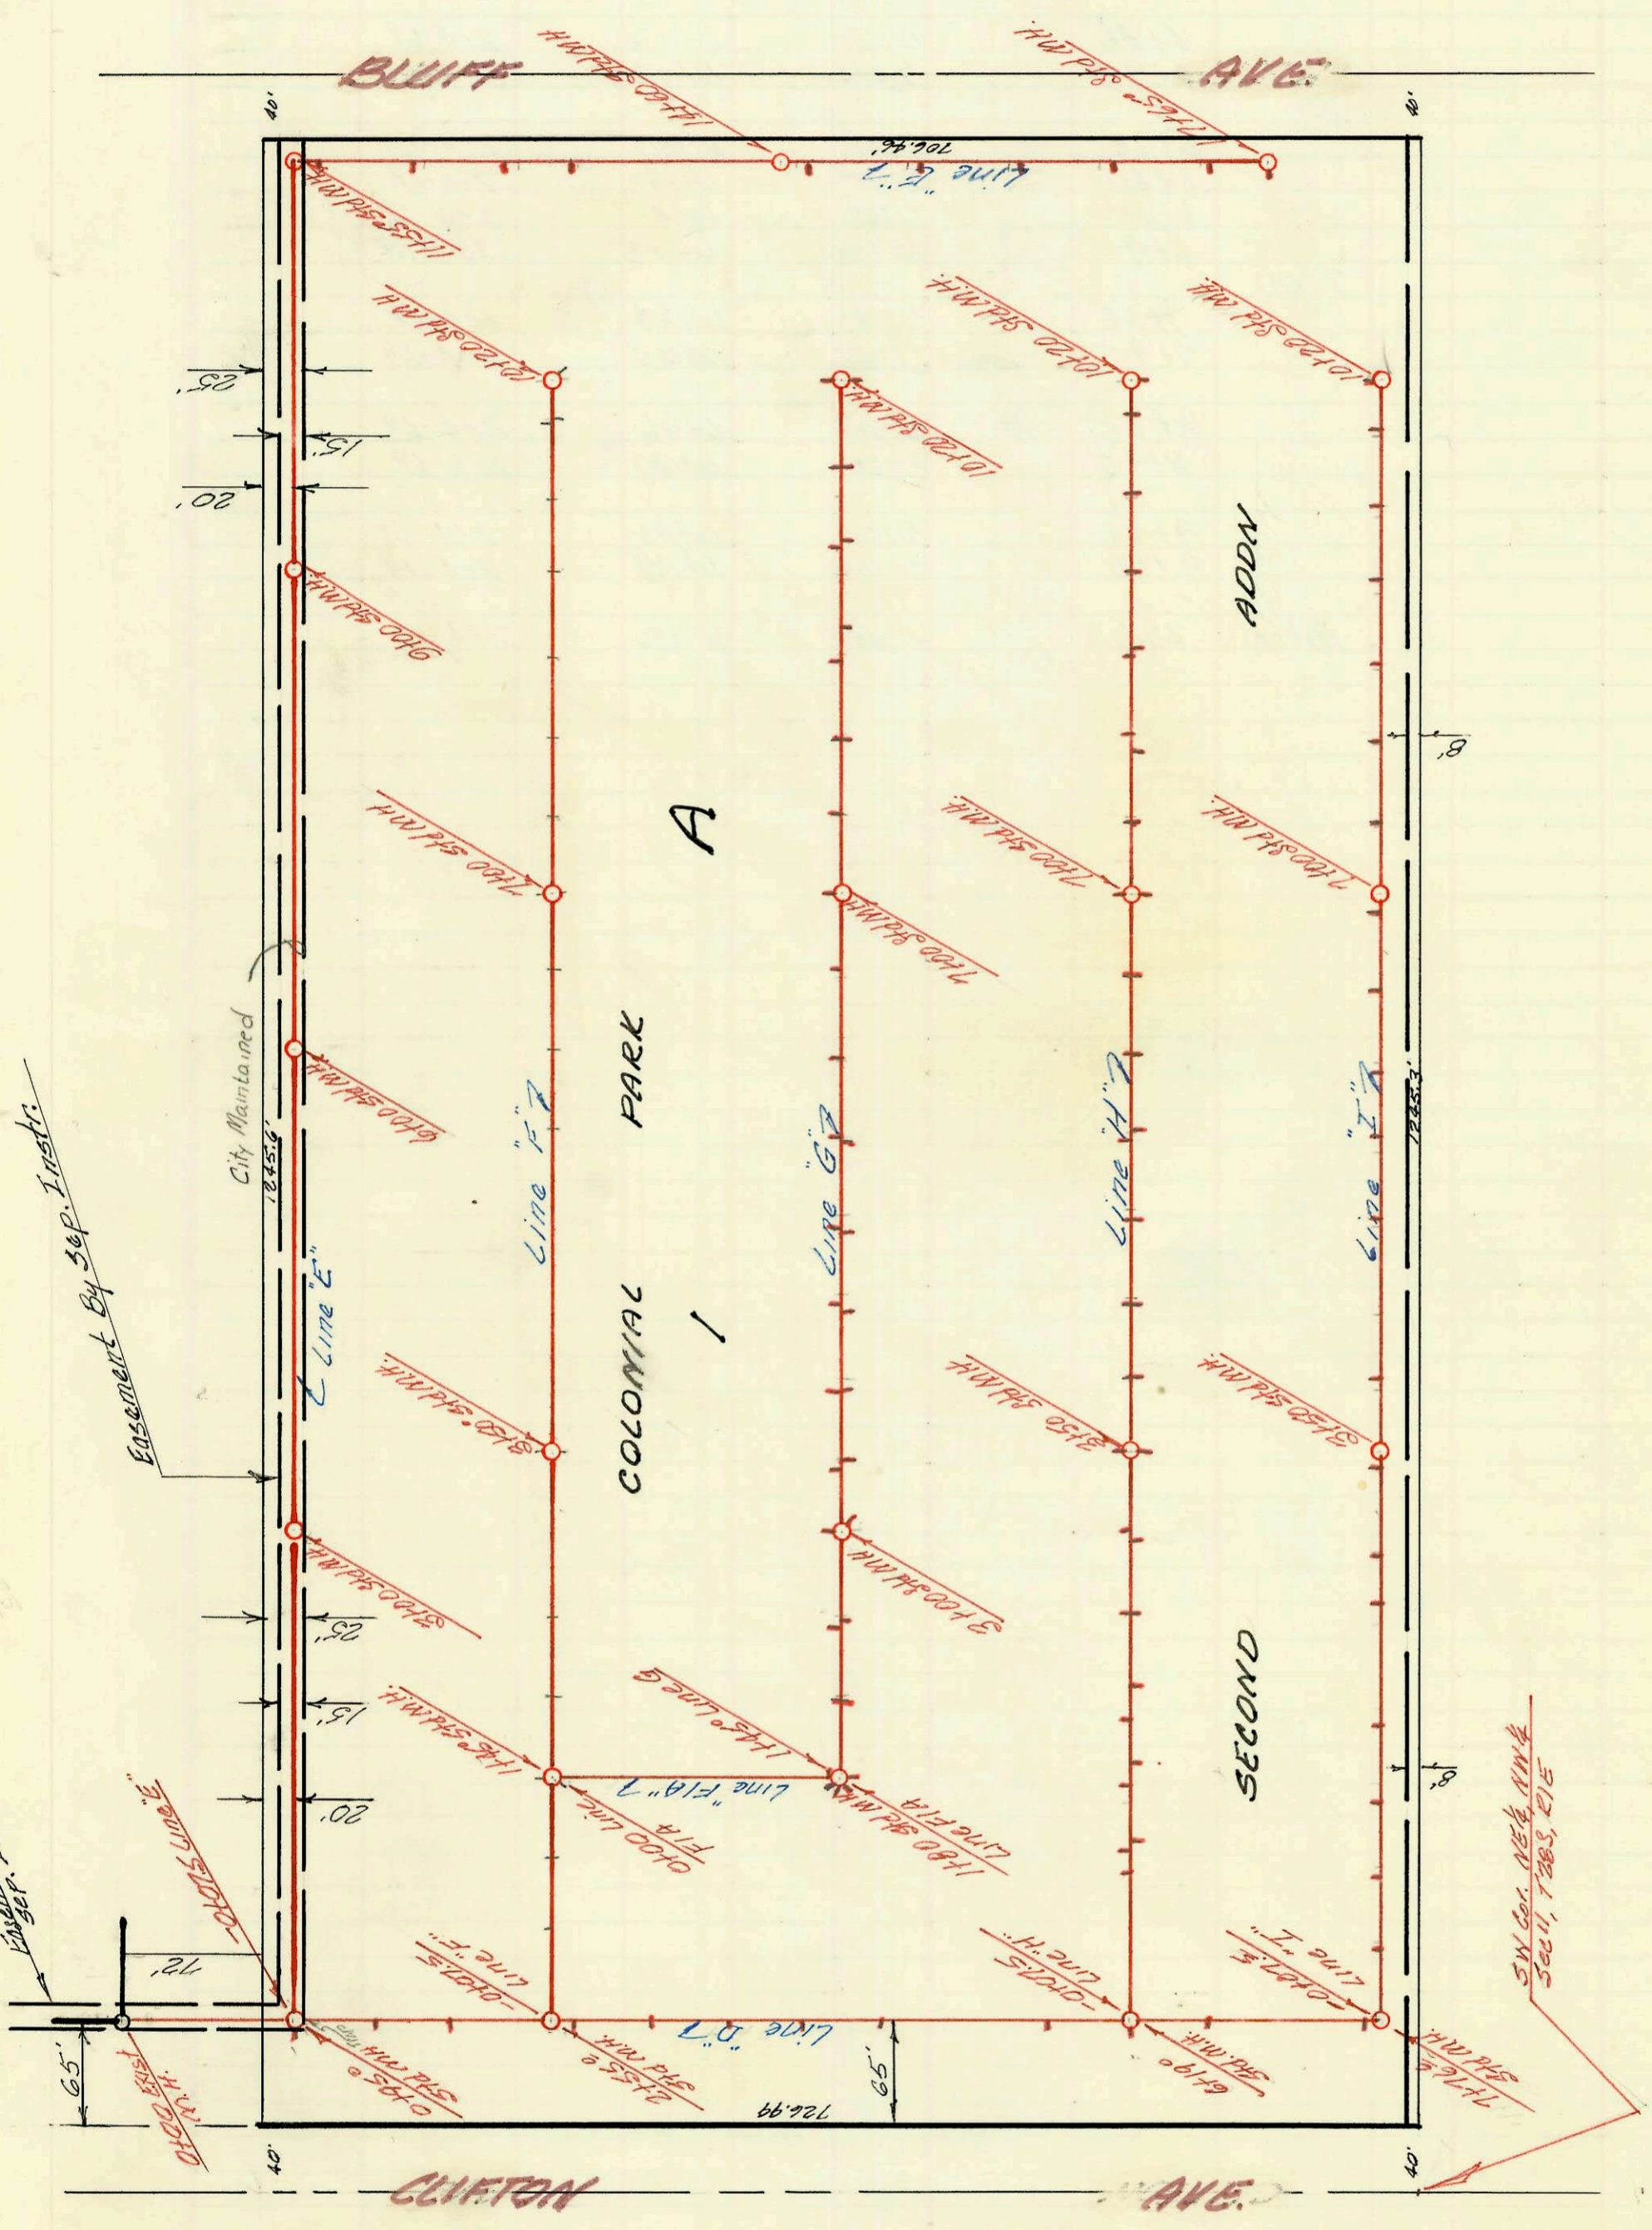


CONSTRUCTION RECORD

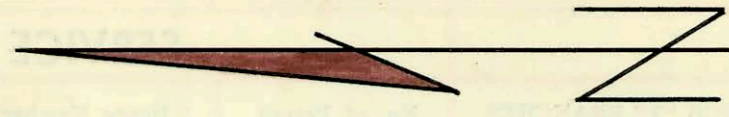

* NOTE: City maintains line E- Sta. 0100 to 11+55
 Remaining lines are private system

PRIVATE SAN SEWER
 COLONIAL PARK 2ND ADDN.
 TRICO CONSTR. CO.
 Constr. Jan 1969 Booked From
 Plan April 1970 Scale 1"=100'

on map

CONSTRUCTION RECORD						SERVICE RECORD						
STATION	ELEVATION		Depth	MANHOLE	4-INCH "Y" BRANCHES		No. of Permit		House Number		DATE OF PERMITS	
	Ground	Grade			North West	South East	North West	South East	North West	South East	North West	South East
	Line I cont'd											
4+00				3+50 ⁰	3+95		C12493		Lot 177		2-4-69	
					4+36		C12490		Lot 178		2-4-69	
5+00					4+95		C12494		Lot 179		2-4-69	
					5+48		C12495		Lot 180		2-4-69	
					6+40		C12497		Lot 182		2-4-69	
					6+88		C12496		Lot 181		2-4-69	
				7+00	6+90		C12492		Lot 183		2-4-69	
					7+45		C12499		Lot 184		2-4-69	
8+00					7+95		C12500		Lot 185		2-4-69	
					8+45		C12501		Lot 186		2-4-69	
					8+95		C12502		Lot 187		2-4-69	
9+00					9+41		C12503		Lot 188		2-4-69	
					9+90		C12504		Lot 189		2-4-69	
10+00				10+20	10+6N		C12505		Lot 190		2-4-69	

