
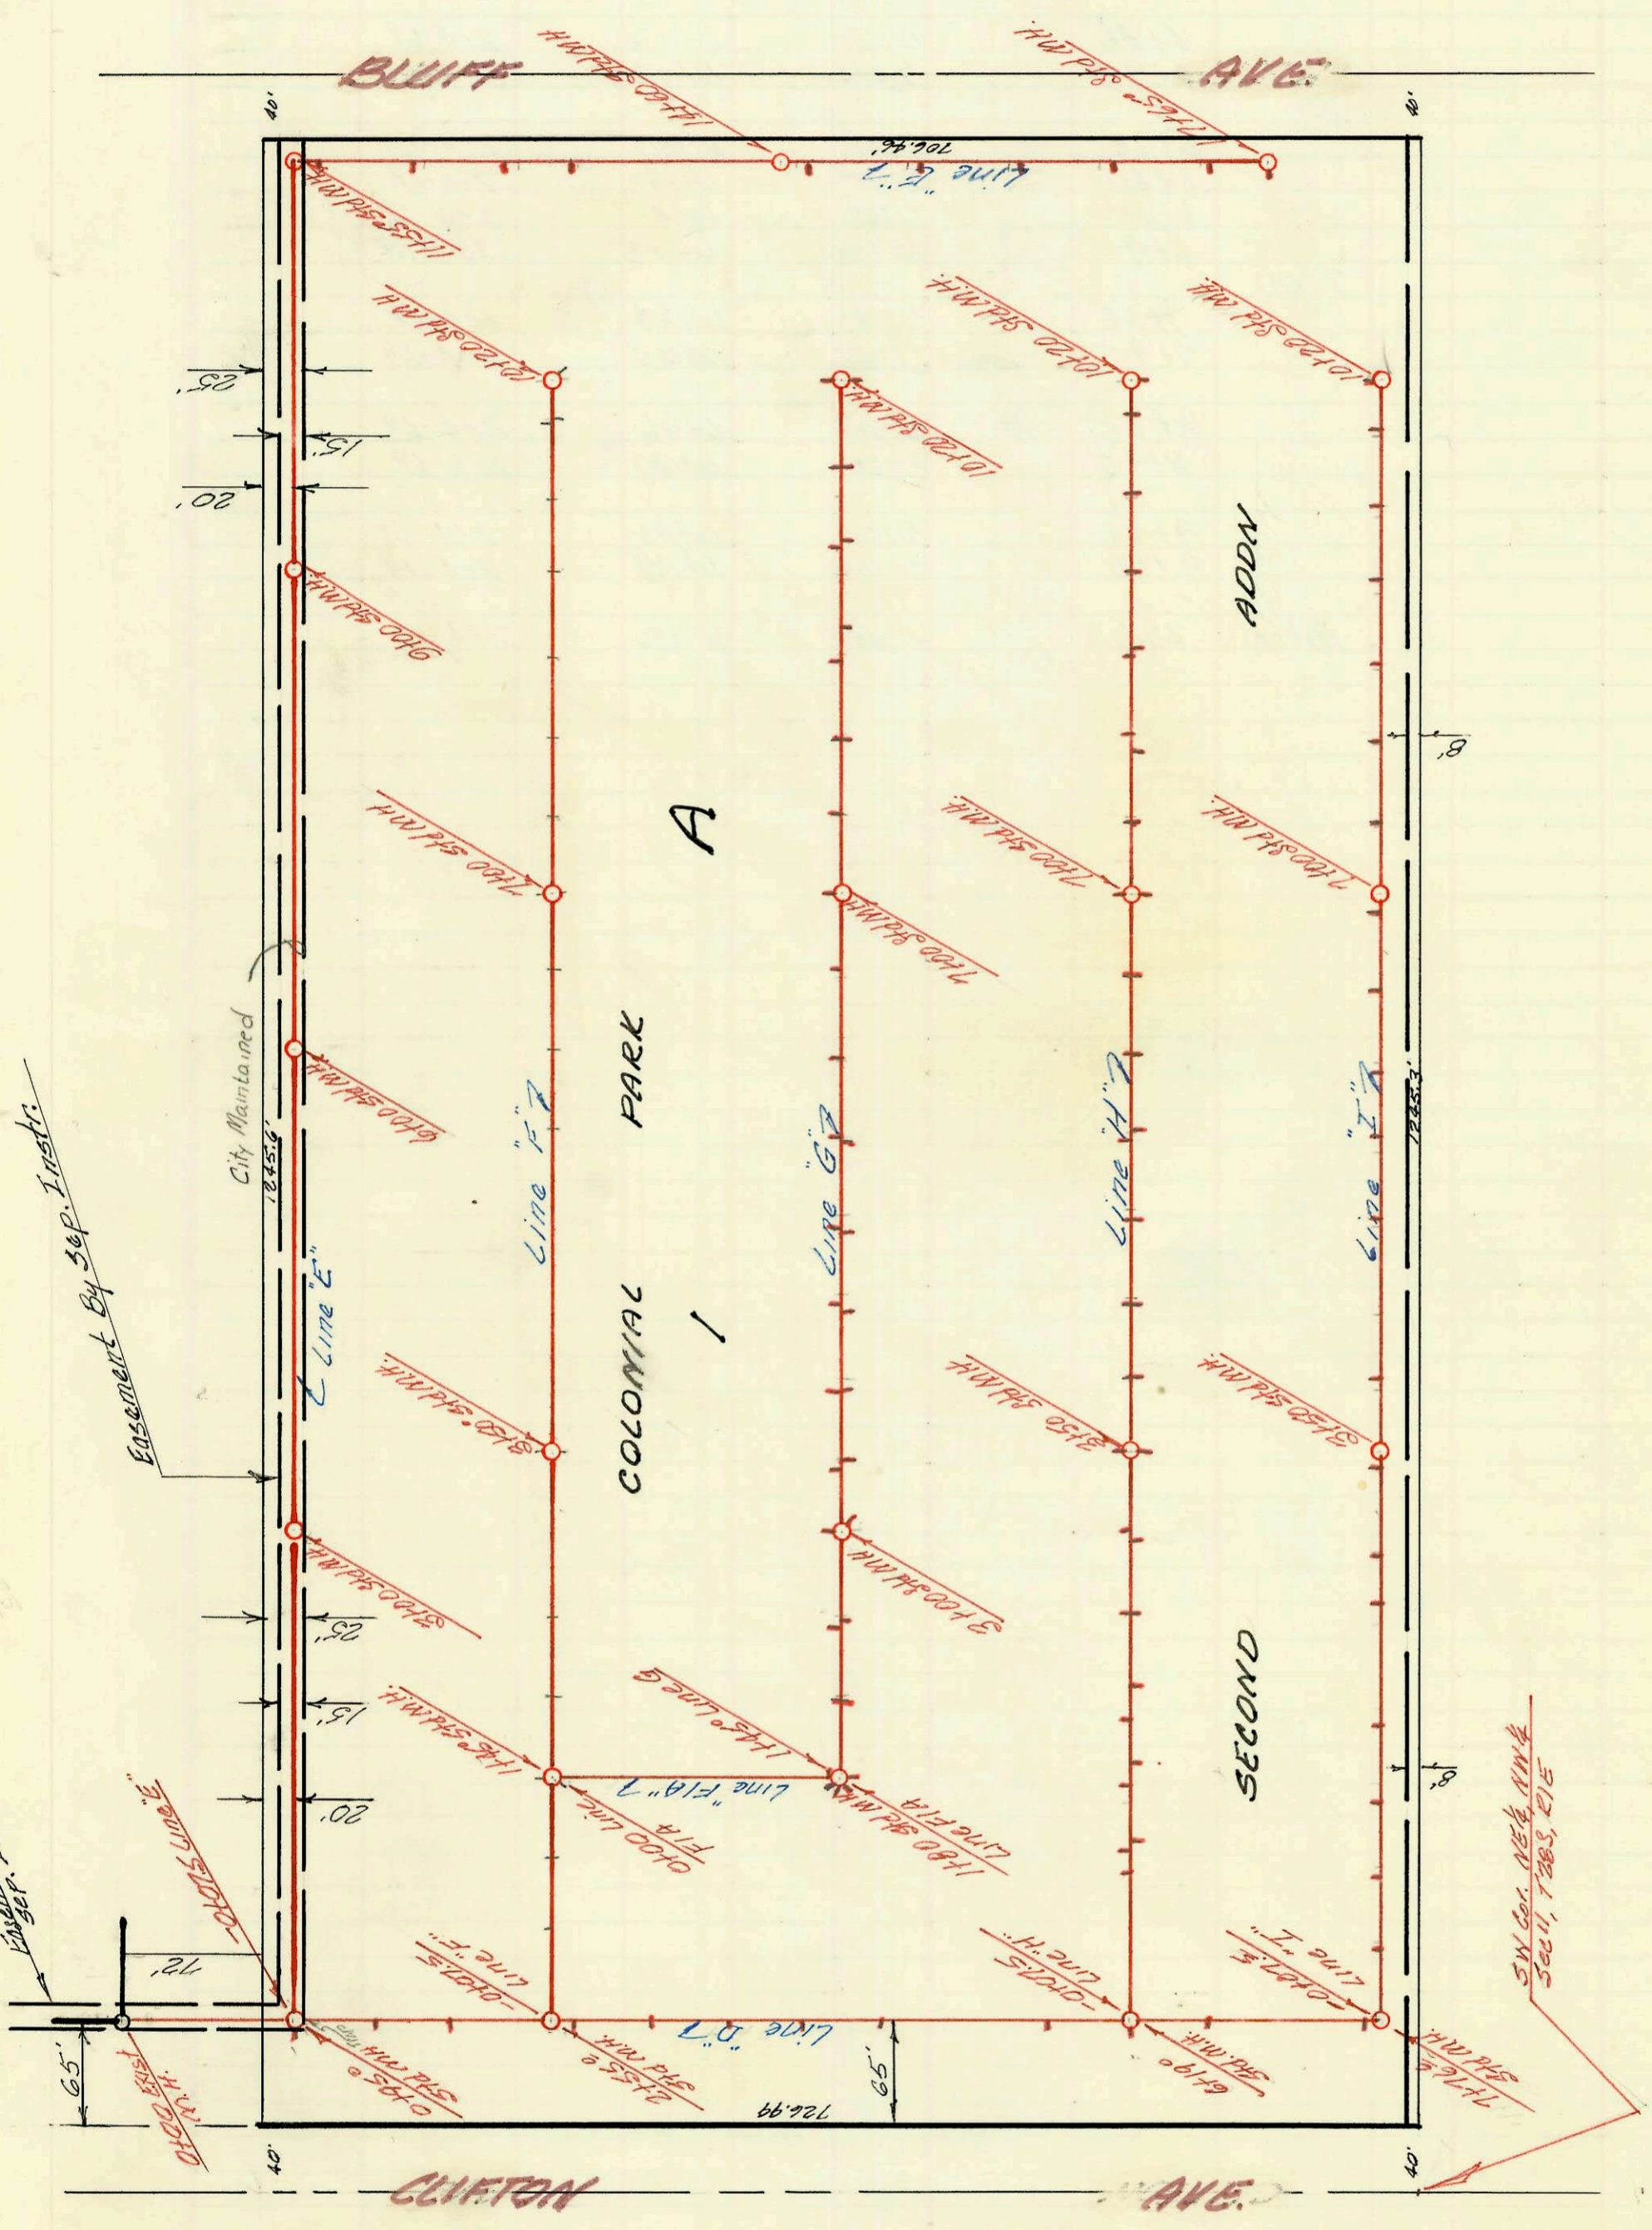


CONSTRUCTION RECORD

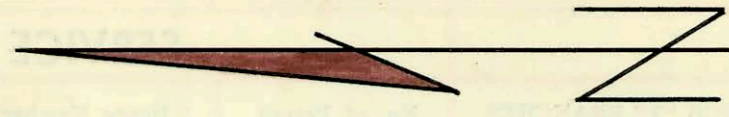

\* NOTE: City maintains line E- Sta. 0100 to 115.55  
 Remaining lines are private system

PRIVATE SAN. SEWER  
 COLONIAL PARK 2ND ADDN.  
 TRICO CONSTR. Co.  
 Constr. Jan 1969 Booked From  
 Plan April 1970 Scale 1"=100'

on map

CONSTRUCTION RECORD						SERVICE RECORD							
STATION	ELEVATION		Depth	MANHOLE	4-INCH "Y" BRANCHES		No. of Permit		House Number		DATE OF PERMITS		
	Ground	Grade			North West	South East	North West	South East	North West	South East	North West	South East	
Line G Cont													
4+00													
						4+38°		C12525	Lot 247			2-4-69	
						4+41		C12538	Lot 264			2-4-69	
5+00						4+89	4+91	C12529	C12526	Lot 265	Lot 246	2-4-69	2-4-69
							5+46	C12527		Lot 215		2-4-69	
						5+47		C12540		Lot 266		2-4-69	
6+00						5+96	5+94	C12541	C12528	Lot 267	Lot 244	2-4-69	2-4-69
						6+51	6+48	C12542	C12529	Lot 268	Lot 243	2-4-69	2-4-69
				7+00		4" 3/16 N	4" 3/16 S	C12543	C12531	Lot 269	Lot 242	2-4-69	2-4-69
						7+47°	7+49	C12544	C12530	Lot 270	Lot 241	2-4-69	2-4-69
						7+96	7+98	C12545	C12554	Lot 271	Lot 240	2-4-69	2-4-69
8+00						8+48	8+65	C12546	C12552	Lot 272	Lot 239	2-4-69	2-4-69
9+00						9+14	9+20	C12547	C12552	Lot 273	Lot 238	2-4-69	2-4-69
						9+65	9+67	C12548	C12551	Lot 274	Lot 237	2-4-69	2-4-69
				10+20		4" 3/16 N	4" 3/16 S	C12549	C12550	Lot 275	Lot 236	2-4-69	2-4-69
Line H													
						-0+075	0+845	C12450		Lot 214		2-4-69	
						0+98°		C12489		Lot 213		2-4-69	
1+00							1+07	C12488		Lot 212		2-4-69	
						1+395		C12451		Lot 215		2-4-69	
							1+55°	C12487		Lot 211		2-4-69	
2+00						1+815		C12452		Lot 216		2-4-69	
							2+01°	C12486		Lot 210		2-4-69	
						2+48°	2+50	C12453	C12485	Lot 217	Lot 209	2-4-69	2-4-69
							2+97	C12484		Lot 208		2-4-69	
				3+50°		3+00		C12454		Lot 218		2-4-69	
						4" 3/16 N	4" 3/16 S	C12455	C12483	Lot 219	Lot 207	2-4-69	2-4-69
4+00						3+94	3+92	C12456	C12482	Lot 220	Lot 206	2-4-69	2-4-69
						4+42	4+40	C12457	C12481	Lot 221	Lot 205	2-4-69	2-4-69
5+00						4+95	4+93	C12458	C12480	Lot 222	Lot 204	2-4-69	2-4-69
6+00						5+44	5+54	C12459	C12479	Lot 223	Lot 203	2-4-69	2-4-69
						6+01	6+03	C12460	C12478	Lot 224	Lot 202	2-4-69	2-4-69
						6+48	6+50	C12461	C12477	Lot 225	Lot 201	2-4-69	2-4-69
				7+00		4" 3/16 N	4" 3/16 S	C12462	C12476	Lot 226	Lot 200	2-4-69	2-4-69
						7+45	7+47	C12463	C12475	Lot 227	Lot 199	2-4-69	2-4-69
8+00							7+90	C12474		Lot 198		2-4-69	
						8+01		C12464		Lot 228		2-4-69	
						8+49	8+53	C12465	C12473	Lot 229	Lot 197	2-4-69	2-4-69
9+00						9+02	9+00	C12466	C12472	Lot 230	Lot 196	2-4-69	2-4-69
						9+49	9+51	C12467	C12471	Lot 231	Lot 195	2-4-69	2-4-69
10+00						9+98	9+99	C12468	C12470	Lot 232	Lot 194	2-4-69	2-4-69
				10+20			4" 3/16 S	C12469		Lot 193		2-4-69	
Line "I"													
						-0+075	0+345	C12446		Lot 170		2-4-69	
						0+815		C12447		Lot 171		2-4-69	
1+00						1+275	1+275	C12448		Lot 172		2-4-69	
						1+775	1+775	C12449		Lot 173		2-4-69	
2+00						2+550	2+550	C12490		Lot 174		2-4-69	
						2+850	2+850	C12491		Lot 175		2-4-69	
3+00						3+40		C12492		Lot 176		2-4-69	
						3+50							

