



SERVICE RECORD CONSTRUCTION RECORD

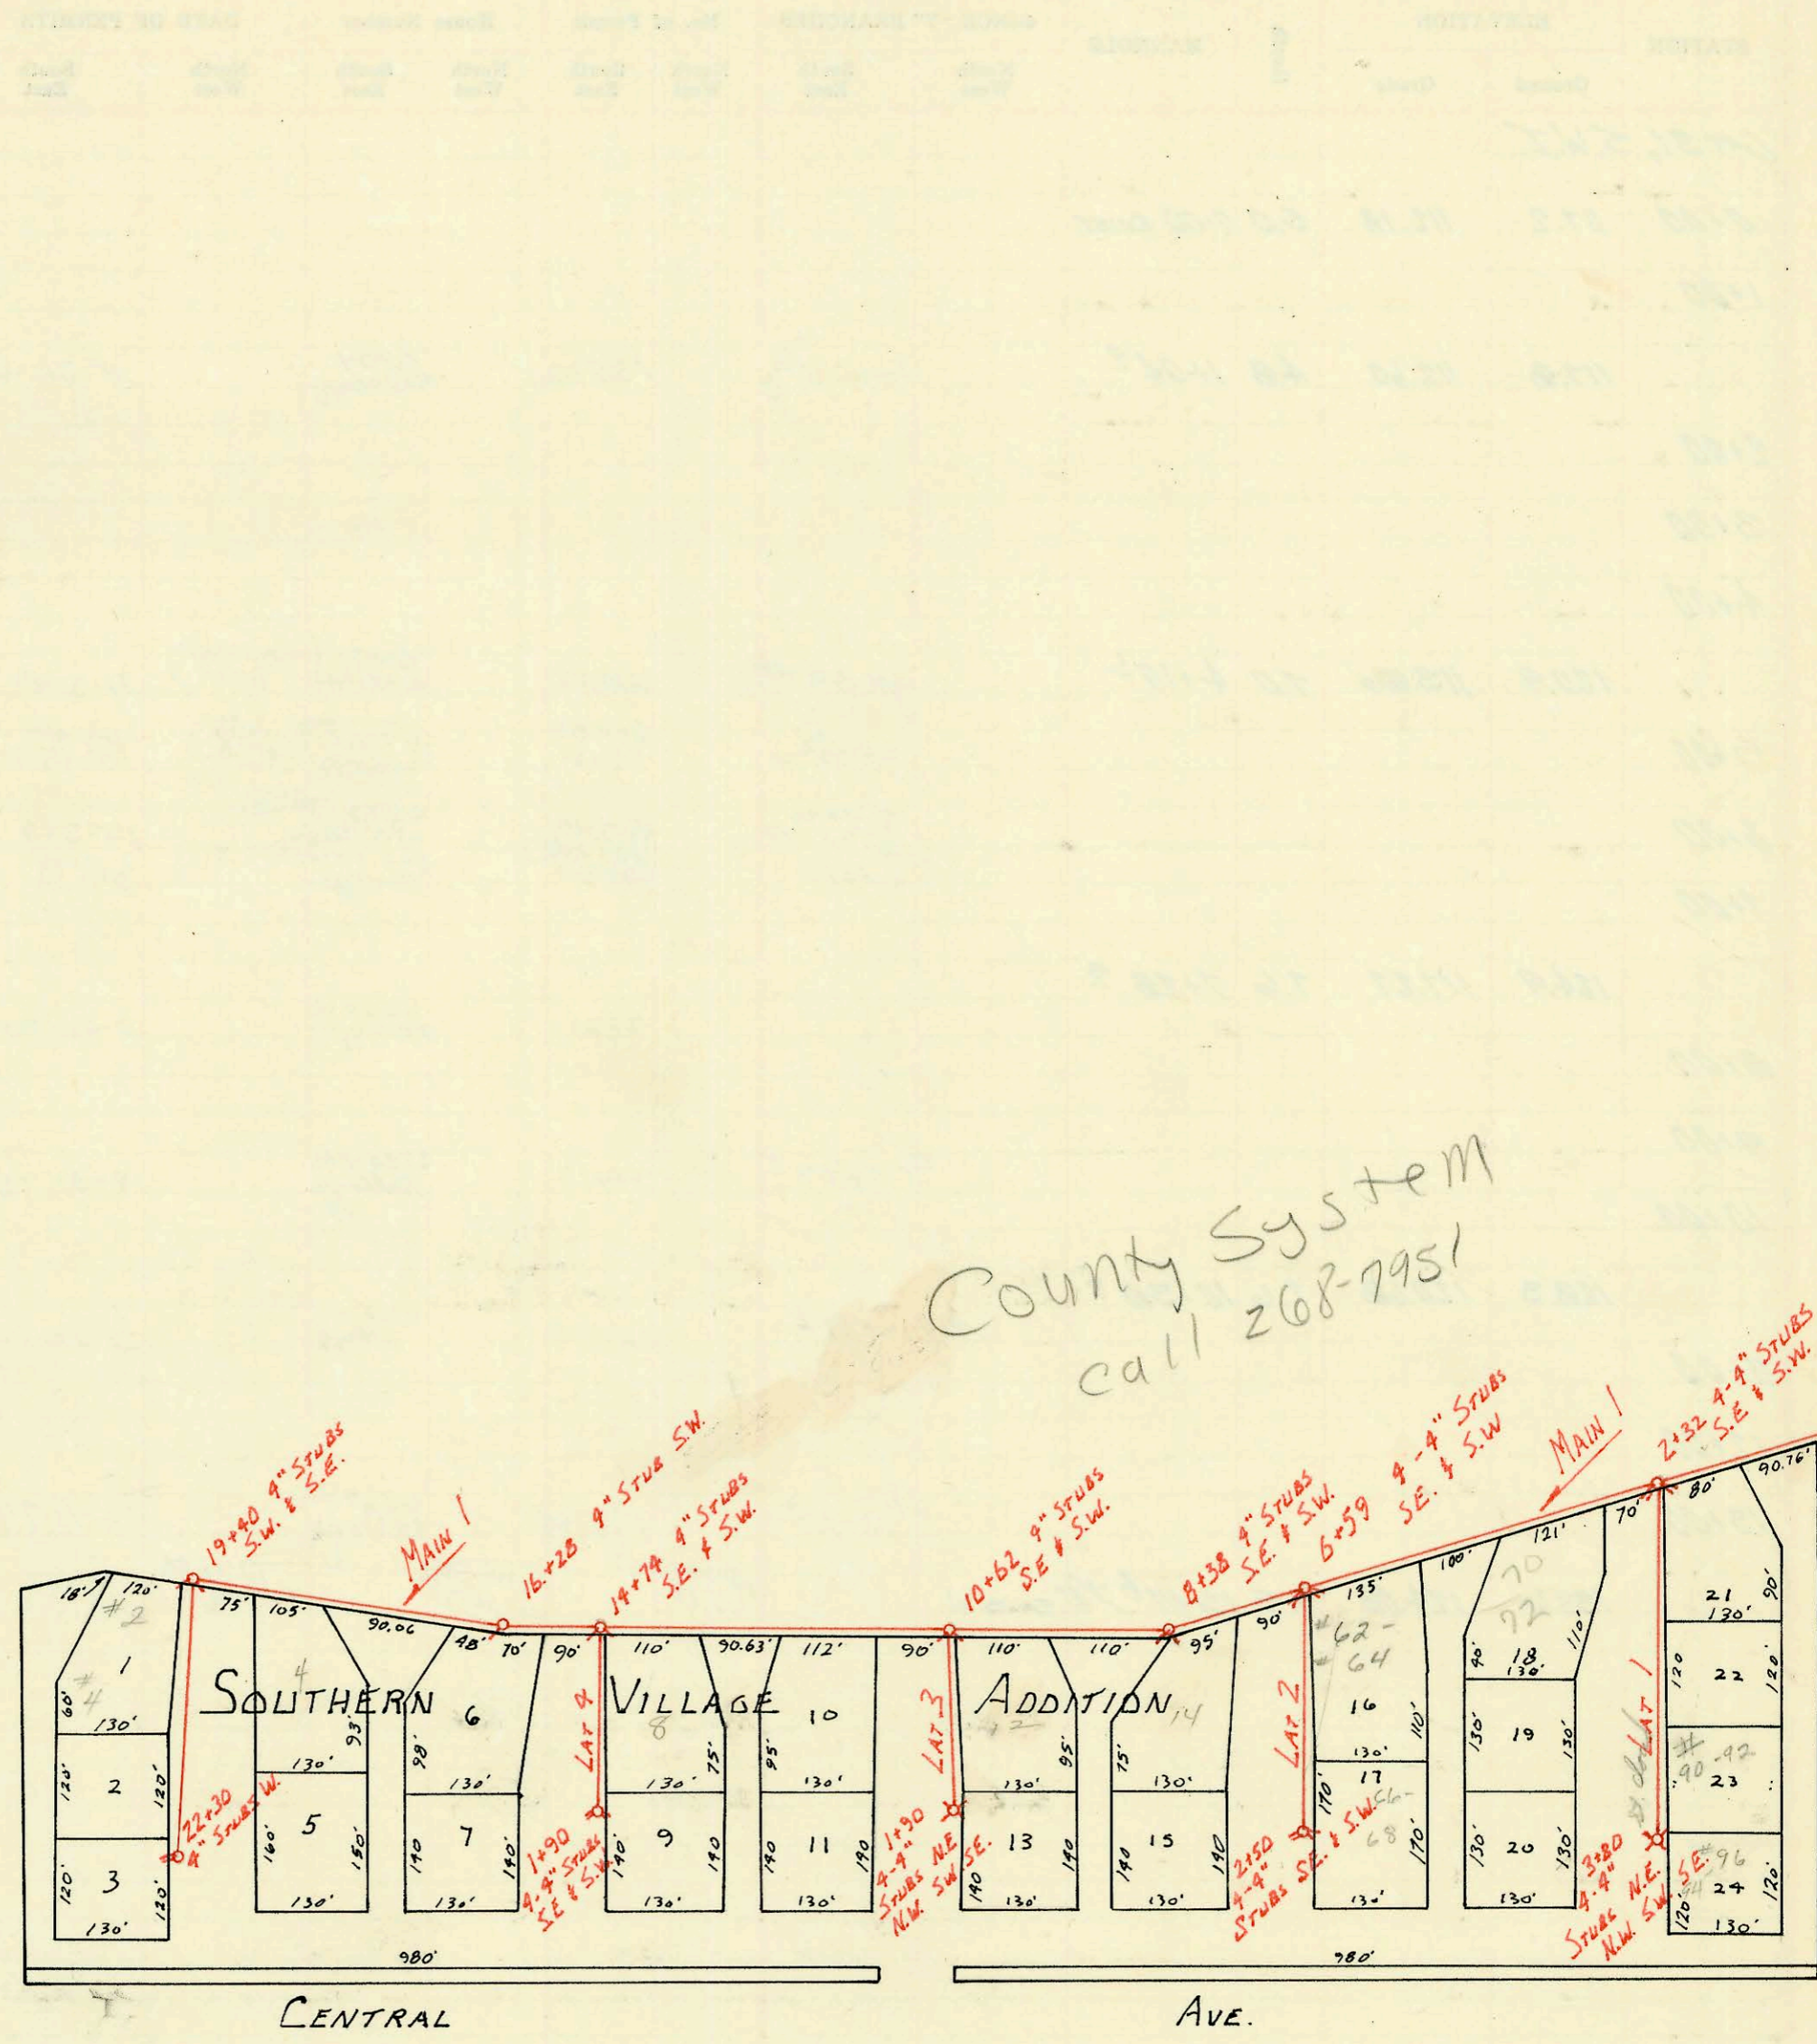

County System
call 268-7951

CENTRAL AVE.

SOUTHERN VILLAGE ADDITION
BOOKED 9 MARCH 73 FROM 'AS BUILT' PLANS
(MAIN & LATS. THAT CONNECT TO OUTFALL D)

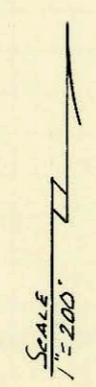

On map

