



CONSTRUCTION RECORD SERVICE RECORD

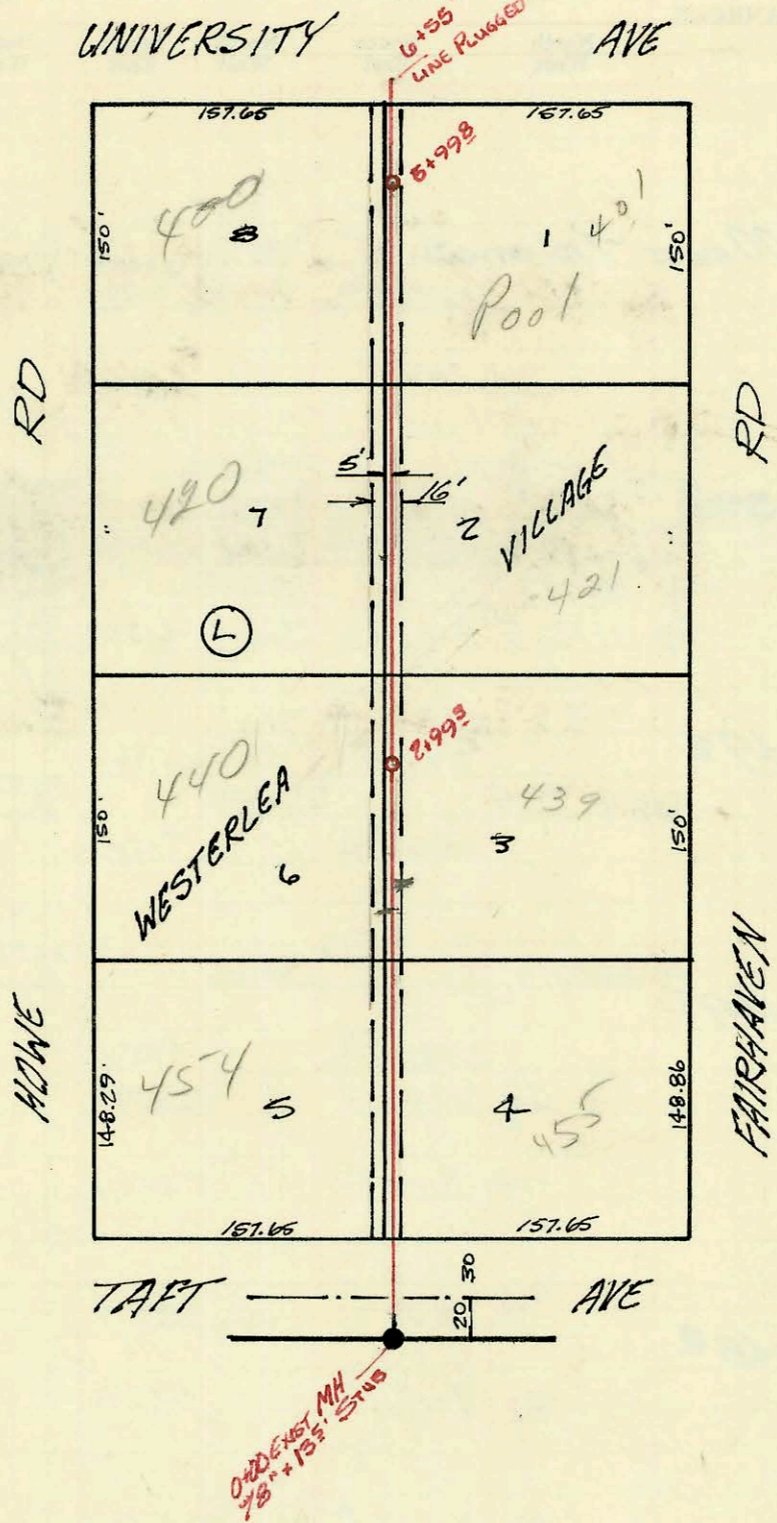

CAT 4, MAIN 4, S.W.I  
 BUILT BY: MID-STATES CONST. CO.  
 BOOKED 10 FEB 72 FROM K-107  
 PROJ. NO DBKLS71026

on map

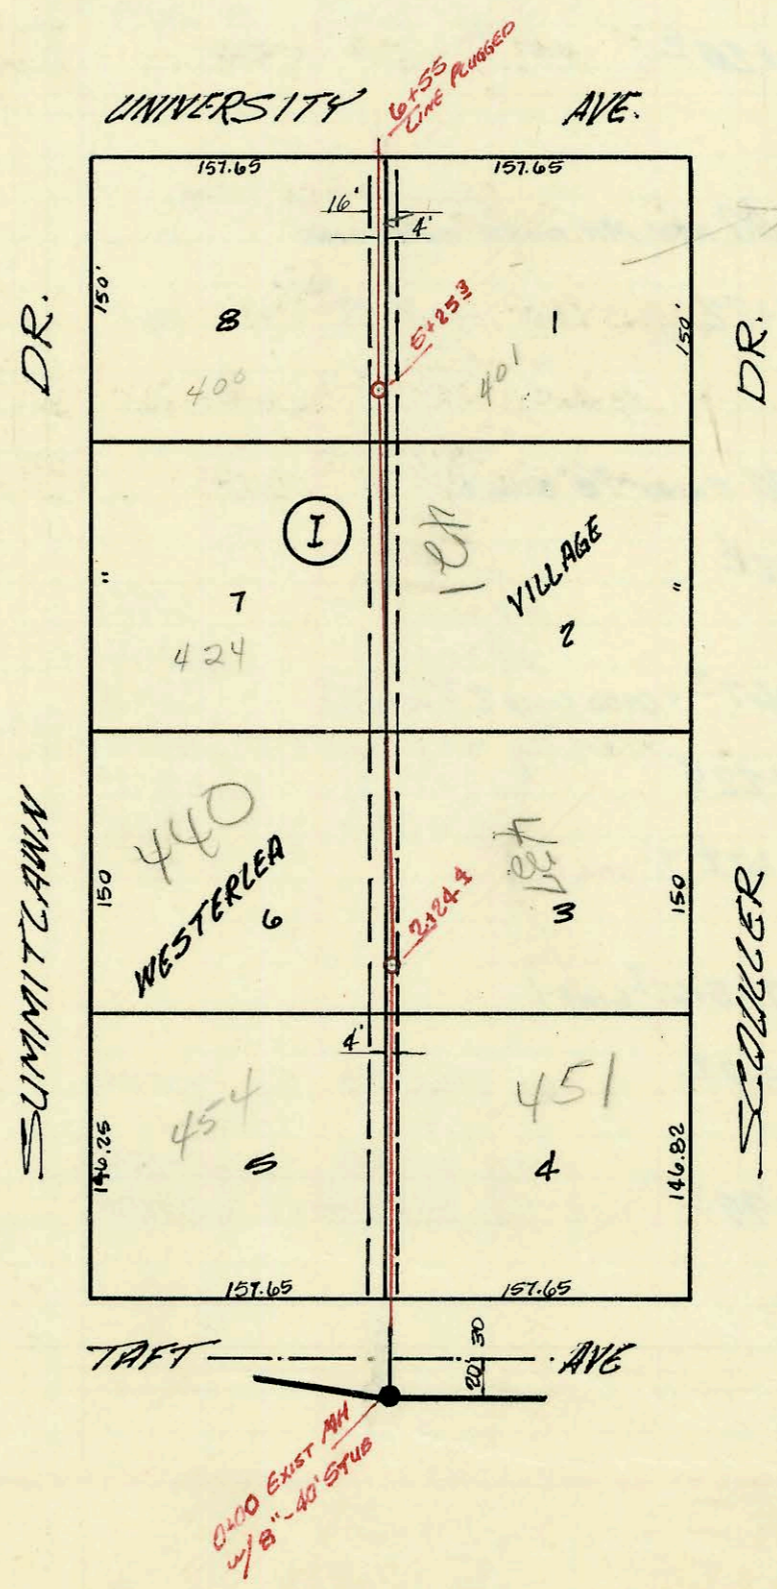

R. Young looked at copy of orig sewer permit and said garage to be built over EXIST LMS 4/9/03 BK

CAT 34, S.W.I  
 BUILT BY: W. B. CARTER CONST CO. INC.  
 BOOKED: 9 FEB 72 FROM K-79-A  
 PROJ. NO DBKLS70005

on map

CONSTRUCTION RECORD

SERVICE RECORD

STATION	ELEVATION		Depth	MANHOLE	4-INCH "Y" BRANCHES		No. of Permit		House Number		DATE OF PERMITS	
	Ground	Grade			North West	South East	North West	South East	North West	South East	North West	South East
LAT 4, MAIN 4, S.W.I												
0+00	124.5	114.70	9.7	EXIST 13'-8" STUB N.								
1+00				Jap 1+72	top 1+32.6		C29976	C42858	454 S. Howe	455 S. Faulkner	1-13-72	12-26-73
2+00				Jap 2+34	top 2+21.3		C31276	C30228	440 S. Howe	439 S. Faulkner	3-30-72	1-28-72
4+00	124.9	115.36	9.5	2+99	4+23.7 top Jap 4+05.3	4+01.4	23080 23079 C29977	C43646	420 Howe 420 S. Howe	421 S. Faulkner	5-5-84 5-5-87 1-13-72	2-26-74
5+00				Jap 5+18	top 5+32		C40057	C40019	400 S. Howe	401 S. Faulkner	7-16-73	7-30-73
6+55 END LINE (PLUGGED) @ FLO OF 116.07												
LAT 34, S.W.I.												
0+00	135.9	124.50	11.4	EXIST 40'-8" STUB N.								
1+00				Jap 1+44	top 1+28.6		C65630	C30465	454 Summitton	451 S. Scudder	3-30-78	2-16-72
2+00	137.0	124.95	12.1	2+24	top 2+83.4		9511315-7 (C3035)		437 B Scudder			7-24-95 2-8-72
3+00				Jap 4+96.7	top 4+01	4+10.0 top	C54021	C56007	440 S. Summitton	421 S. Scudder	2-8-72	
4+00				Jap 4+96.7	top 4+01	4+10.0 top	C54021	C56007	424 S. Summitton	421 S. Scudder	3-3-76	2-5-86
5+00	134.3	125.55	8.8	5+253	top 4+96.7	6+12.7	C30229	C68274	400 S. Summitton	401 S. Scudder	1-28-72	9-11-78
6+00												
6+55 END LINE (PLUGGED) @ FLO OF 125.81												