


CONSTRUCTION RECORD SERVICE RECORD

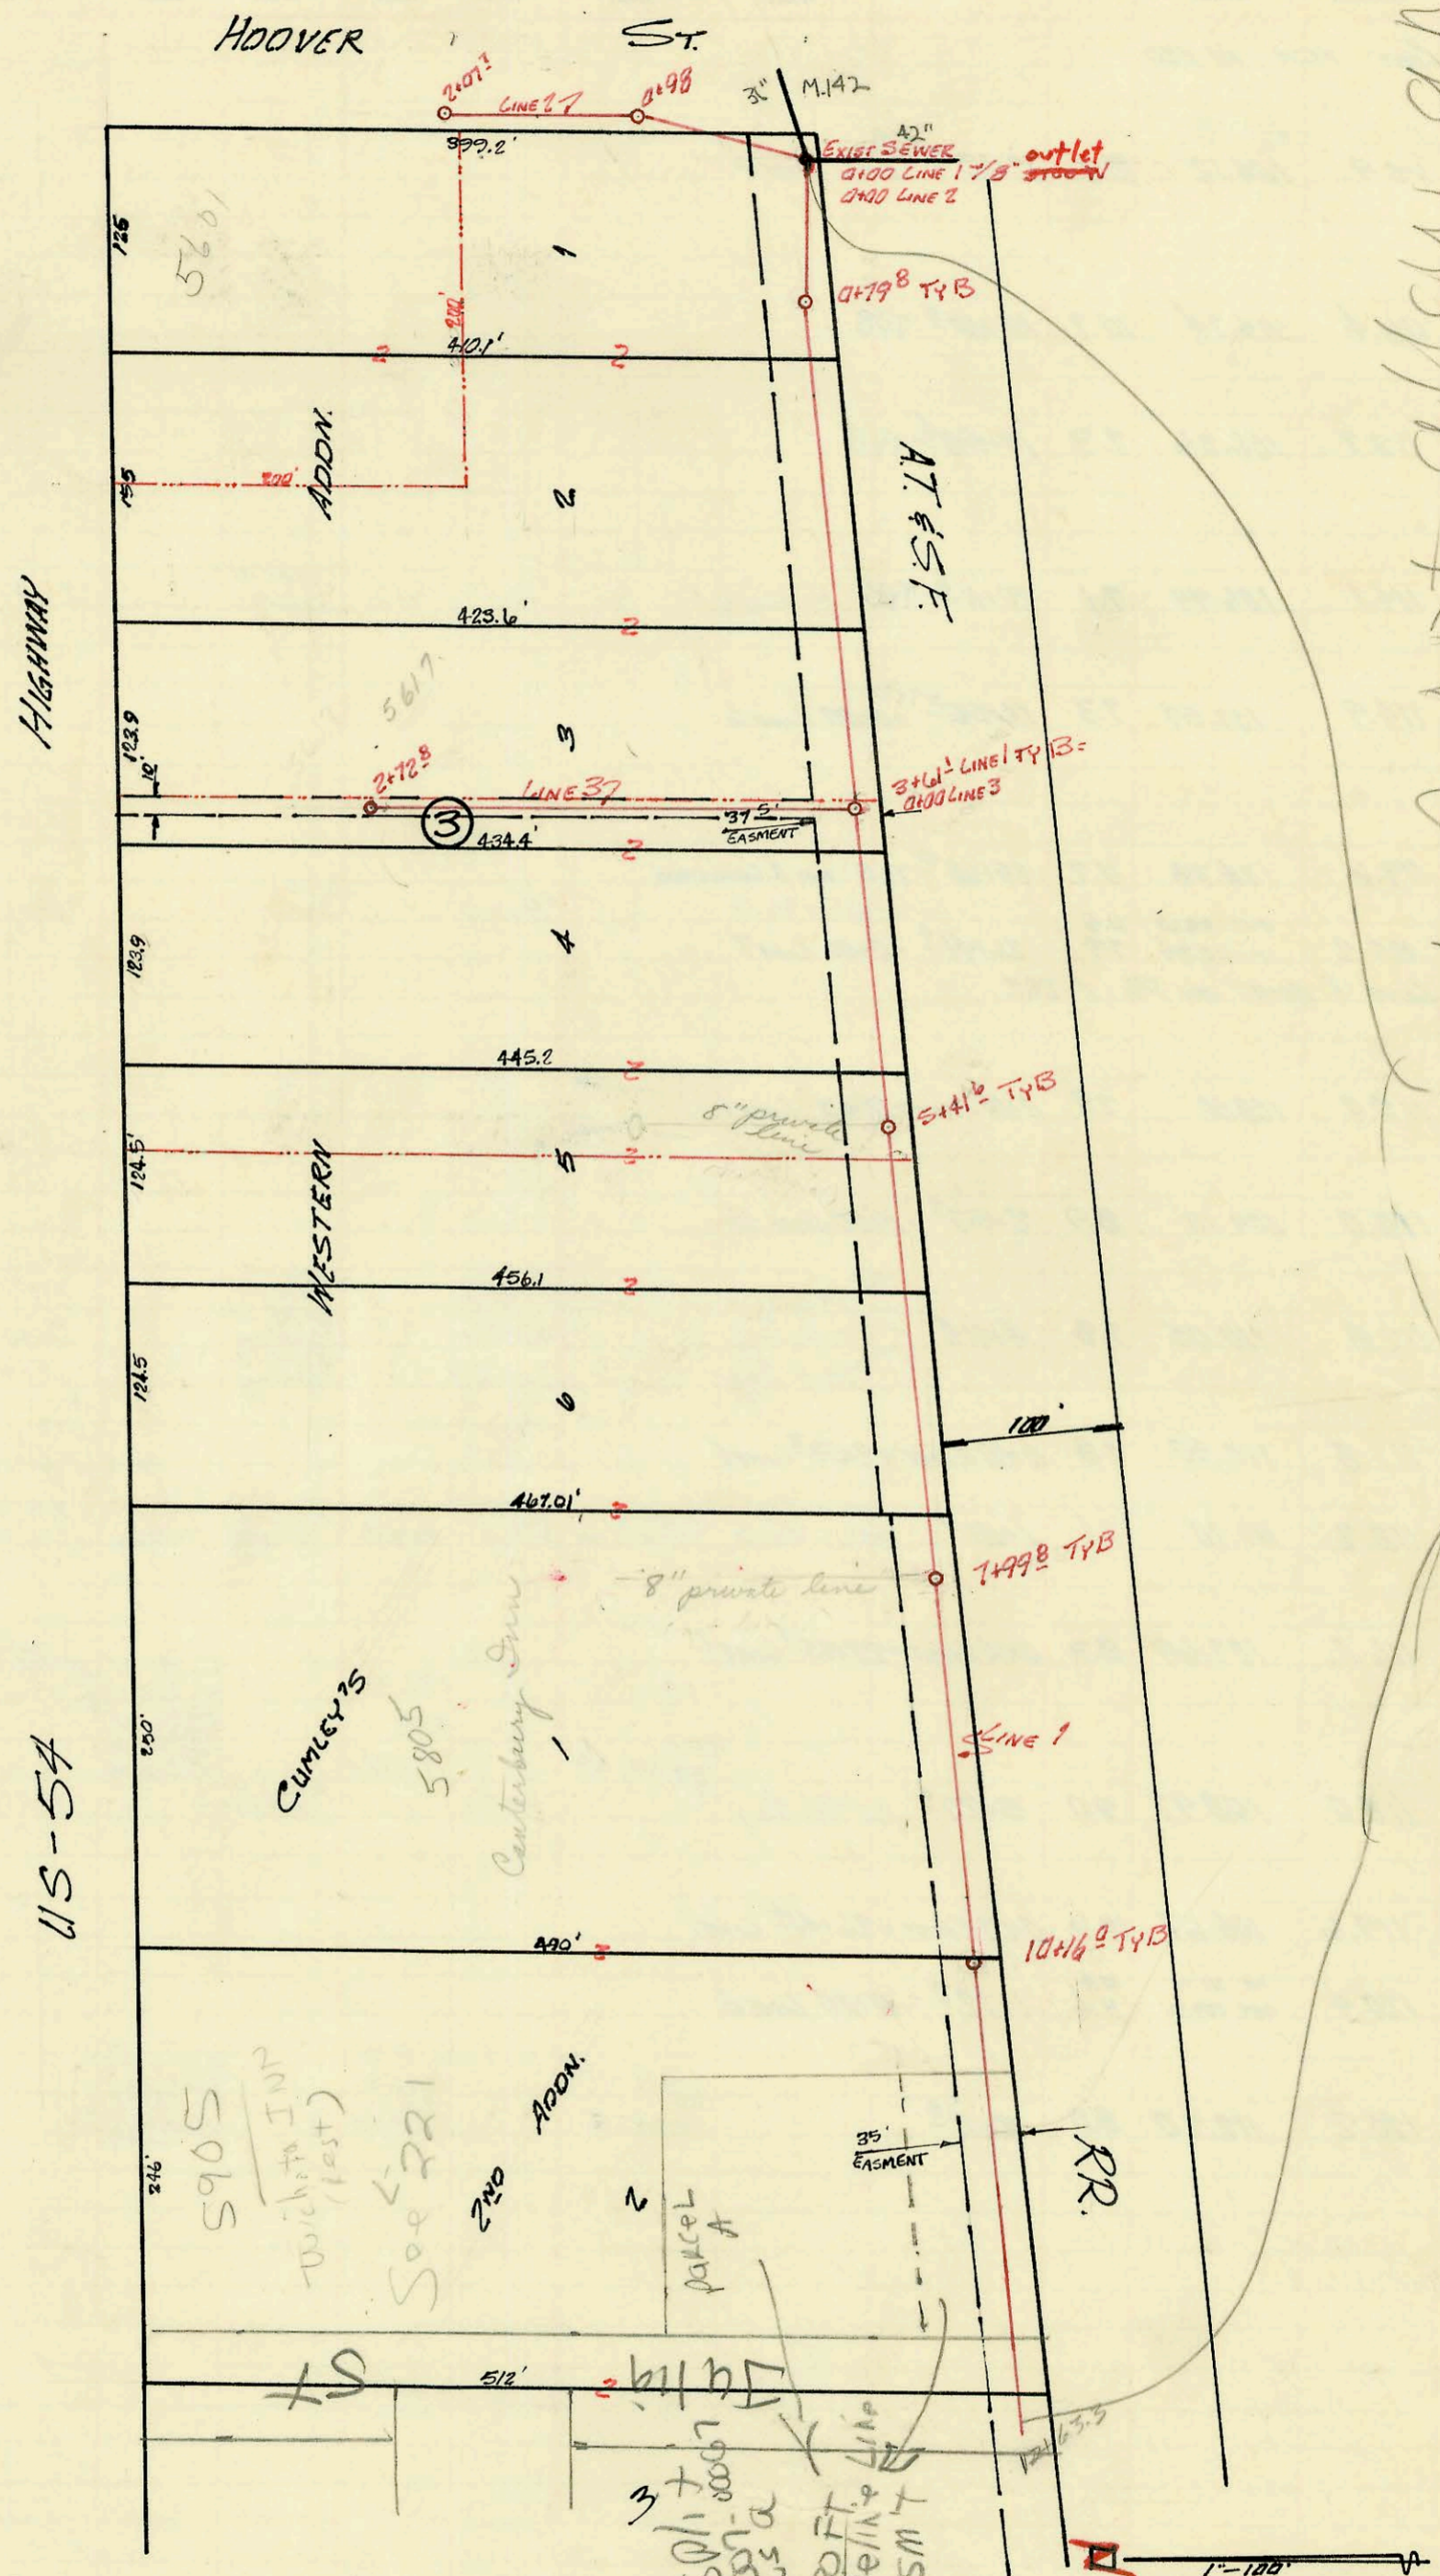

Concrete FINE lateral - do not allow any  
 Bldg TAPS - Must EXT by  
 18/18/07

HIGHWAY

US-54

HOOPER

ST.

AT&SF

WESTERN

CUMLEY'S

Centerbury Driv

RR.

Lot split  
 shows a  
 30 FT  
 private  
 pipe line  
 F.S.M.

LAT 43, S.W. I  
 BUILT BY: UTILITY CONTRACTORS INC.  
 BOOKED 15 FEB 70, FROM K-105  
 PROJ. No DBKL571031

