


Line 1 encased in concrete

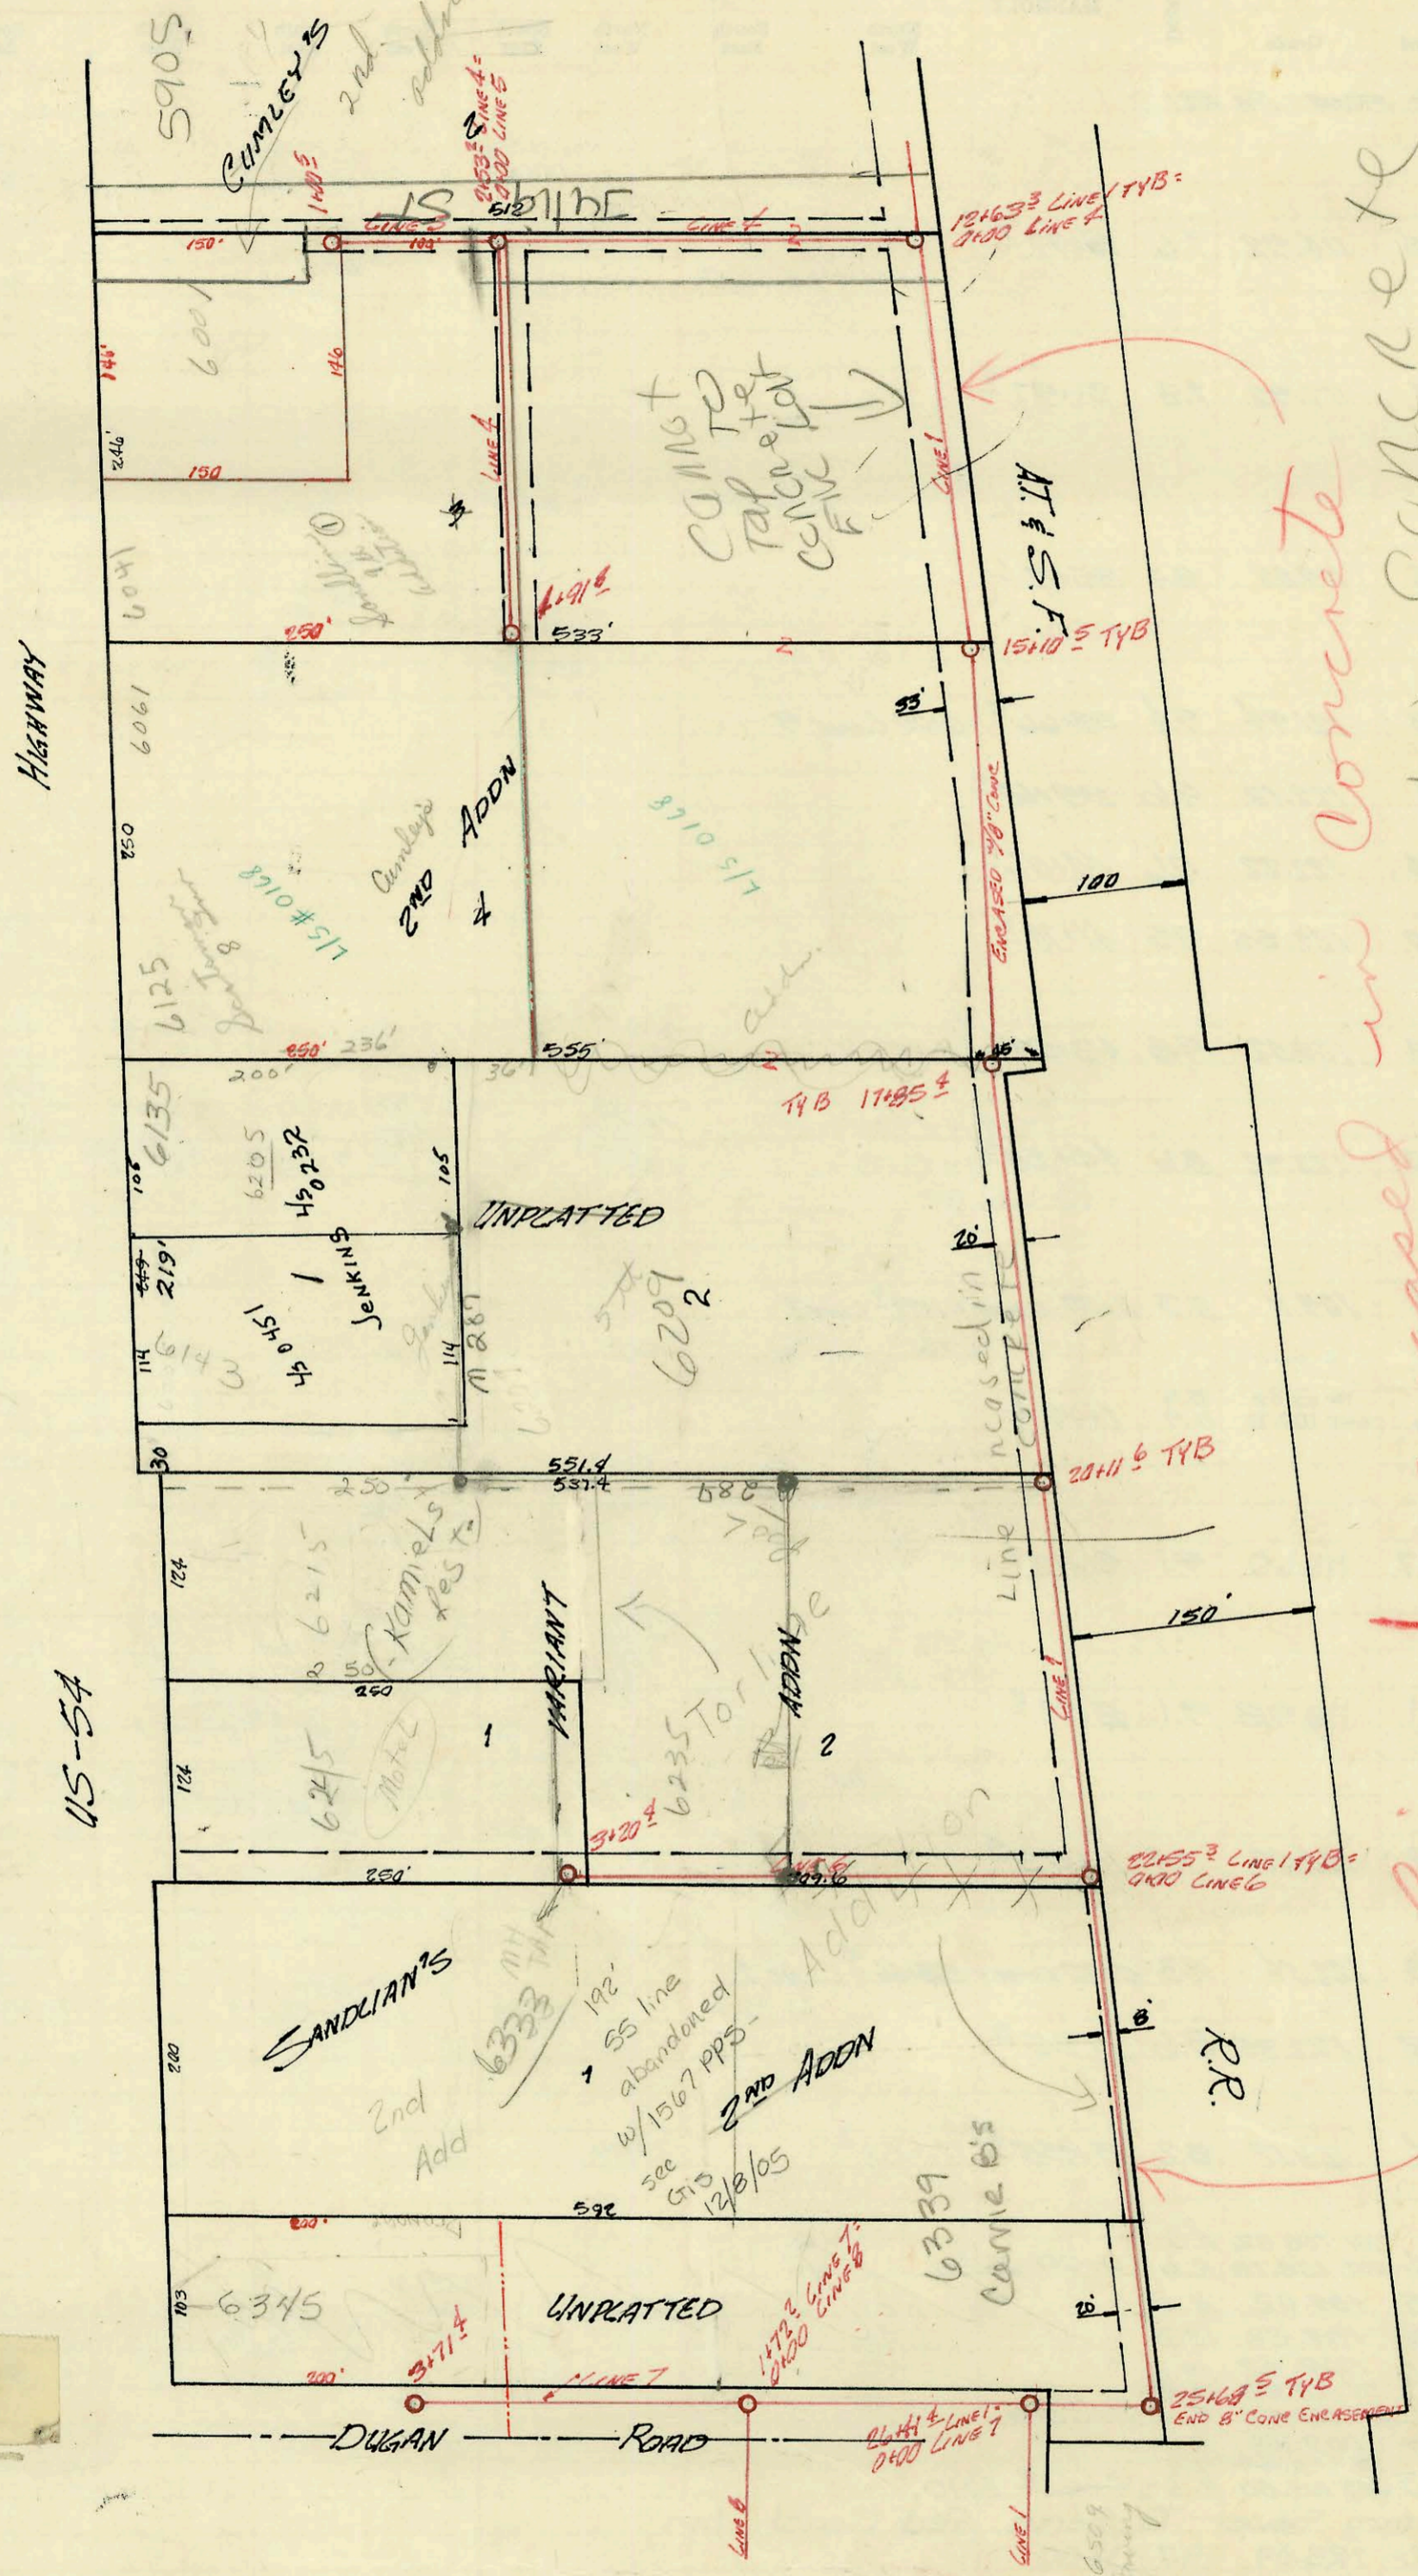

Line 1 encased in concrete  
 NO Bldg taps to concrete  
 8" Lat edge  
 ENC

HIGHWAY

US-54

1" = 100'  
 LAT 43, S.W. I  
 Proj. No DBKLS71031

CONSTRUCTION RECORD

SERVICE RECORD

STATION	ELEVATION		Depth	MANHOLE	4-INCH "Y" BRANCHES		No. of Permit		House Number		DATE OF PERMITS	
	Ground	Grade			North West	South East	North West	South East	North West	South East	North West	South East
LINE 1 CONT FROM PG 220												
12+00	115.9	105.12	10.8	12+63 <sup>3</sup> TYB								
13+00												
14+00												
15+00												
16+00	116.4	105.74	10.7	15+10 <sup>5</sup> TYB								
17+00												
18+00												
19+00												
20+00	114.1	106.99	7.1	20+11 <sup>6</sup> TYB	M.H. Jap		C41145		6209 W. Kellogg		9-10-73	
21+00												
22+00	114.9	107.59	7.3	22+55 <sup>3</sup> TYB								
23+00												
24+00												
25+00												
26+00	119.6	108.38	11.2	25+68 <sup>5</sup> TYB	AND 8' ENCASEMENT		C46793		6509 Irving		9/24/74	
27+00	120.2	OUT 108.67 IN 112.34	11.5 7.9	26+41 <sup>5</sup>	up 25+74.4 = 0+00 LINE 7							
LINE 1 CONT ON PG 6-222												
LINE 4												
0+00	119.9	108.00	7.9	0+00 EXIST = 12+63 <sup>3</sup> LINE 1								
1+00												
2+00	118.0	109.10	8.9	2+53 <sup>3</sup>								
3+00												
4+00	117.8	110.05	7.8	4+91 <sup>5</sup>	TP 4+85 M.H. Jap M.H. Jap		53469 43956 655831		6041 W. Kellogg 6125 W. Kellogg 6125 W. Kellogg		1-29-76 3-13-74 6-9-76	
LINE 5												
0+00	117.8	110.50	7.8	0+00 EXIST = 2+53 <sup>3</sup> LINE 4								
1+00	118.2	111.10	7.1	1+00 <sup>5</sup>	(SIO AT TAP) TAP 0+86.5	W ABS 40 1+32.0 TAP	9412851 17365	19015	6001 W. Kellogg 5905 W. Kellogg		8-11-94 11-25-86	9-9-87
LINE 6												
0+00	116.0	107.69	8.3	0+00 EXIST = 22+55 <sup>3</sup> LINE 1								
1+00												
2+00												
3+00	118.0	108.97	9.0	3+20 <sup>5</sup>	M.H. Jap		1466 628 C71781 C31082		6215-35 W. Kellogg 6215-35 W. Kellogg 6215-35 W. Kellogg 6333 W. Kellogg	6 M TRUNKLINE	12-1-72 6-26-80 5-16-79 3-21-72	
LINE 7												
0+00	119.6	108.67	10.6	0+00 EXIST = 26+41 <sup>5</sup> LINE 1								
1+00	120.4	IN 111.01 OUT 109.01	9.4 11.4	1+72 <sup>5</sup>								
2+00												
3+00	120.2	112.20	8.0	3+71 <sup>5</sup>			9417437 8762 8720 C71945		6345 W. Kellogg 6437 W. Kellogg		2-9-91 8-10-83 6-6-73 5-22-79	

Abandoned  
w/1567 PPS  
12/8/05

SWR 2003-02081 - 8/1/03 6335 W. Kellogg ( Wichita INN ) McCullough EX;

# 1815 1-21-92 6235 W. Kellogg - Jack Brannon - (4" PVC 40 Repl section of Line at point 18' from bldg to point 50' from main. way or approx 61' 54" mt)