


LAT 10, SM 1, WESTLINK
BUILT BY UTILITIES CONTRACTORS INC.
EJECTED 3 APRIL 1970 FROM K-101
PRO. NO. DBKL 568079

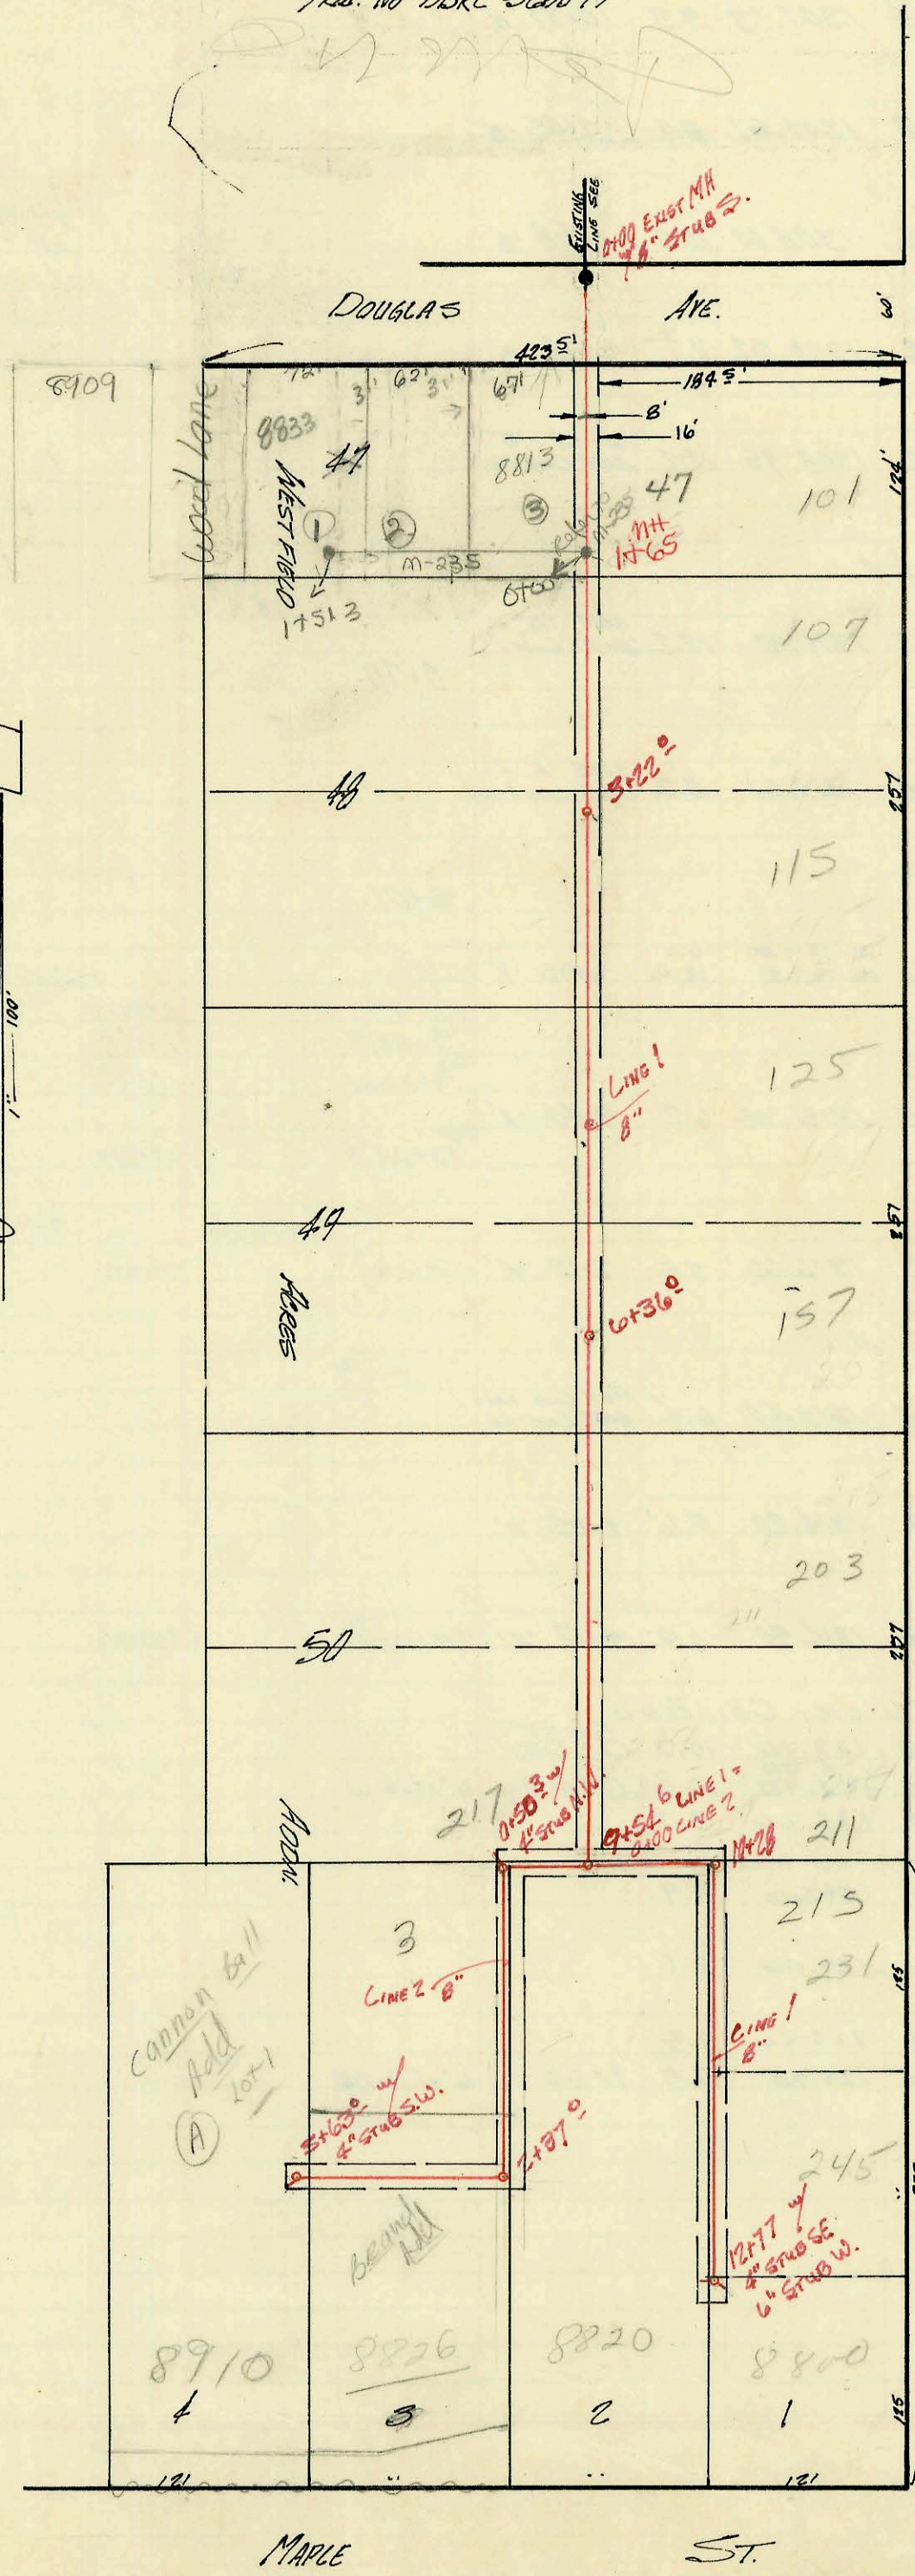

CONSTRUCTION RECORD

SERVICE RECORD

STATION	ELEVATION		Depth	MANHOLE	4-INCH "Y" BRANCHES		No. of Permit		House Number		DATE OF PERMITS	
	Ground	Grade			North West	South East	North West	South East	North West	South East	North West	South East
LAT 10, Sub 1, WESTLINK												
LINE 1												
0+00	142.0	134.01	8.0	0+00 EXIST MH 1/8" STUB S.	10+81°							
1+00				Top 1+13.8			20424 C 30852		101 S. R Tyler Rd		4-12-88 3-7-72	
2+00					Top 2+12.4		044814	8813 W. Langford		5/9/74		
3+00							C 31054	107 S Tyler Rd			3-20-72	
4+00	145.0	135.29	9.7	3+22°								
5+00					Top 3+70.0		C 35032	115 S. Tyler Rd			9-25-72	
6+00					Top 5+17.4		18278 C 37771	125 S. E Tyler			5-6-87 3-20-72	
7+00	146.2	136.55	9.7	6+36°				157 S. Tyler Rd			4-16-70	
8+00					6+45.0 TAP		25138	203 S. Tyler Rd			3-30-72	
9+00					Top 7+53.6		C 31270	315 S. Tyler Rd			3-30-72	
					Top 8+97.6		C 31271					
10+00	144.6	137.81	6.8	9+54.6 = 0+00 Line 2								
11+00	144.5	138.23	6.3	10+28				231 S. Tyler Rd			3-30-72	
12+00					Top 10+52.8		C 31273	245 S. Tyler Rd			3-30-72	
					Top 11+64.4		C 31274					
					Top 12+77.6		C 32536	8820 Maple		5/30/72		
	146.1	139.36	6.7	12+77 4" stub SE 6" stub W	4" stub SE		20394 8355	2800 W B Maple			4-4-88 6-13-83	
LINE 2												
0+00	144.6	137.91	6.7	0+00 = 9+54.6 Line 1								
1+00	144.7	138.11	6.6	0+50 = 4" stub NW			C 31272	217 S. Tyler			3/30/72	
2+00	145.1	138.95	6.2	2+37								
3+00	145.0	139.56	5.4	3+63° 4" stub SW.			19795 C 65833	8915 W. Maple			12-3-87 4-11-78	

275757 NC 211 S. Tyler for Langas (9+54.6 N. 201.0 1-7-80) (144' top 9+54.6)