
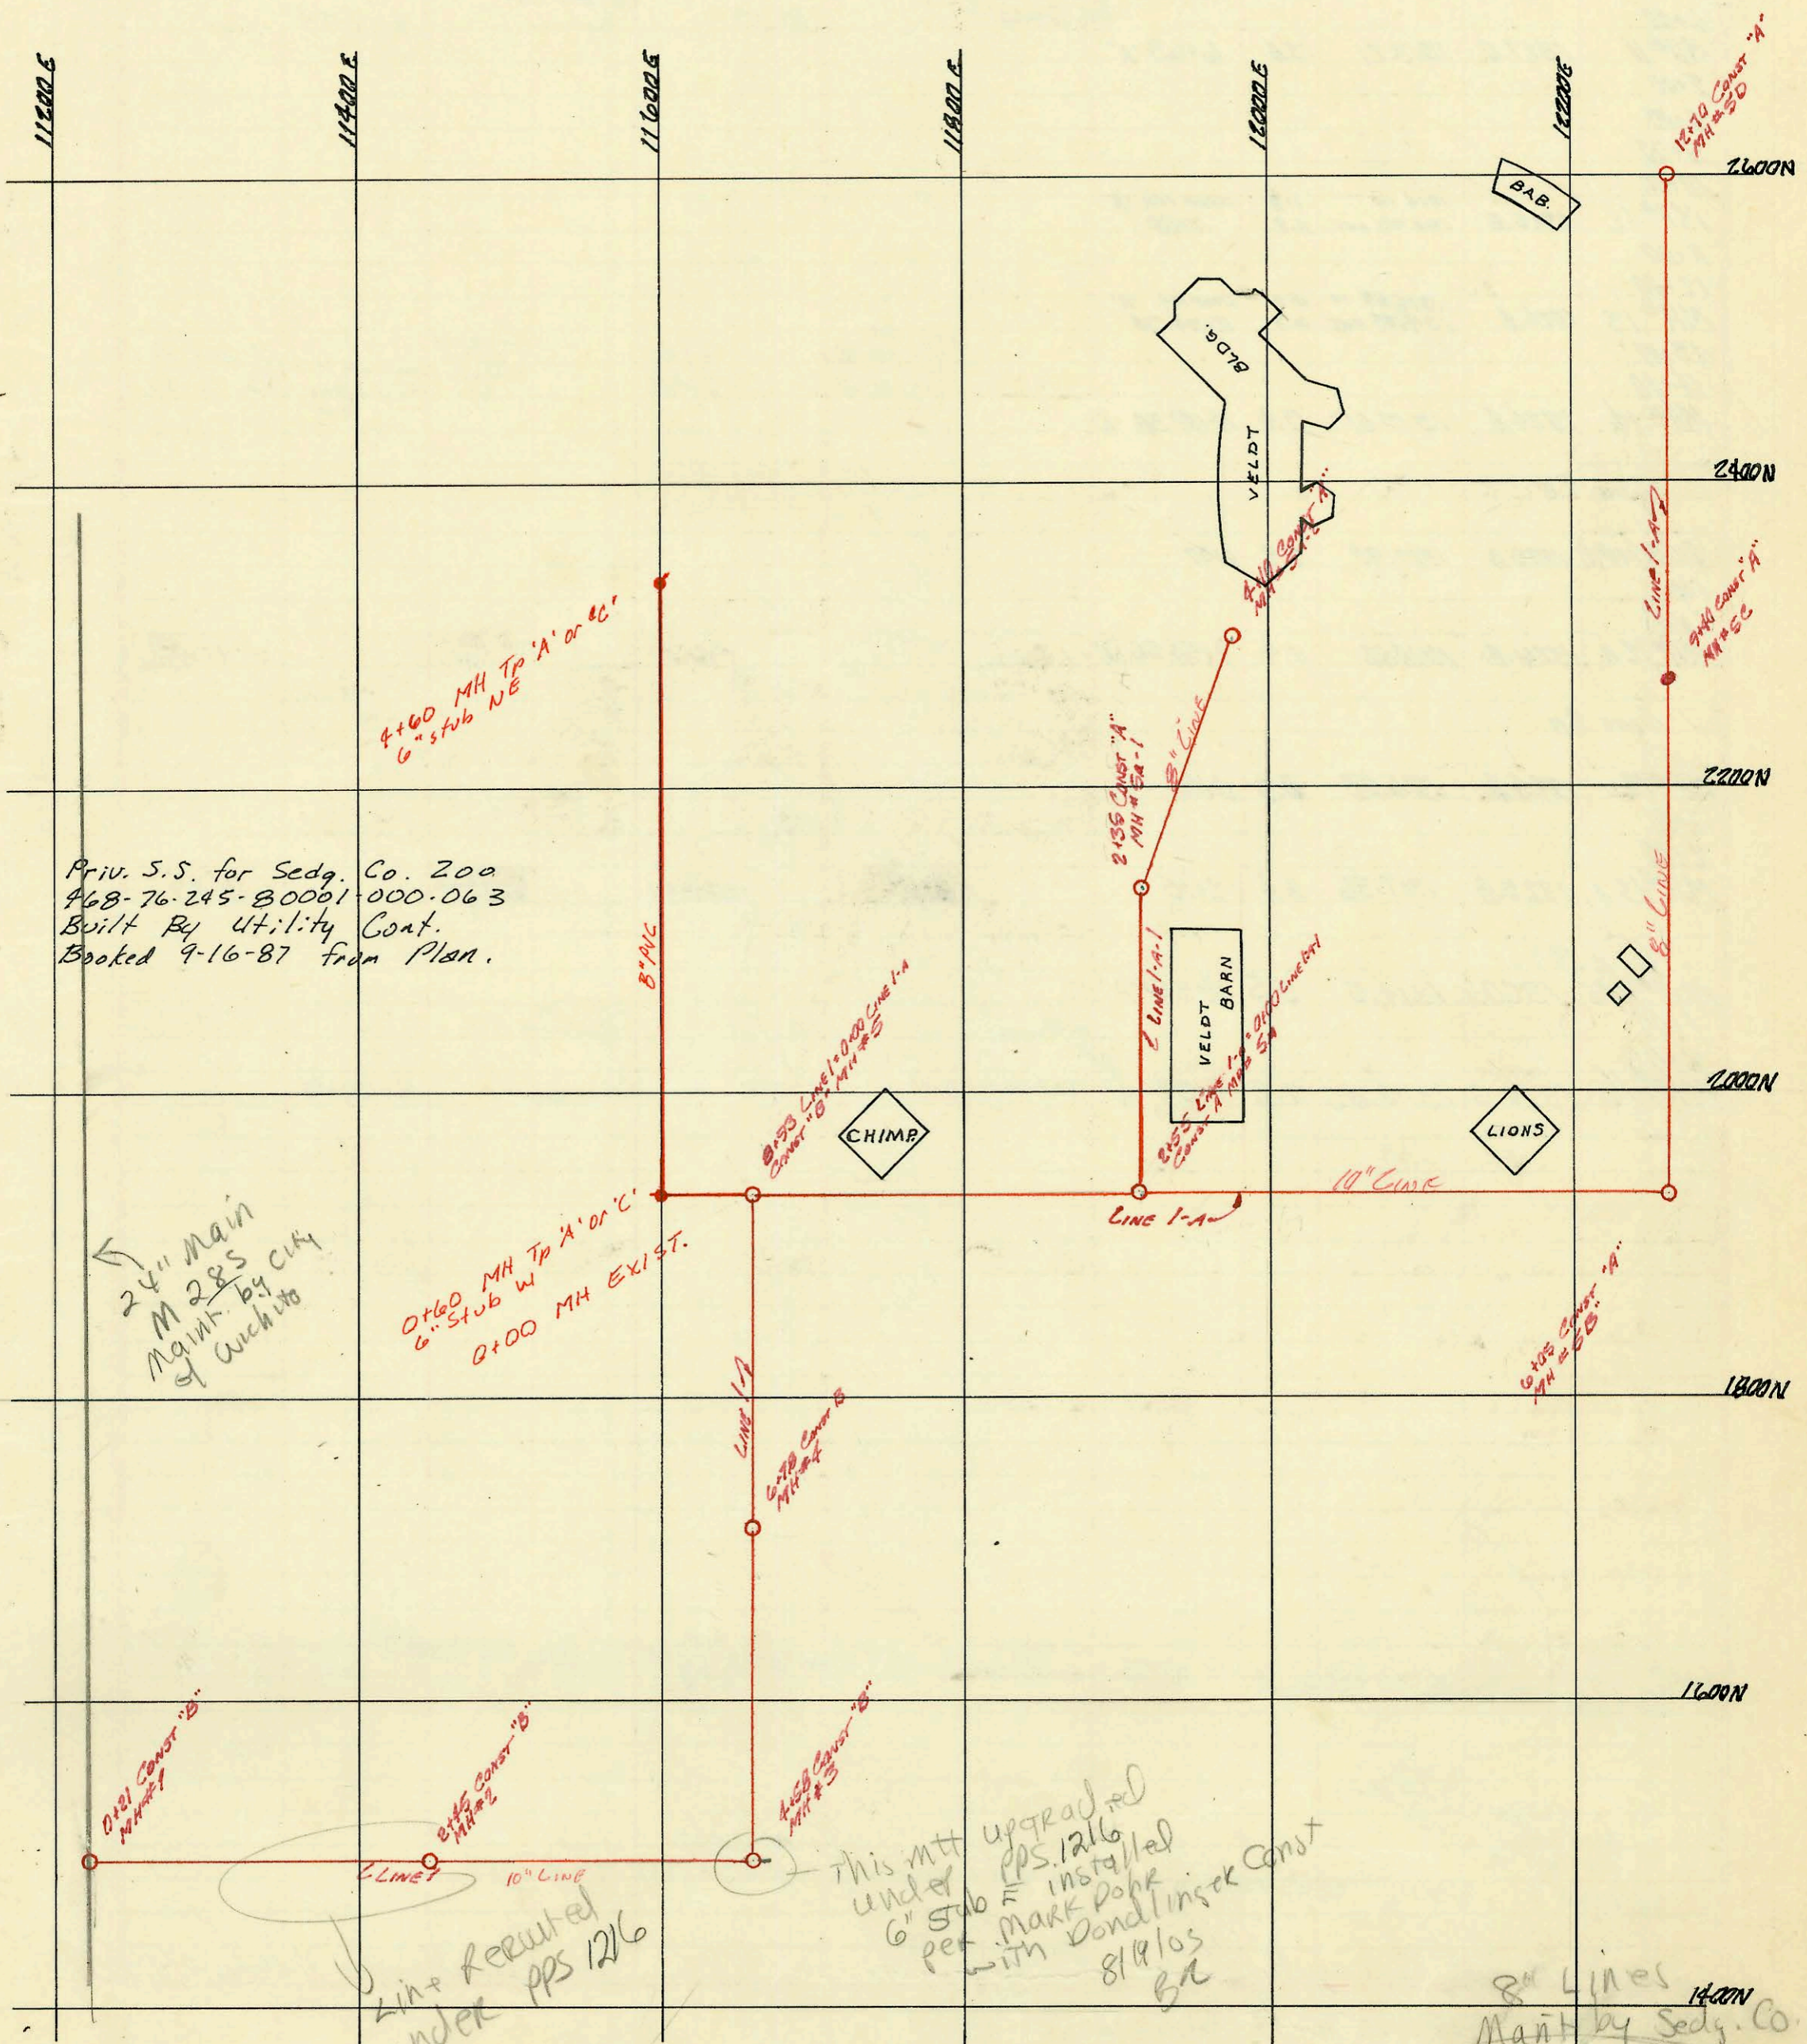


SCALE: 1"=100'

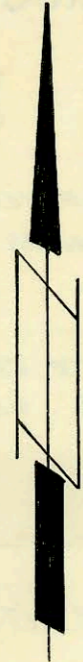

Priv. S.S. for Sedg. Co. Zoo  
468-76-245-80001-000-063  
Built By Utility Cont.  
Booked 9-16-87 from Plan.

24" Main  
M 285  
Maint. by City  
of Wichita

This mtt upgraded  
under PPS 1216  
6" stub F installed  
per MARK POHR  
with Donald Insur Const  
8/19/05  
BR

24" + Reputed  
under PPS 1216

8" Lines  
Maint by Sedg. Co.

ZOO SEWER PRIVATE LINES  
BUILT BY: UTILITY CONTRACTORS INC.  
BOOKED 27 MARCH 72 FROM PLAN

