


LAT 1, MAIN 1, COWSKIN INT. SEWER
468-81880 (606087)
Built By Utility Contr.
Booked 5-30-89 from LPC.S.III



Scale 1" = 150'

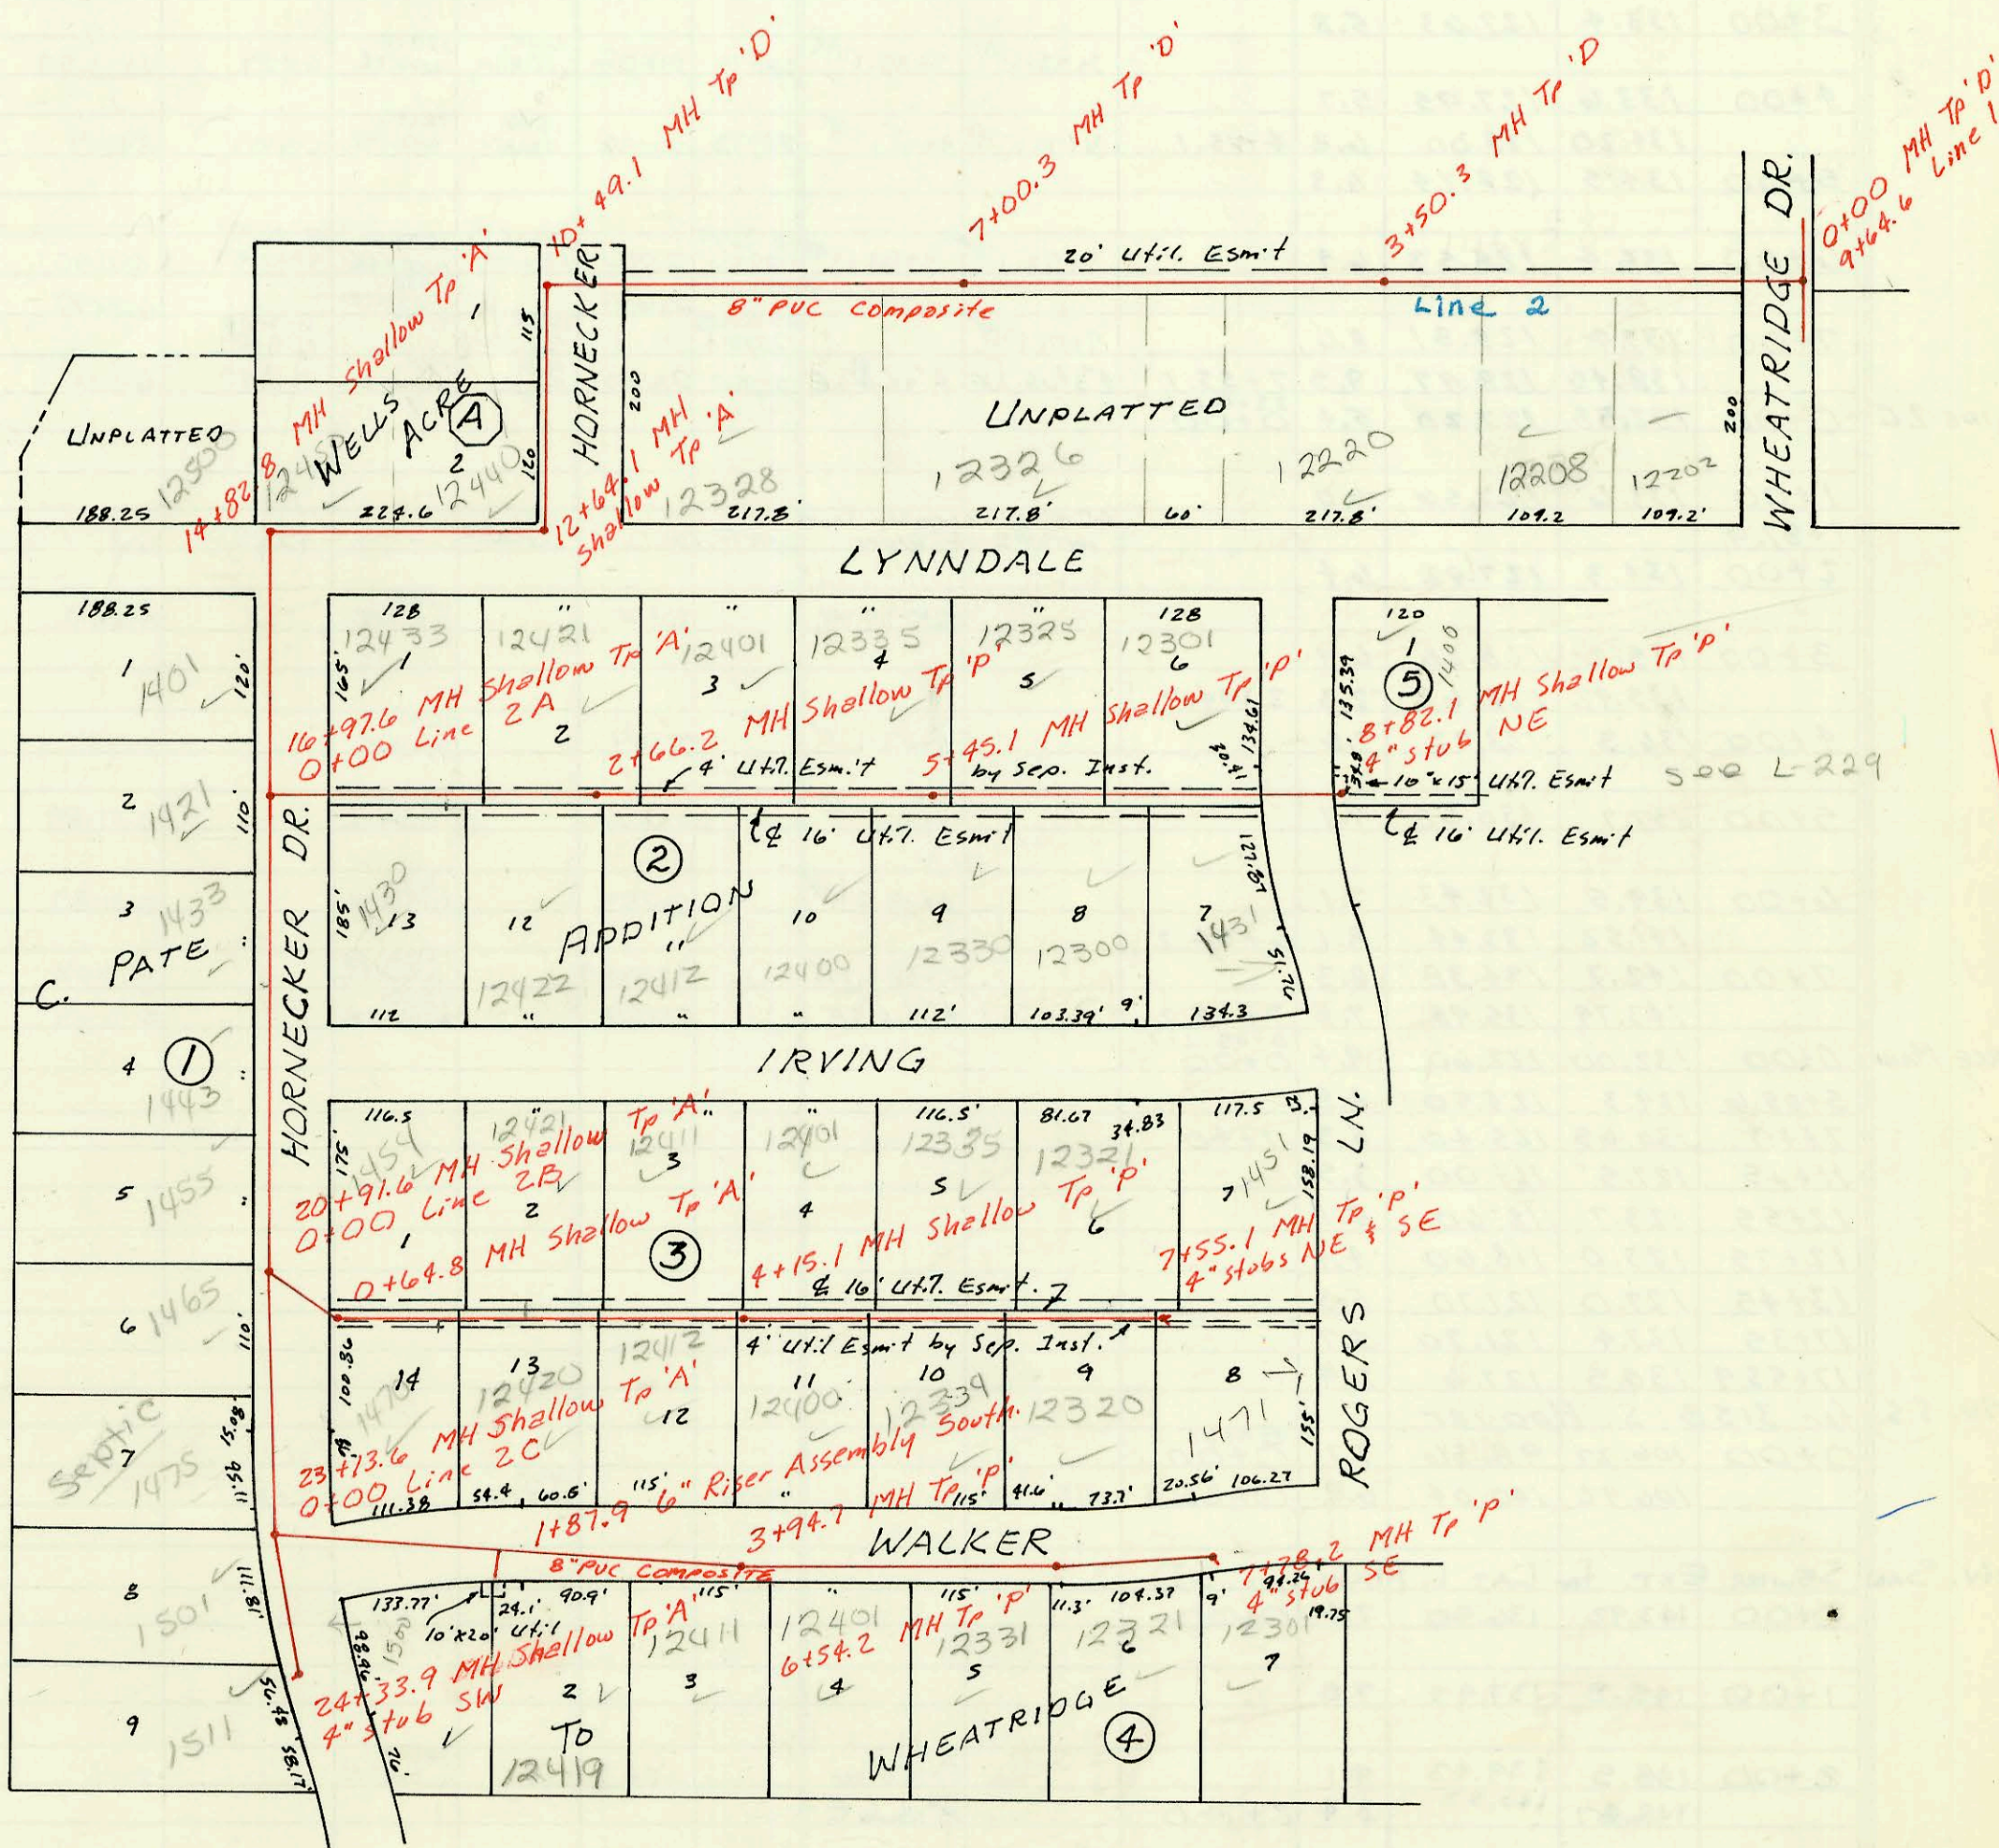

CONSTRUCTION RECORD						SERVICE RECORD						
STATION	ELEVATION		Depth	MANHOLE	4-INCH "Y" BRANCHES		No. of Permit		House Number		DATE OF PERMITS	
	Ground	Grade			North West	South East	North West	South East	North West	South East	North West	South East
LAT 1, Main 1, CSI (cont.)												
3+00	135.9	128.45	7.5									
4+00	137.6	129.55	8.1		4+02.2 TAP	3+99.2 TAP	25360	25755	12025 Lyndale	1401 S. 119th W.	4-15-91	7-16-90
						4+44.2 TAP		26800		1403 S. 119th W.		12-26-90
5+00	139.2	130.64	8.6									
	139.64	130.90	8.7	5+23.2								
6+00	140.2	132.57	7.6		6+05.2 TAP		25496		1424 Wheatridge		6-11-90	
					6+80.2 TAP	6+60.8 TAP	26436	28951	1436 Wheatridge	1405 S. 119th	10-30-90	4-24-89
7+00	143.3	134.75	8.6									
8+00	145.7	136.93	8.8		8+13.2 TAP	8+12.7 TAP	25546	25420	1448 Wheatridge	1451 119th	6-12-90	5-29-90
	146.55	139.91 IN	8.3	8+61.7	8+85.7 TAP		25548		1460 Wheatridge		6-14-90	
9+00	147.8	140.46	7.3									
10+00	150.5	141.89	8.6		4" SOR 55 10+14.8 RP 1" TUC 90 4" stub SW	10+16.3 TAP	2220877	25419	1470 S. 119th W. Wheatridge	1502 S. 119th W.	8-12-92	5-29-90
	150.72	142.24	8.5	10+24.8			1437		1480 Wheatridge		11-5-91	
0+00	132.86	120.04	12.8	0+00								
								26906		12202 Lyndale		1-22-91
1+00	133.0	120.34	12.7									
2+00	132.9	120.63	12.3									
3+00	132.0	120.93	11.1			3+00.3 TAP		25661		12200 Lyndale		6-29-90
	131.60	121.08	10.5	3+50.3								
4+00	130.9	121.22	9.7									
5+00	130.1	121.51	8.6									
6+00	129.7	121.79	7.9									
7+00												
	130.90	122.08	8.8	7+00.3								
8+00	129.8	122.37	7.4									
9+00	129.7	122.66	7.0									
10+00	130.0	122.95	7.1									
	130.65	123.09 OUT 123.13 IN	7.6	10+49.1								
11+00	130.4	123.27	7.1									
12+00	130.5	123.55	7.0									
	130.09	123.73 OUT 123.95 IN	6.4	12+64.1								
13+00	129.7	124.06	5.6									
14+00	131.3	124.38	6.9									
	130.55	124.65	5.9	14+82.8	4" SOR 25 14+94.8 TAP				12509 Lyndale		1-6-92	
15+00	131.4	124.70	6.7									
16+00	131.3	124.98	6.3									
	132.33	125.26	7.1	0+00 L-2A 16+97.6	16+13.6 TAP		25587		1401 Hornocker		6-11-90	
17+00					17+39.6		25449		1421 Hornocker		6-1-90	
18+00	133.0	125.59	7.4									
19+00	132.5	125.92	6.6		18+63.6 TAP		23564		1433 S. Hornocker		7-19-89	
					18+98.7 TAP		25607		1443 Hornocker		6-25-90	
20+00	132.0	126.24	5.8									
	132.28	126.54	5.7	0+00 L-2B 20+91.6	20+97.6 TAP		25577		1455 Hornocker		6-18-90	
21+00	132.5	126.56	5.9									
22+00	132.4	126.86	5.5									
23+00	132.2	127.16	5.0									
	132.58	127.20	5.4	0+00 L-2C 23+13.6					1445 Hornocker		12-17-96	
24+00	132.5	127.54	5.0									
	133.49	127.68	5.8	24+33.9 16+97.6 L-2 0+00	24+18.9 TAP 4" stub SW		23403 25757		1501 Hornocker 1511 Hornocker		5-24-90 7-18-90	
0+00	132.33	125.43	6.9									
1+00	132.4	125.74	6.7		1+20.0 TAP	1+33.0 TAP	23245	23259	12433 Lyndale	1450 Hornocker	5/20/89	6-16-89

Line 1D (cont)

Line 2

Line 2A

9227664-7 9/17/92 1470 S. Wheatridge - Mrs. Cony -
 1999-00562 9-1-99 12328 W. Lyndale (Permit to tie Bathrun in Garage into house sewer line)