

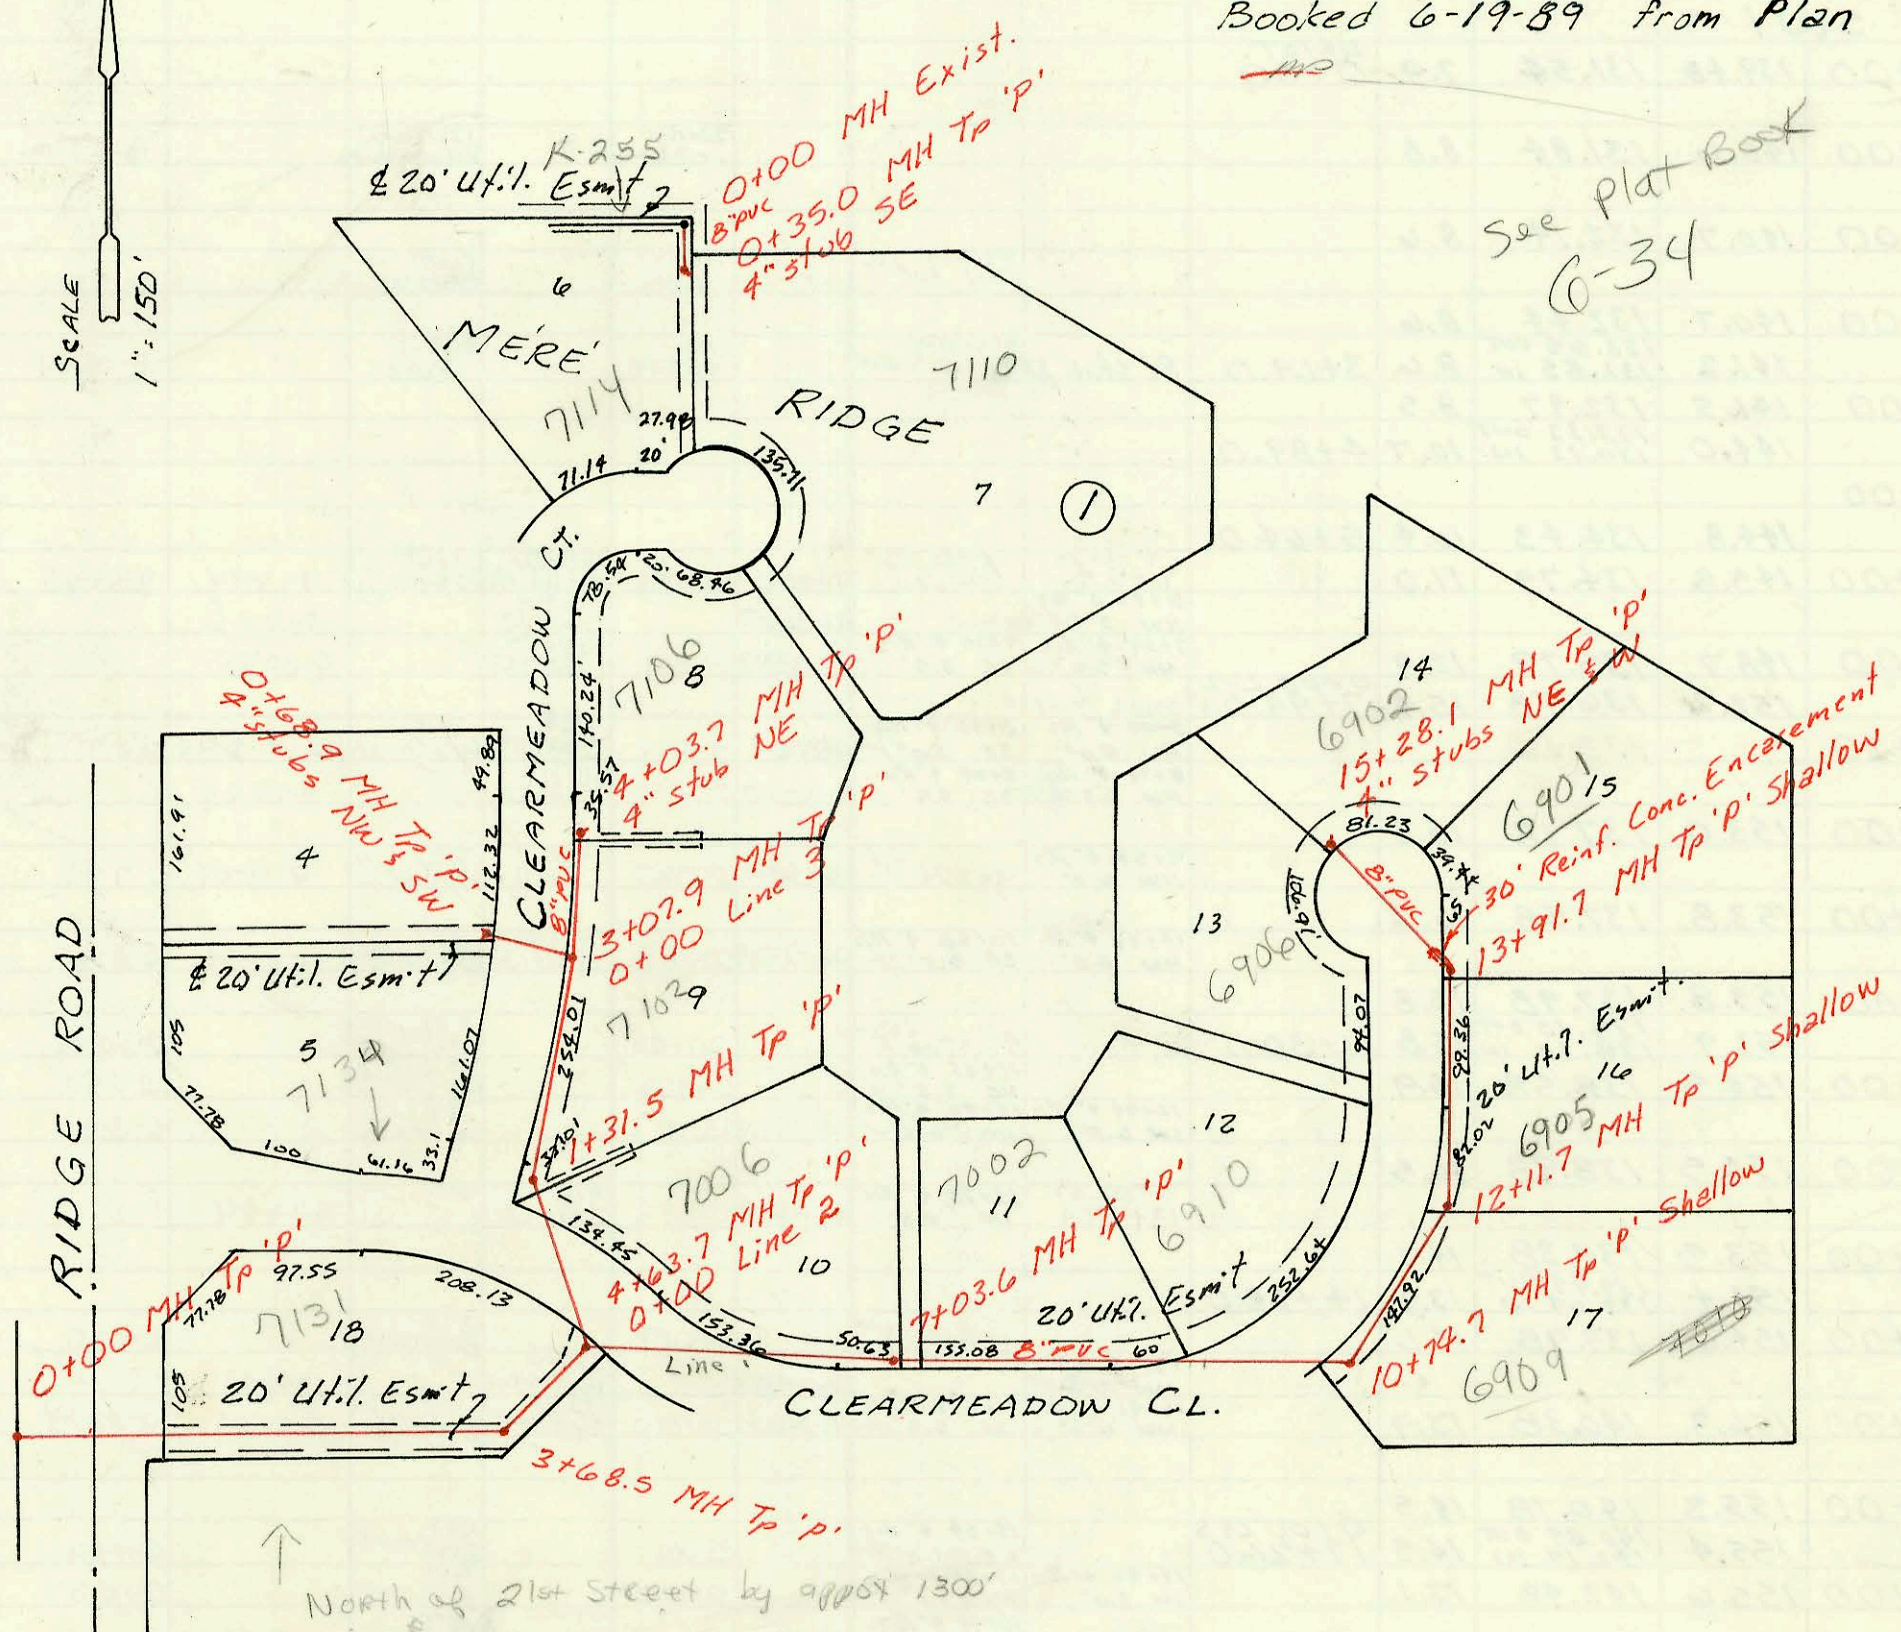



LAT 11, MAIN 15, SWI  
46B-81906 (607358)  
Built By Nowak Const.  
Booked 6-19-89 from Plan

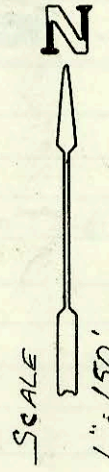

See Plat Book  
6-34

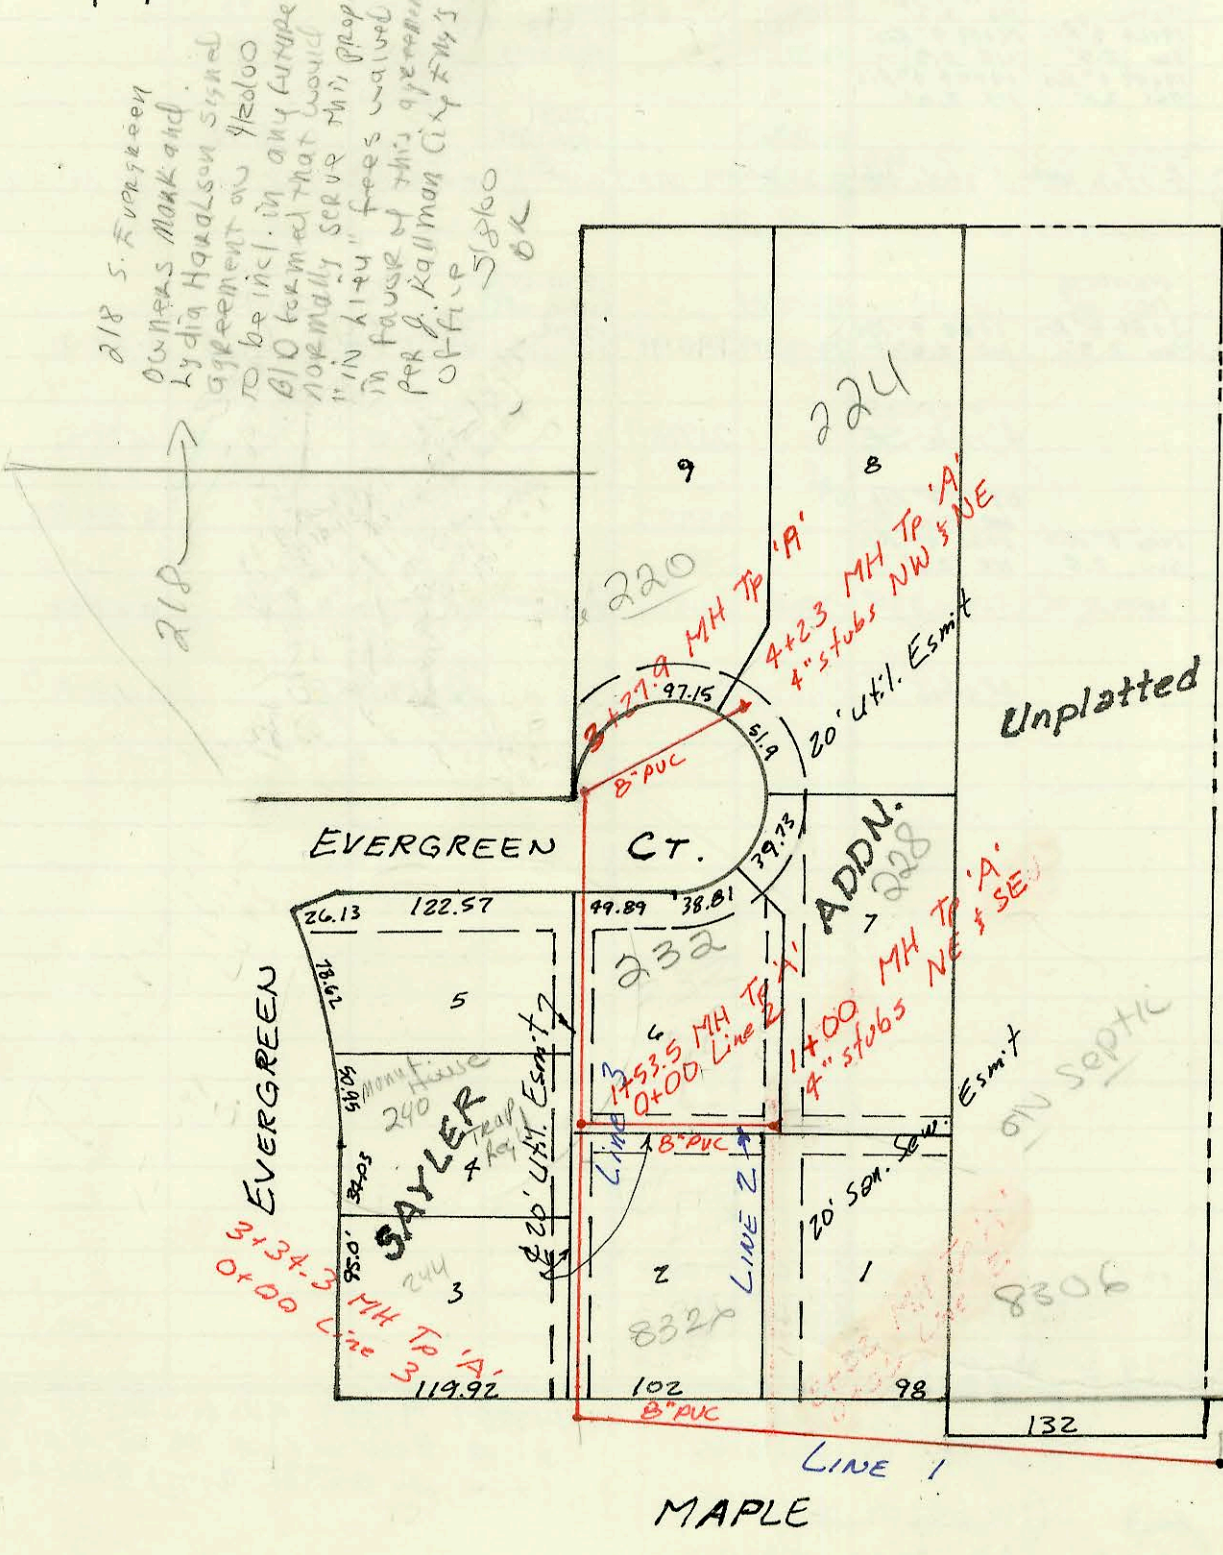

LAT 45, MAIN 4, SWI  
46B-81883 (607713)  
Built By Stannard Const.  
Booked 7-28-89 from Plan

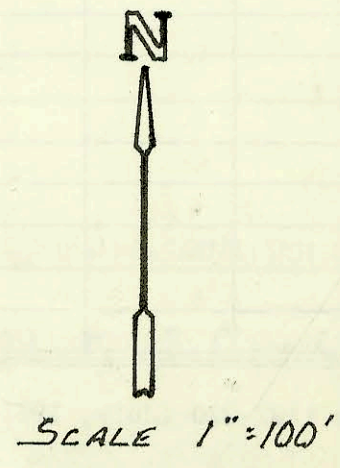

CONSTRUCTION RECORD							SERVICE RECORD					
STATION	ELEVATION		Depth	MANHOLE	4-INCH "Y" BRANCHES		No. of Permit		House Number		DATE OF PERMITS	
	Ground	Grade			North West	South East	North West	South East	North West	South East	North West	South East
LAT 11, Line 1												
MAIN	15, SW I											
0+00	139.8	129.16	10.6	0+00								
1+00	139.7	129.46	10.2									
2+00	139.8	129.76	10.0									
3+00	140.5	130.06	10.4									
	140.6	130.27	10.3	3+68.5								
4+00	139.7	130.36	9.3									
	140.0	130.55 OUT	9.5	0+00 L-2								
		130.43 IN		4+63.7								
5+00	139.1	130.76	8.3									
6+00	139.5	131.06	8.4									
7+00												
	139.4	131.37	8.0	7+03.6								
8+00	138.9	131.66	7.2									
9+00	138.5	131.96	6.5									
10+00	137.5	132.26	5.2									
	138.3	132.48 OUT	5.8	10+74.7								
		132.58 IN										
11+00	138.1	132.66	5.4									
12+00	137.8	132.96	4.8									
	137.9	133.00	4.9	12+11.7								
13+00	137.5	133.26	4.2									
	138.7	133.54	5.2	13+91.7								
14+00	138.5	133.56	4.9									
15+00	139.5	133.86	5.6									
	141.0	133.94	7.1	15+28.1	4" stub W	4" stub NE	99-6507	24957	6906 Clear Meadow	6902 Clear Meadow	4-5-94	9-19-90
0+00	140.2	130.65	9.6	0+00								
1+00	140.2	130.95	9.3									
	140.9	131.24	9.9	1+31.5								
2+00	141.0	131.25	9.8									
3+00												
	141.4	131.57	9.8	0+00 L-3								
				3+07.9								
4+00												
	141.8	131.86	9.9	4+03.7								
0+00	141.4	131.67	9.7	3+07.9 L-2								
				0+00								
	141.5	131.88	9.6	0+68.9	4" stub NW	4" stub SW						
0+00	139.42	132.21	7.2	EXIST								
				0+00								
	139.4	132.32	7.1	0+35.0								
LAT 95, Line 1												
MAIN	4, SW I											
0+00	142.25	133.38	8.9	EXIST								
				0+00								
1+00	141.0	133.78	7.2									
2+00	141.6	134.18	7.4									
	142.2	134.31 OUT	7.9	0+00 L-2								
		134.11 IN		2+38								
3+00	142.2	134.68	7.5									
	142.2	134.82 OUT	7.4	3+34.3								
		134.92 IN		1+52.5 L-3								
0+00	142.6	135.63	7.0	0+00								
1+00	142.3	136.01	6.5	1+00								
0+00	142.2	134.92	7.3	3+34.3 L-1								
				0+00								
1+00	142.3	135.32	7.0									
	142.6	135.53	7.1	1+53.5								
2+00	142.4	135.72	6.7									
3+00	142.5	136.12	6.4									
	142.8	136.23 OUT	6.6	3+27.9								
		136.33 IN										
4+00	142.5	136.62	5.9									
	143.3	136.71	6.6	4+23								

LAT 11, Line 1

Line 2

Line 3

Line 4

LAT 95, Line 1

Line 2

Line 3

Form #192-020 (July, 1981)  
 95-6940-7 5-15-95 7106 w Clear Meadow or (Pool House - 4" sdr35 tied into exist house sewer)