


LAT 246, SW I  
468-81707 (607440)  
Built By MID-STATES  
Booked 6-21-89 from Plan.

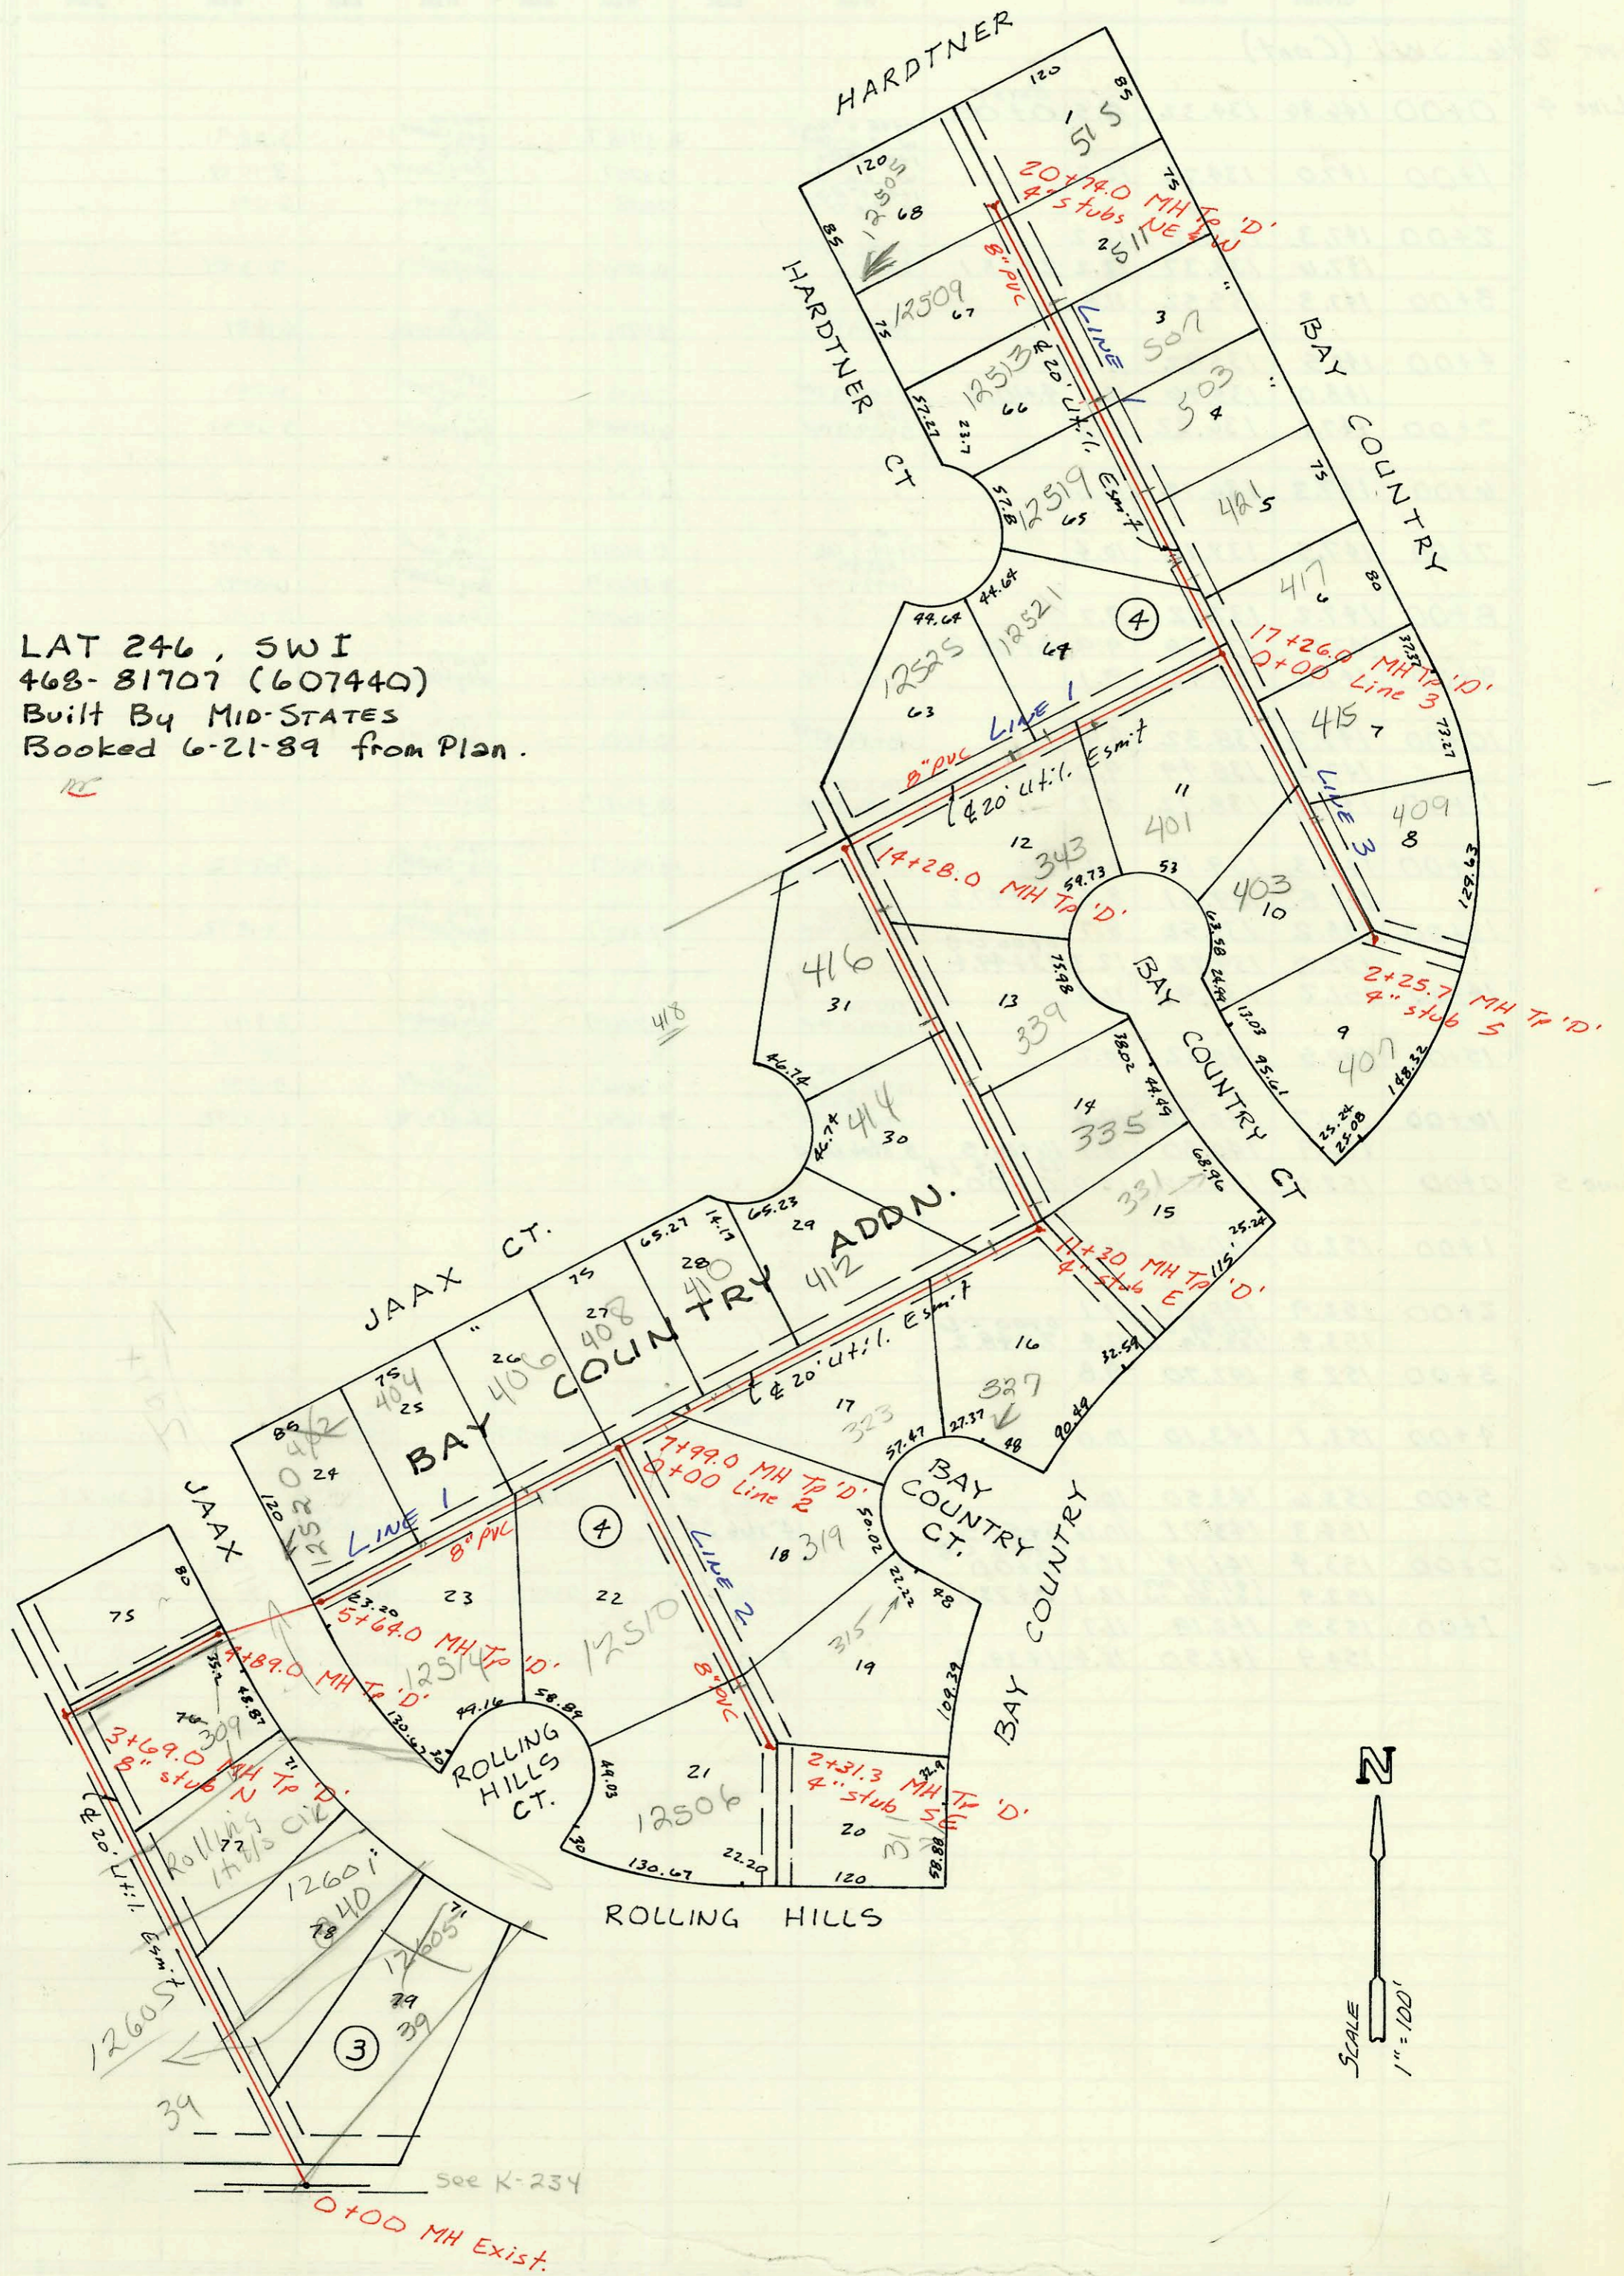

CONSTRUCTION RECORD						SERVICE RECORD						
STATION	ELEVATION		Depth	MANHOLE	4-INCH "Y" BRANCHES		No. of Permit		House Number		DATE OF PERMITS	
	Ground	Grade			North West	South East	North West	South East	North West	South East	North West	South East
LAT 2 LINE 1 0+00	139.48	131.54	7.9	EXIST. 0+00								
1+00	140.6	131.84	8.8				2001- 02641		12605 W Rolling Hills		10-22-01	
2+00	140.7	132.14	8.6						12601 W Rolling Hills Ct		6-4-01	
3+00	140.7	132.44	8.6									
	141.2	132.85 IN	8.6	3+69.0	8" stub N	4" SDR 35 1+14 Saddle	2001- 01351		309 N JACK		3-14-01	
4+00	141.5	132.97	8.5									
	144.0	132.33 OUT 134.13 IN	10.7	4+89.0								
5+00	144.8	134.43	10.4	5+64.0								
6+00	145.8	134.79	11.0									
7+00	148.7	135.79	12.9									
	152.2	136.78	15.4	0+00 L-2 7+99.0								
8+00												
9+00	153.0	137.18	15.8									
10+00	153.8	137.58	16.2									
11+00	153.8	137.98	15.8									
	153.9	138.10 OUT 138.30 IN	15.8	11+30.0								
12+00	154.5	138.58	15.9									
13+00	155.5	138.98	16.5									
14+00	153.5	139.38	14.1									
	153.4	139.49 OUT 139.69 IN	13.9	14+28.0								
15+00	154.6	139.98	14.6									
16+00	156.3	140.38	15.9									
17+00	155.3	140.78	14.5									
	155.4	140.89 OUT 142.19 IN	14.5	0+00 L-3 17+26.0								
18+00	155.6	142.48	13.1									
19+00	155.8	142.88	12.9									
20+00	156.2	143.28	12.9									
	155.8	143.58	12.2	20+74.0	4" stub NE	4" stub SW						
LINE 2 0+00	152.2	139.98	12.2	0+00								
1+00	152.9	140.38	12.5									
2+00	153.1	140.78	12.3									
	153.1	140.91	12.2	2+31.3	4" stub SE							
LINE 3 0+00	155.4	141.09	14.3	0+00								
1+00	154.0	141.49	12.5									
2+00	153.0	141.89	11.1									
	153.1	141.99	11.1	2+25.7	4" stub S							
95-10812-7	7-14-95	12506 W Rolling Hills Ct	(No Riser Found. Tap made at STA 11+84.0 4" SDR 35)									
96-36007	3-14-96	404 N JACK CT	(TAP 6+177.0 4" SDR 35)									

Form #192-020 (July, 1981)

# 91-25215-7 6/21/91 503 N Bay County - Sam Bangle - Tap - Sta. 13+66  
 # 92-4247-7 3/26/92 511 N Bay County - Bangle - (Tap 20+04 4" SDR 35)  
 # 92-39139-7 12/17/91 507 W Bay County - Bangle - (Tap 19+50 4" SDR 35)

94-14725-7 9-13-94 410 N JACK CT - Conn 10  
 Riser. Meas on Riser 76' NE of 117199  
 (Riser sta should be 8+75) 4" SDR 35