

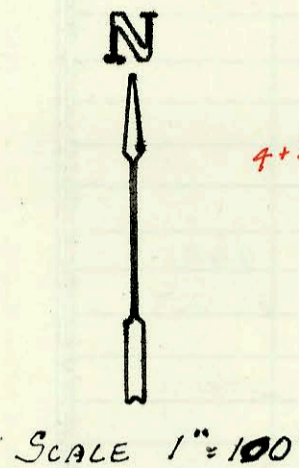
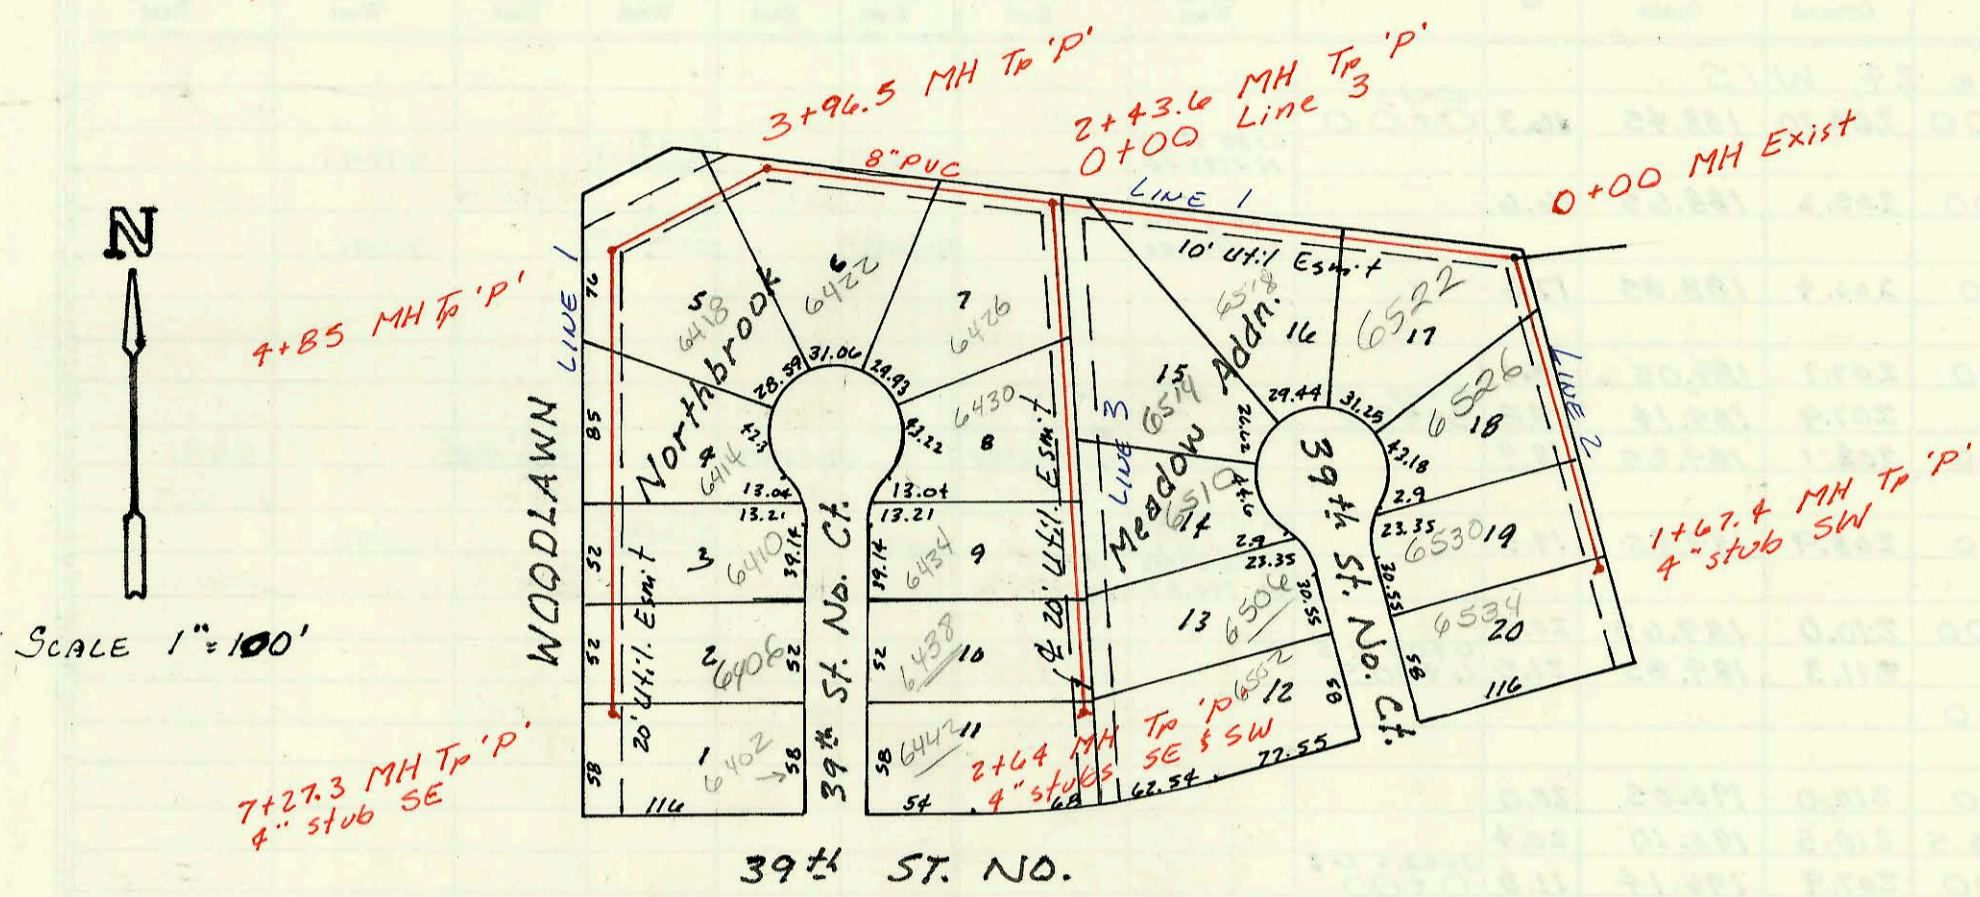


LAT 37, MAIN 9, S.S. # 23  
468-81957 (608430)  
Built By Stannard Const.  
Book 7-31-89 from Plan & Cards

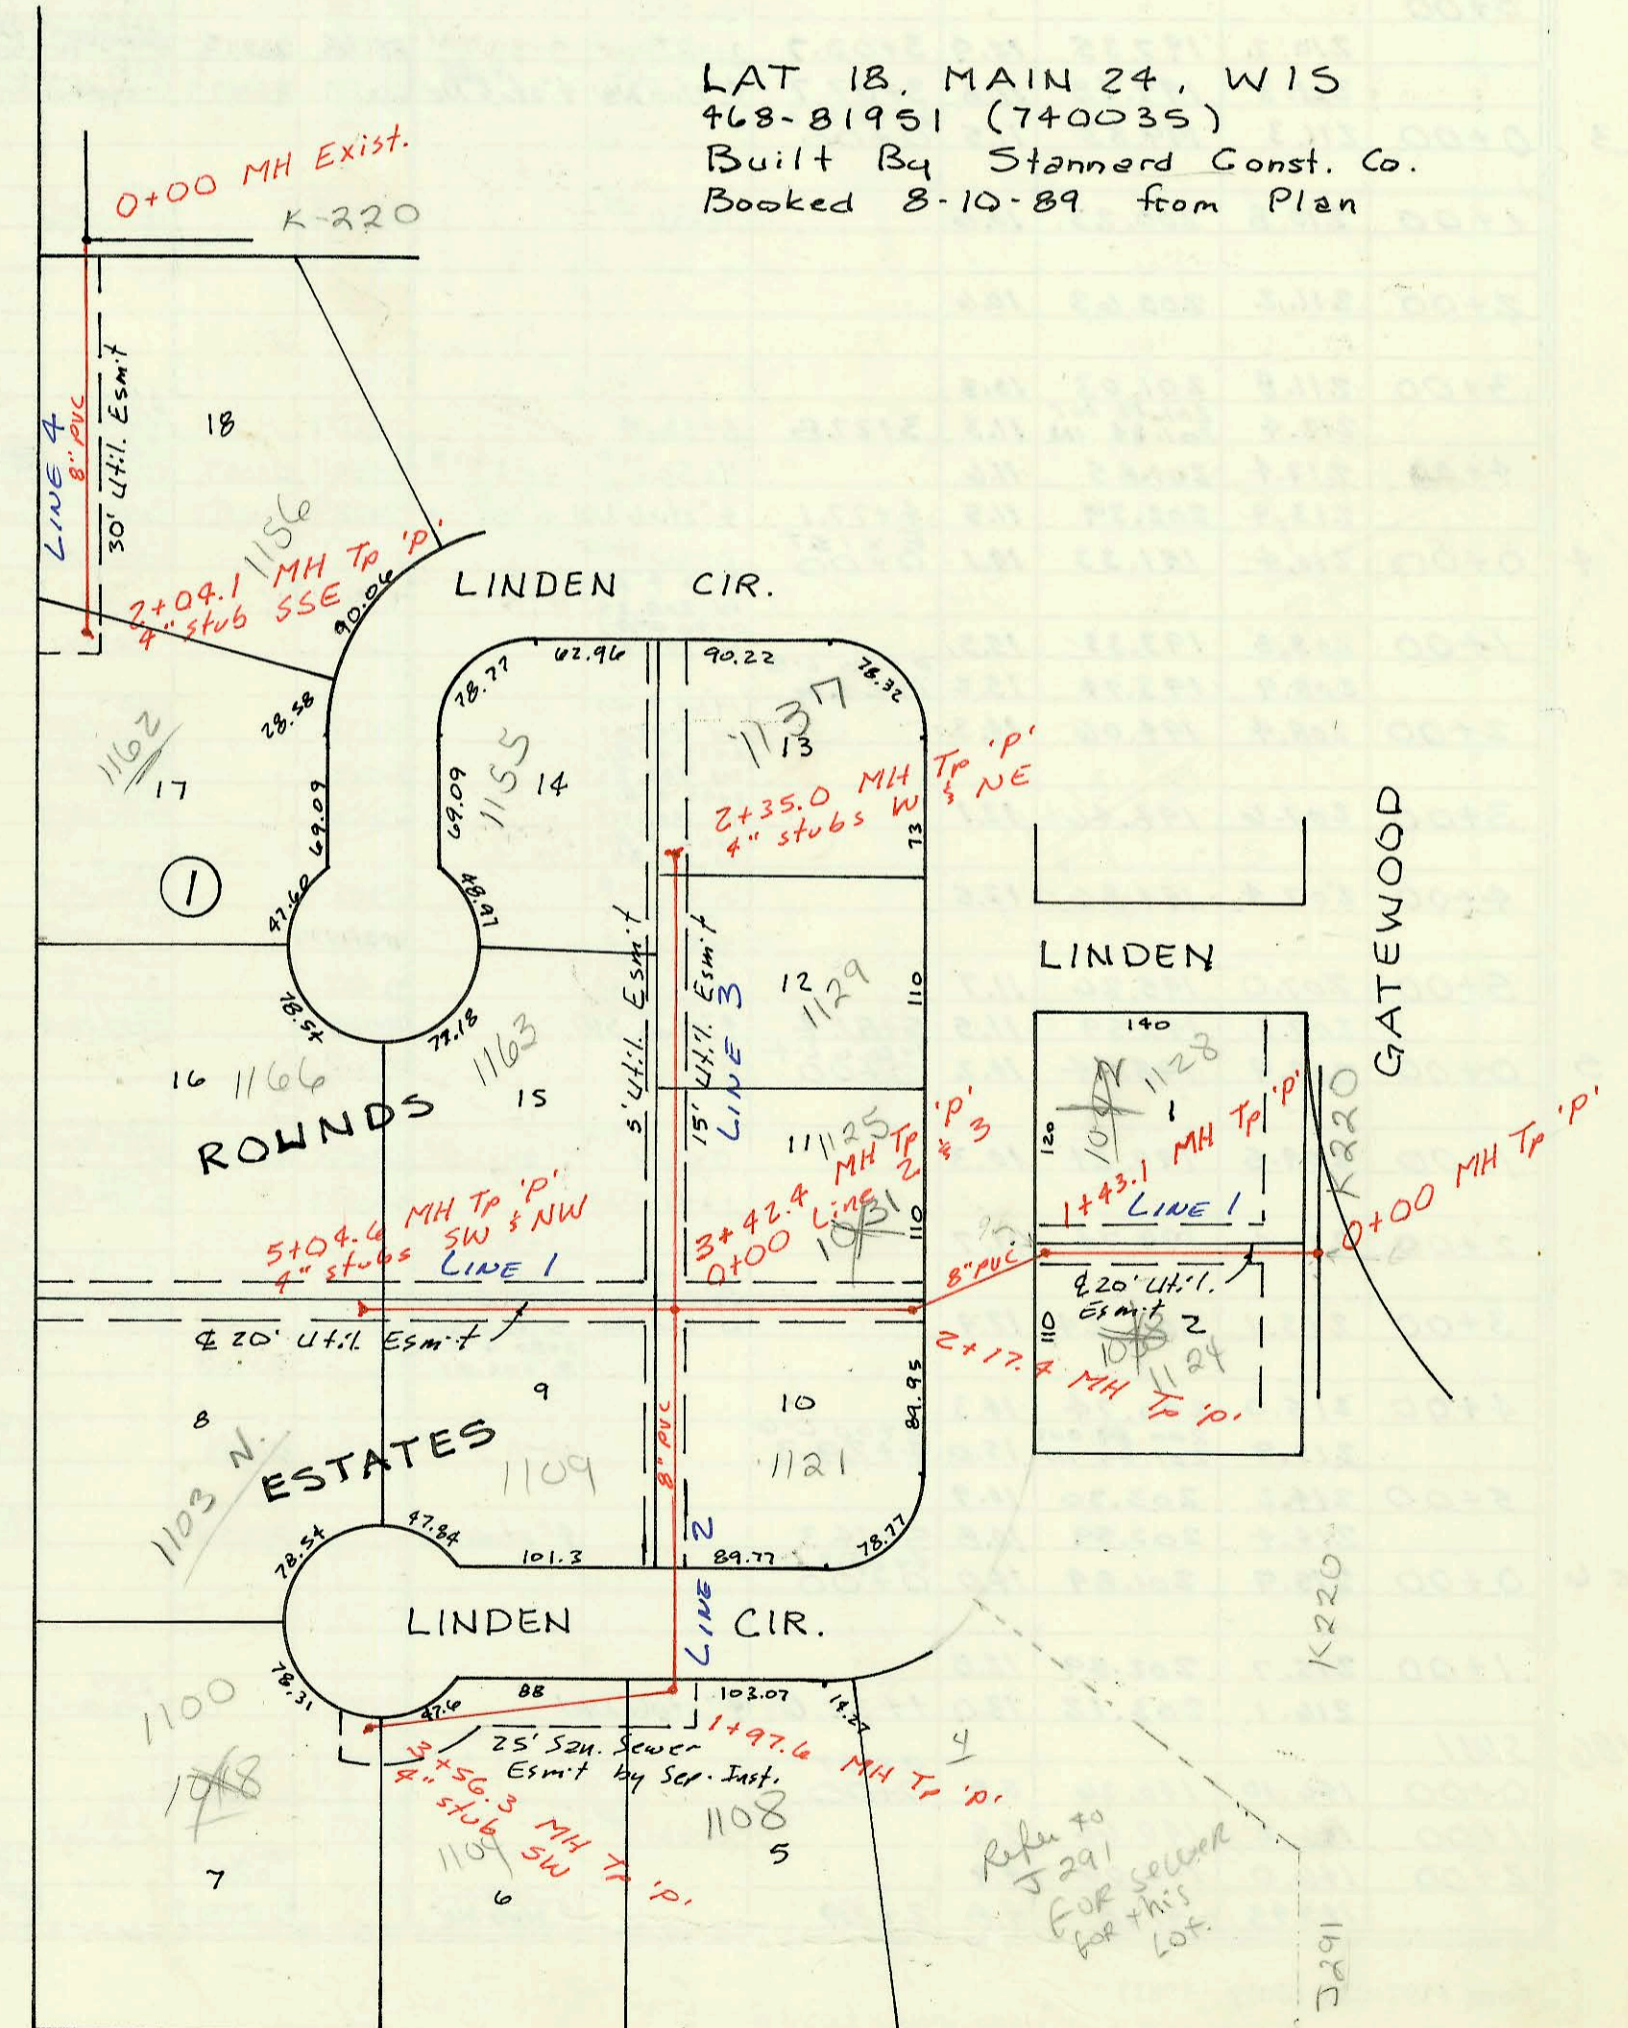

LAT 18, MAIN 24, W15  
468-81951 (740035)  
Built By Stannard Const. Co.  
Booked 8-10-89 from Plan

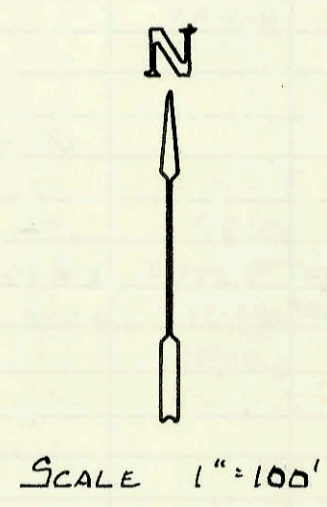

Refer to  
J 291  
FOR SELLER  
FOR THIS  
LOT.

CONSTRUCTION RECORD							SERVICE RECORD					
STATION	ELEVATION		Depth	MANHOLE	4-INCH "Y" BRANCHES		No. of Permit		House Number		DATE OF PERMITS	
	Ground	Grade			North West	South East	North West	South East	North West	South East	North West	South East
LAT 37, LINE 1	MAIN 9, S.S. # 23											
0+00	180.88	170.19	10.7	EXIST 0+00		0+44.0 TAP		23831		6522 E 39th Ct		9-5-89
1+00	184.0	170.79	13.2			1+18.0 TAP		24279		6518 E 39th Ct		11-14-89
2+00	183.0	171.39	11.6									
	182.07	171.65 out 176.85 in	10.4	EXIST L-3 2+43.6								
3+00	182.9	172.19	10.7									
	184.75	172.78 out 172.85 in	12.0	3+96.5		4" SDR 3+67.5 TAP		91-22431-7		6422 E 39th Ct		5-21-91
4+00	184.0	172.87	11.1									
	186.05	173.47 out 172.58 in	12.6	4+85		4+68.0 TAP		27111		6418 E 39th Ct		2-15-91
5+00	185.5	173.66	11.8									
						5" SDR 5+86.0 TAP		91-19477-7		6414 E 39th Ct		3-7-91
6+00	183.0	174.17	8.8									
						6" SDR 6+59.3 TAP		26033		6410 E 39th Ct		8-29-90
7+00	184.0	174.68	9.3									
	184.24	174.82	9.4	7+27.3		7+08.3 TAP		24972		6406 E 39th Ct		3-19-90
				EXIST 0+00		4" stub SE		216724		6402 E 39th Ct		
LINE 2	0+00	180.88	170.41	10.5	EXIST 0+00							
						0+69.0 TAP		24059		6526 E 39th Ct		16-10-89
1+00	180.2	171.05	9.2			1+21.5 TAP		23539		6538 E 39th Ct		7-14-89
	180.75	171.48	9.3	1+47.4		4" stub SW		23538		6534 E 39th Ct		7-14-89
LINE 3	0+00	182.07	171.87	10.1	EXIST L-1 0+00							
						0+18.5 TAP		26964		6426 E 39th Ct		1-28-91
1+00	183.8	172.30	11.5			1+17.0 TAP		26720		6420 E 39th Ct		12-11-90
						1+78.5 TAP		24723		6434 E 39th Ct		12-11-90
2+00	182.7	172.73	10.0			2+39.0 TAP		25432		6438 E 39th Ct		5-29-90
	182.20	173.00	9.2	2+64		4" stub SW		26035		6506 E 39th Ct		12-19-89
						4" stub SE		26038		6502 E 39th Ct		8-29-90
LAT 18, LINE 1	MAIN 24, WIS											
0+00	176.5	169.63	6.9	0+00		0+39.0 TAP		25974		1128 Linden Cl		4-1-93
						0+59.6 TAP		24950		1124 Linden Cl		8-17-90
1+00	178.3	169.93	8.4									
	179.7	170.06	9.6	1+43.1								
2+00	179.4	170.23	9.2									
	180.4	170.28	10.1	2+17.4		4" SDR 35 2+74.4 TAP		9292627		1121 N Linden Cl		6-24-92
3+00	182.5	170.53	12.0			2+78.4 TAP		25677		1081 N Linden Cl		7-9-90
	184.1	170.66 out 172.66 in	13.4	EXIST L-253 3+42.4 L-1 0+00		3" SDR 35 3+94.1 TAP		91-29417-7		1109 N Linden Cl		8-12-91
4+00	185.1	173.12	12.0									
5+00												
	186.0	173.95	12.9	5+04.6		4" SDR 35 5+92.4 L-1 0+00		93-26187-7		1160 Linden		2-4-92
LINE 2	0+00	184.1	171.66	12.4	EXIST L-1 0+00							
1+00	183.4	171.96	11.4									
	182.5	172.25 out 172.35 in	10.3	1+97.6						1108 Linden Cl		7-4-93
2+00												
						3" SDR 35 2+43.3 TAP		91-23712-7		1104 Linden Cl		6-10-91
3+00	183.9	173.58	10.3									
	184.7	174.26	10.4	3+56.3		4" stub SW		24949		1100 Linden Cl		3-16-90
LINE 3	0+00	184.1	170.76	13.3	EXIST L-1 0+00							
1+00	184.1	171.06	13.0			4" SDR 35 1+40.0		94-62647		1163 Linden		5-2-94
						4" SDR 35 1+55 TAP		93-9759-7		1129 N Linden Cl		4-29-93
2+00	184.9	171.36	13.5									
	184.9	171.47	13.4	2+35.0		4" SDR 35 4" stub W		92-92627		1155 N Linden Cl		6-24-92
LINE 4	0+00	188.8	175.44	13.4	EXIST 0+00							
						4" SDR 35 4" stub NE		1750		1137 N Linden Cl		12-19-91
1+00	184.5	175.74	8.8									
						4" SDR 35 2+59.1 TAP		93-99607		1156 Linden		4-29-93
2+00												
	184.5	176.05	8.5	2+04.1		4" SDR 4" stub SSE		27295		1162 Linden Cl		3-21-91