

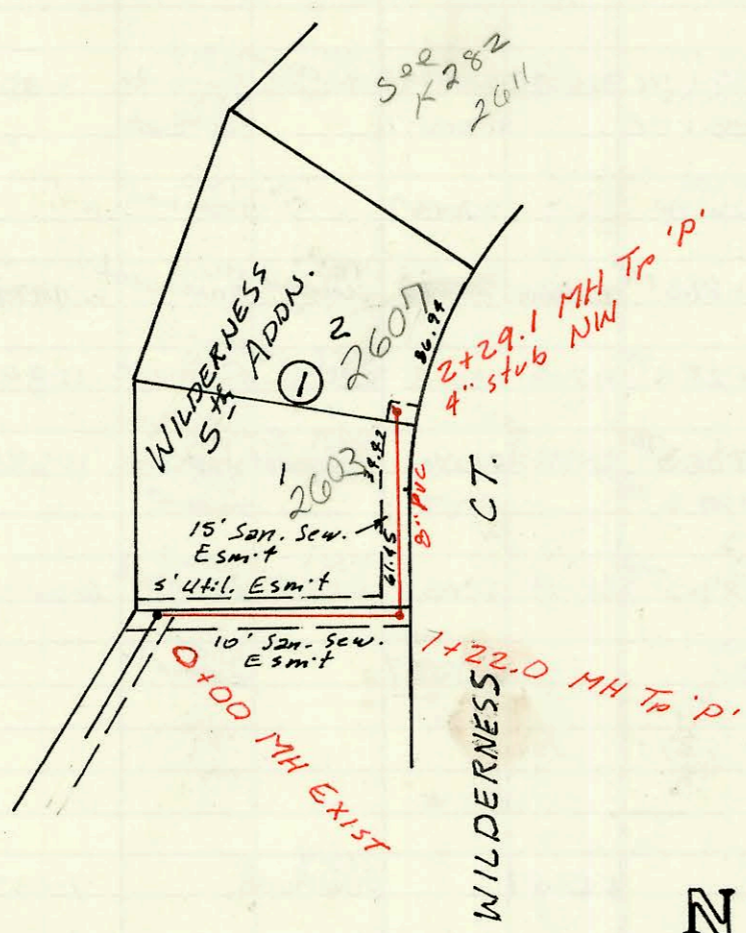
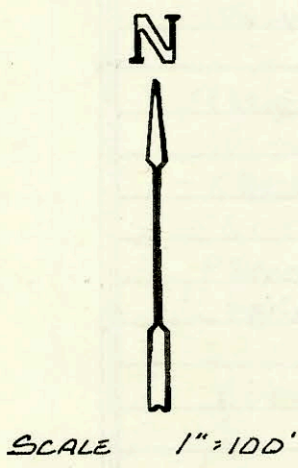


LAT 42, MAIN 10, S.S. # 22
46B-81969 (740100)
Built By Stannard Const.
Booked 10-30-89 from Plan

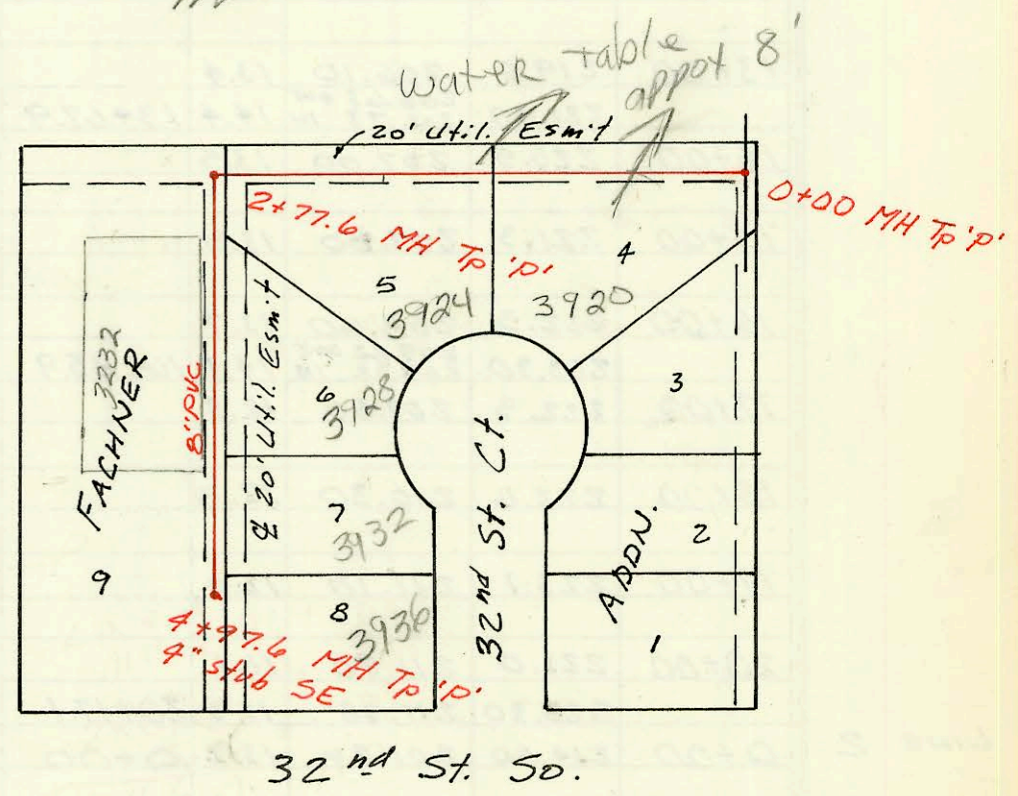


LAT 51, MAIN 22, W. I. S.
46B-81970 (740018)
Built By MID STATES CONST.
Booked 10-31-89 from Plan

LAT 11, MAIN 23, S.S. # 22
46B-81956 (740001)
Built By MID STATES CONST.
Booked 10-31-89 from Plan

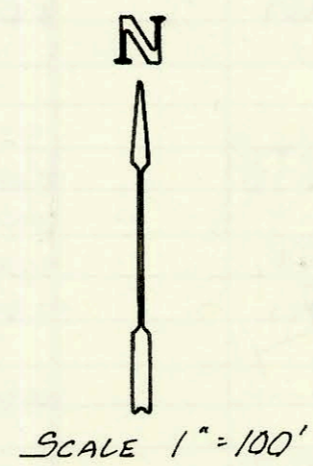

LAT 52, MAIN 5, S.S. # 23
46B-81919 (607259)
Built By Stannard Const.
Booked 11-21-89 from Plan

2395 N
Beacon Hill
see COMPANOR
FOR REST OF
LINE

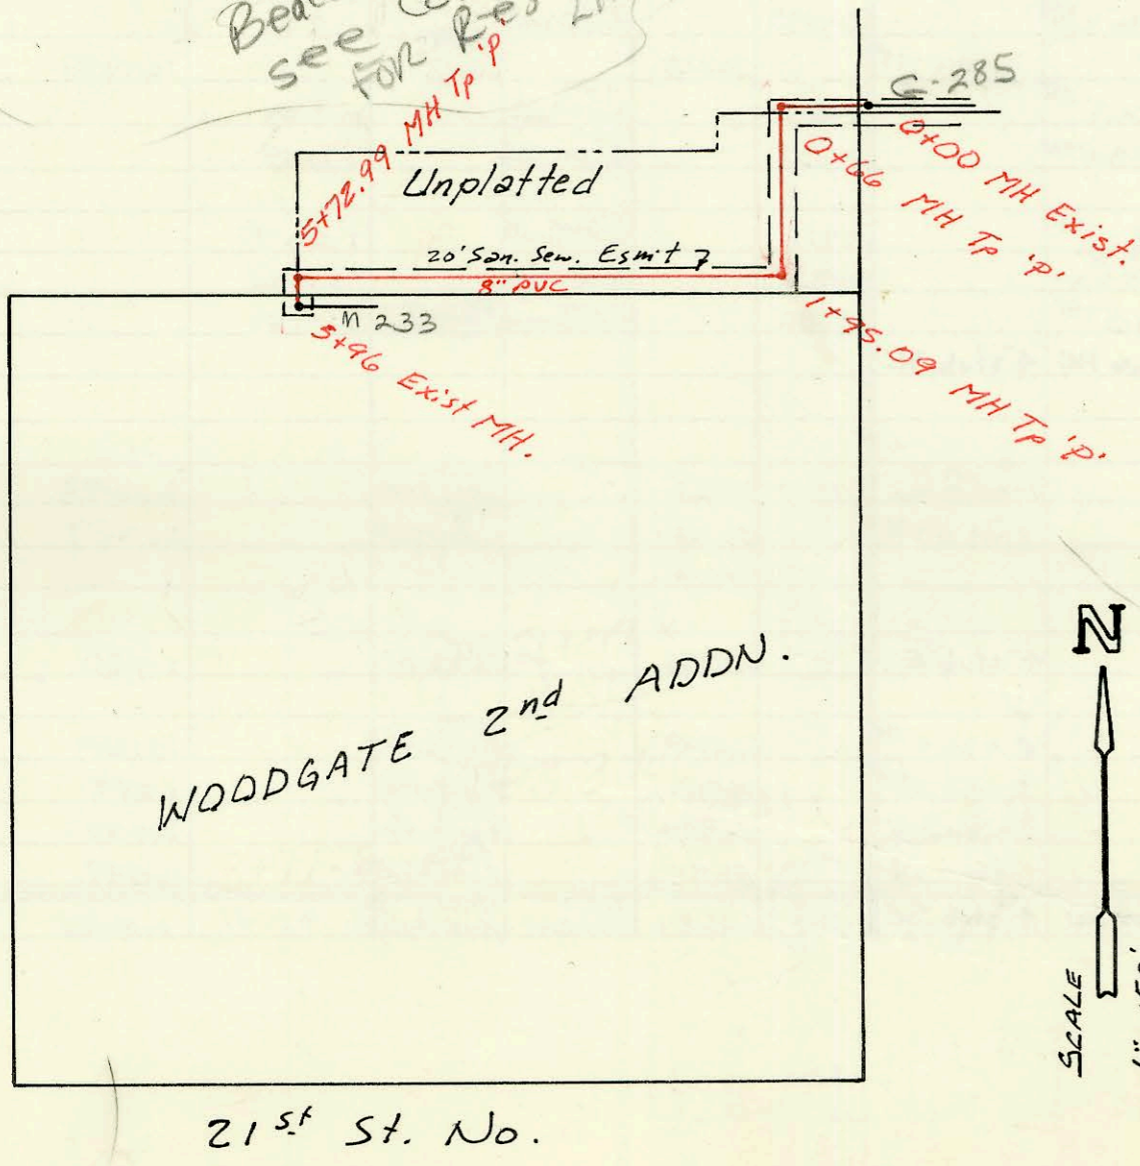

CONSTRUCTION RECORD						SERVICE RECORD						
STATION	ELEVATION		Depth	MANHOLE	4-INCH "Y" BRANCHES		No. of Permit		House Number		DATE OF PERMITS	
	Ground	Grade			North West	South East	North West	South East	North West	South East	North West	South East
LAT 98, MAIN 10, S.S. # 22												
LINE 1 0+00	129.71	122.32	7.4	0+00								
	131.2	122.53 ^{OUT} 122.53 ^{IN}	8.8	0+43.6		0+65.0 TAP		24070		3520 W 19th		10-10-89
1+00	131.3	122.12	8.6			1+28.9 TAP		24860		3592 W 19th		2-26-90
2+00	131.8	123.02	8.8			2+00.9 TAP		24021		3538 W 19th		10-4-89
	132.6	123.15 ^{OUT} 123.25 ^{IN}	9.5	2+41.9	2+46.9 TAP			24274		2008 Westridge		11-29-89
	132.8	123.40	9.4	2+94.3	4" stub SW			24071		3592 W 19th		10-10-89
LINE 2 0+00	132.4	123.25	9.4	0+00		0+57.6 TAP						
	133.1	123.51	9.6	0+86.6	8" stub N			24375		2012 Westridge		11-29-89
LAT 51, MAIN 22, W 15												
0+00	200.42	191.90	8.7	EXIST. 0+00								
1+00	203.0	192.70	10.3									
	203.8	192.88 ^{OUT} 193.08 ^{IN}	10.9	1+22.0	4" stub 2002.5 tap			23-375-7		2603 W 19th		12-30-92
2+00	204.0	193.70	10.3									
	204.3	193.93	10.4	2+29.1	4" stub NW			24945		2607 W 19th		3-16-90
LAT 11, MAIN 23, S.S. # 22												
0+00	102.10	90.88	11.2	0+00								
1+00	103.5	91.28	12.2			0+55.0 TAP		23944		3720 S. 3211 S. Ct		9-25-89
2+00	103.0	91.68	11.3			1+88.0 TAP		23964		3724 S. 3211 S. Ct		9-26-89
	103.20	91.99 ^{OUT} 92.09 ^{IN}	11.2	2+77.6								
3+00	102.6	92.18	10.4									
4+00	102.5	92.58	9.9			3+71.6 TAP		24092		3748 S. 3211 S. Ct		10-12-89
	103.1	92.97	10.1	4+97.6	4" stub SE			24761		3237 W 19th		9-8-90
LAT 52, MAIN 5, S.S. # 23												
0+00	199.41	186.79	12.6	0+00								
	200.20	187.17 ^{OUT} 187.31 ^{IN}	13.1	0+66.0								
1+00	200.9	188.27	12.6									
	203.35	190.97 ^{OUT} 191.07 ^{IN}	12.4	1+95.09								
2+00												
3+00	203.9	192.12	11.8									
4+00	204.3	193.13	11.2									
5+00	204.3	194.13	10.2									
	204.57	194.86 ^{OUT} 198.51 ^{IN}	9.7	5+73								
	206.10	198.75	7.4	5+96								