

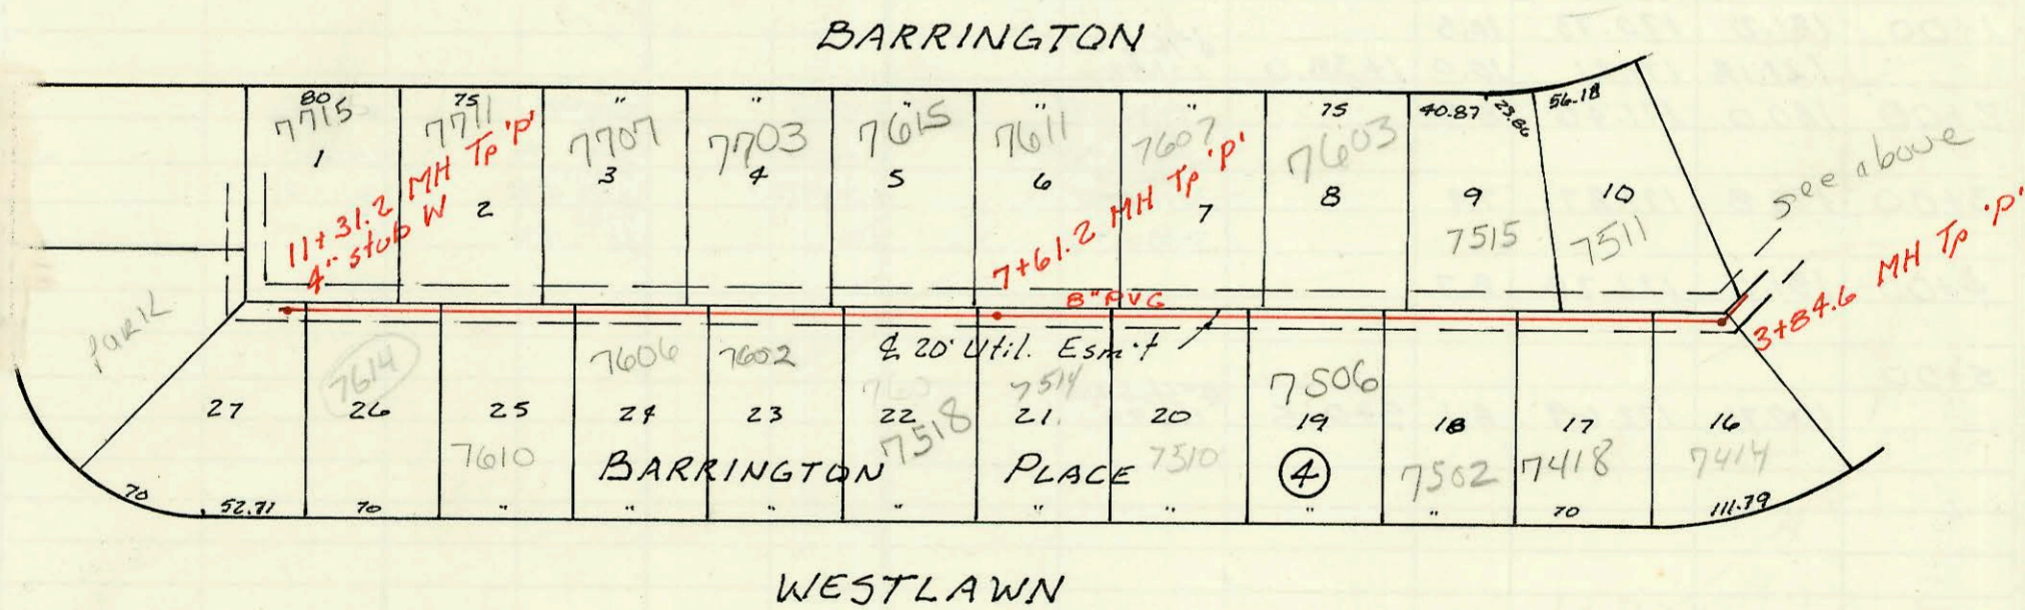
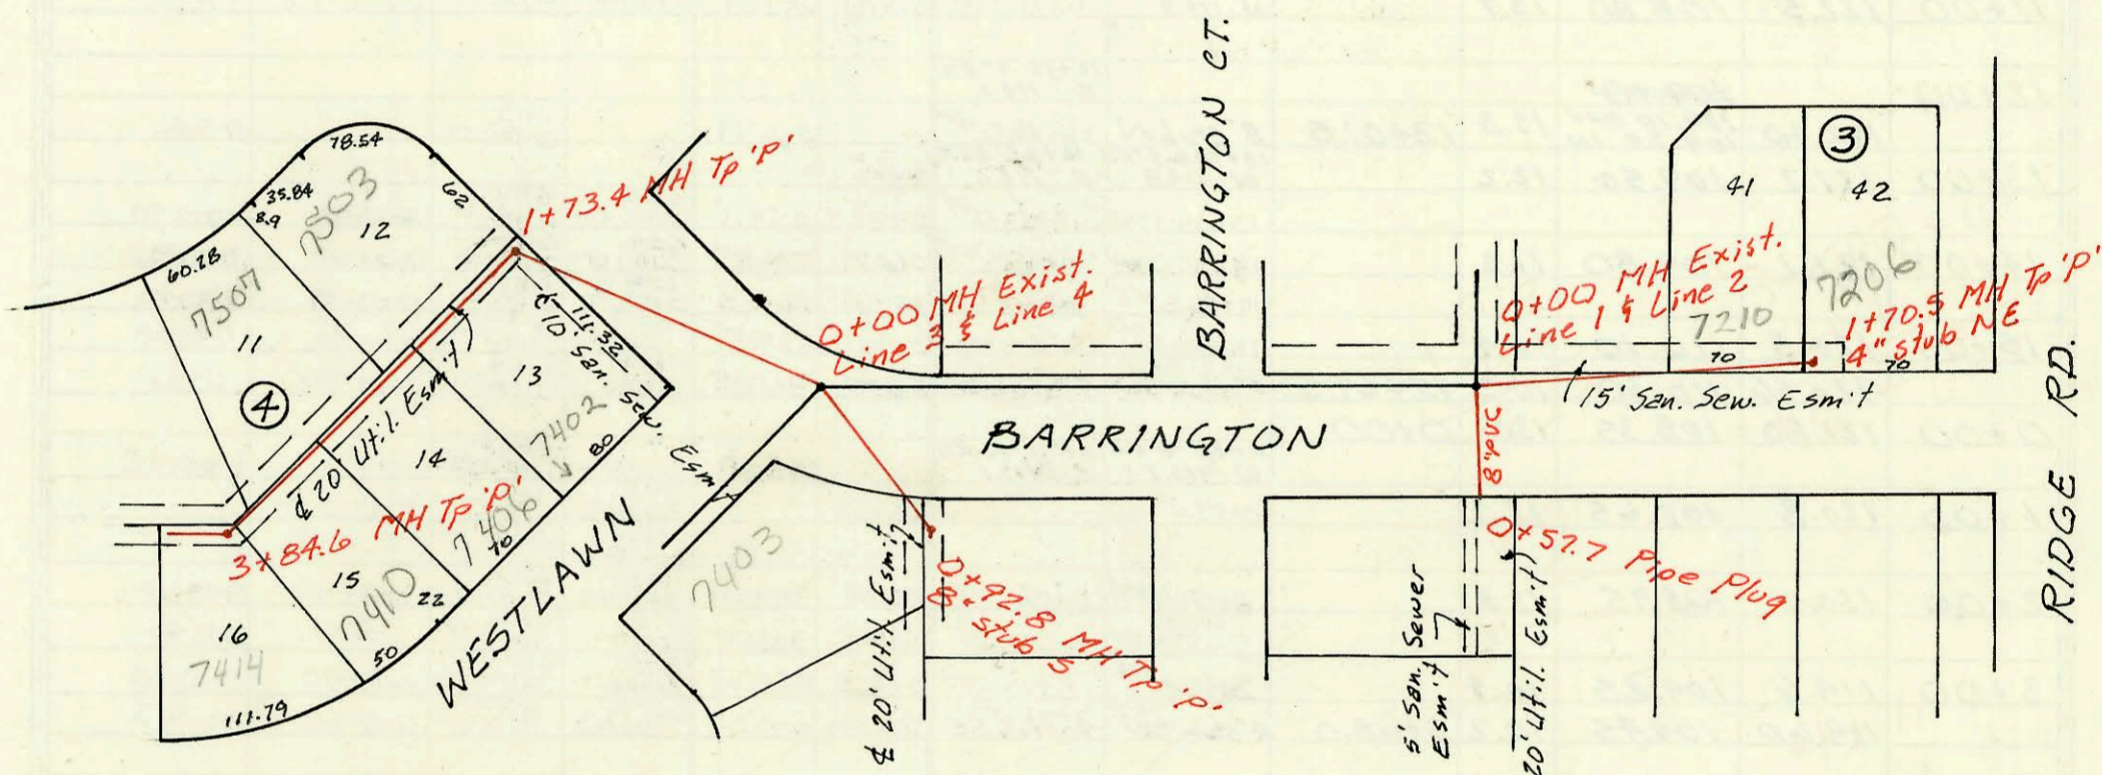
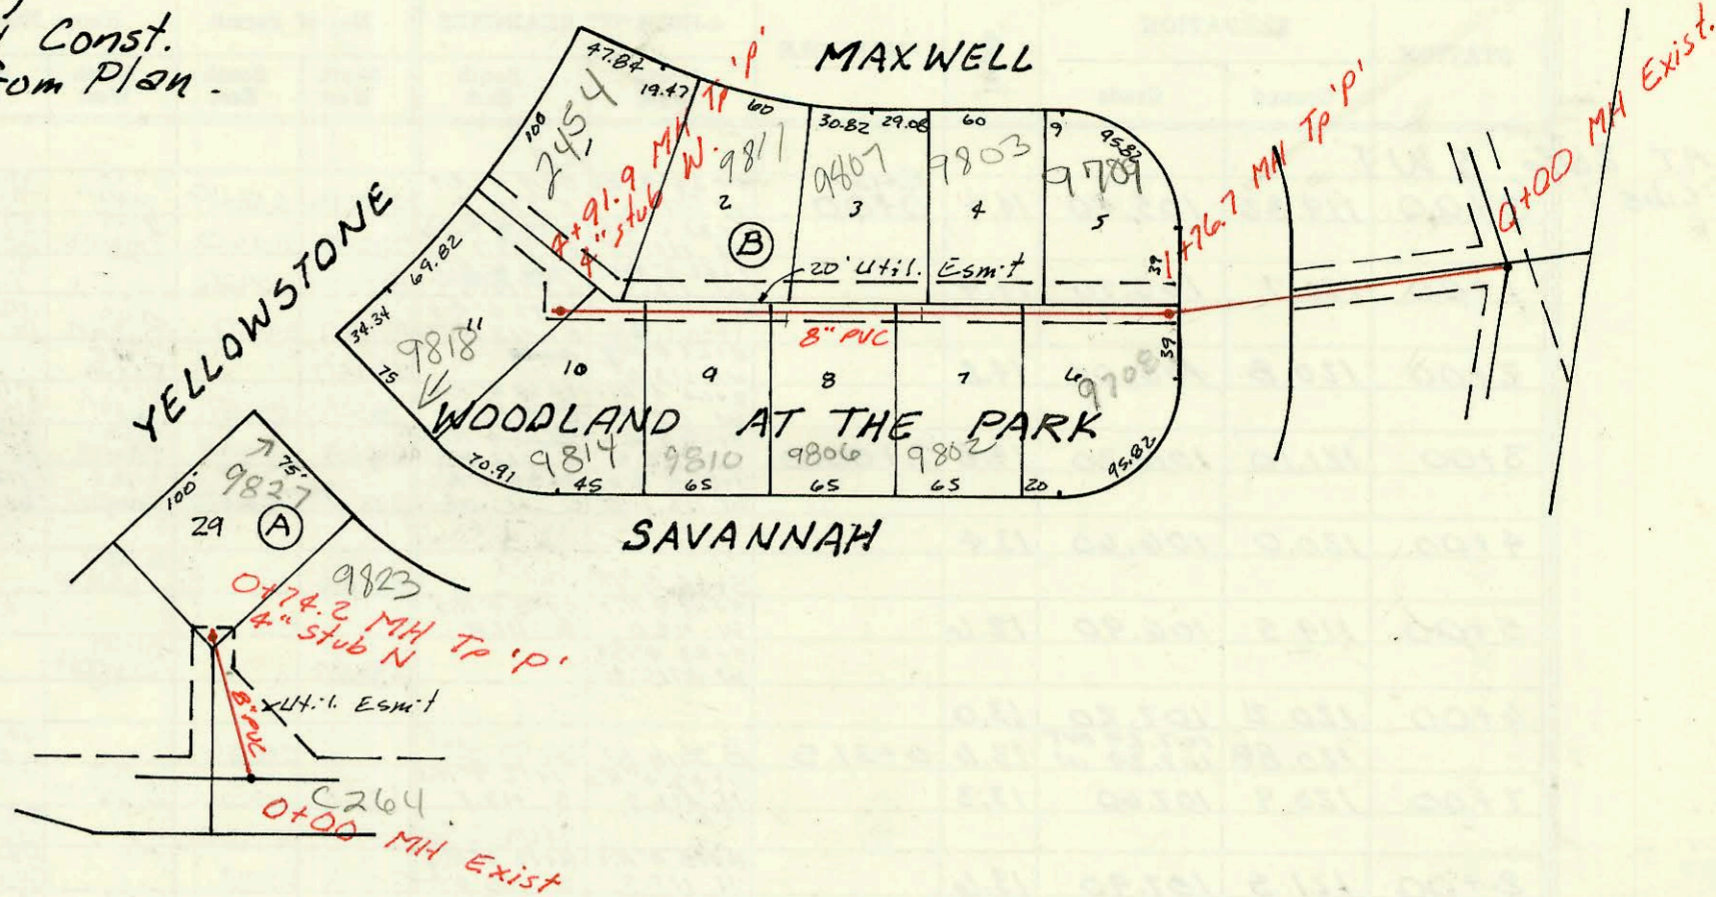


LAT 274, SWI  
468-81873 (740134)  
Built By Stannard Const.  
Booked 12-19-89 from Plan.

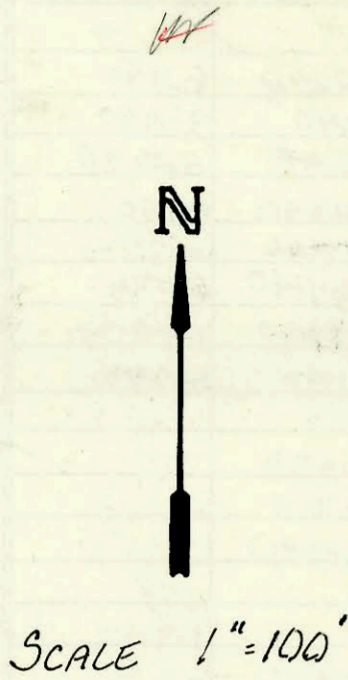

LAT B, MAIN 15, SWI  
468-81846 (740027)  
Built By Mid States  
Booked 1-2-90 from Plan.

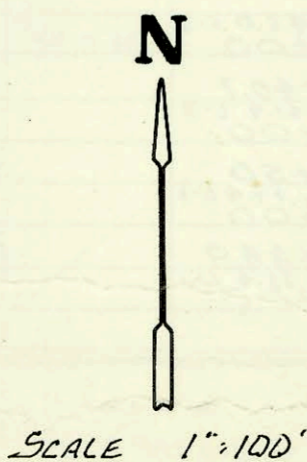

CONSTRUCTION RECORD						SERVICE RECORD							
STATION	ELEVATION		Depth	MANHOLE	4-INCH "Y" BRANCHES		No. of Permit		House Number		DATE OF PERMITS		
	Ground	Grade			North West	South East	North West	South East	North West	South East	North West	South East	
LAT 274, SW I													
Line 1	0+00	122.8	112.90	9.9	0+00								
	1+00	124.0	113.81	10.2									
		124.5	114.50 out 114.60 in	10.0	1+76.7								
	2+00	124.7	114.93	9.8		4" sch 40 Pvc 2+10.7 tap 4" sch 40 Pvc 3+07.3	97-20686-7 91-39482-7	9709 9805	9708 9802	9709 9802	11-21-97 12-24-91	7-8-98 7-15-94	
	3+00	124.9	116.32	8.6		4" SDR 35 3+28.3 4" SDR 35 4+12.9 tap 4" SDR 35 4+82.9 tap	3+75.9 tap 4" SDR 35 4+01.3 4" SDR 35 4+59.9 tap	94-7571-7 91-20061-7 92-1606-7	#26572 92-44119-7 92-33576-7	9807 W 9811 W 9814 9818	9806 9810 9814 9818	5-20-94 4-9-91 1-31-92	9-2-90 12-4-92 9-30-92
	4+00	127.0	117.72	9.3									
		128.5	119.00	9.5	4+91.9	4" stub W							
Line 2	0+00	131.5	122.70	8.8	0+00								
		132.8	123.80	9.0	0+74.2	4" stub N							
							92-25779-7		9829	Savannah		9-1-92	
LAT 8, MAIN 15, SW I													
Line 1	0+00	145.59	133.46	12.1	0+00	Exist. 4" SDR 35 1+58.9 tap							
	1+00	145.4	134.36	11.0									
		145.7	134.99	10.7	1+70.5	4" stub NE							
Line 2	0+00	145.59	132.46	13.1	0+00	Exist.							
	0+57.7	145.5	132.69	12.8									
Line 3	0+00	145.13	132.94	12.2	0+00	Exist.							
		146.3	133.31	13.0	0+92.8	8" stub S							
Line 4	0+00	145.13	134.23	10.9	0+00	Exist.							
	1+00	145.2	134.63	10.6									
		146.2	134.92 out 135.12 in	11.3	1+73.4								
	2+00	146.5	135.28	11.2		4" SDR 35 2+39.9 tap 4" SDR 35 2+20.4 tap 4" SDR 35 2+74.6 tap 4" SDR 35 3+19.6 tap 4" SDR 35 3+65.6 tap	72-2832-7 92-9057-7 93-1791-7 92-151 95-1532-7 93-1926-7 97-6547-7	7503 7402 7400 W 7507 7511 W 7514 W	7402 7410 7414 W 7418 7502 7506 7510	7402 7410 7414 W 7418 7502 7506 7510	2-25-92 6-18-92 1-26-93 9-18-90 9-26-95 7-23-93 4-25-94	6-18-92 1-26-93 9-26-95 4-25-94	
	3+00	148.5	135.88	12.6									
		149.5	136.39 out 136.59 in	13.1	3+84.6								
	4+00	149.4	136.68	12.7									
	5+00	149.9	137.28	12.6									
	6+00	150.0	137.88	12.1									
	7+00	150.0	138.48	11.5									
		151.2	138.85	12.4	7+61.2								
	8+00	151.1	139.51	11.6									
	9+00	152.1	141.21	10.9									
	10+00	154.2	142.91	11.3									
	11+00	155.7	144.61	11.1									
		155.7	145.14	10.6	11+31.2	4" stub W							

Form #192-020 (July, 1981) \*94-9462-7 6-16-94 7711 W BARRINGTON (Repl approx 40' under pool with 4" PVC sch 40)