



N  
SCALE 1"=100'

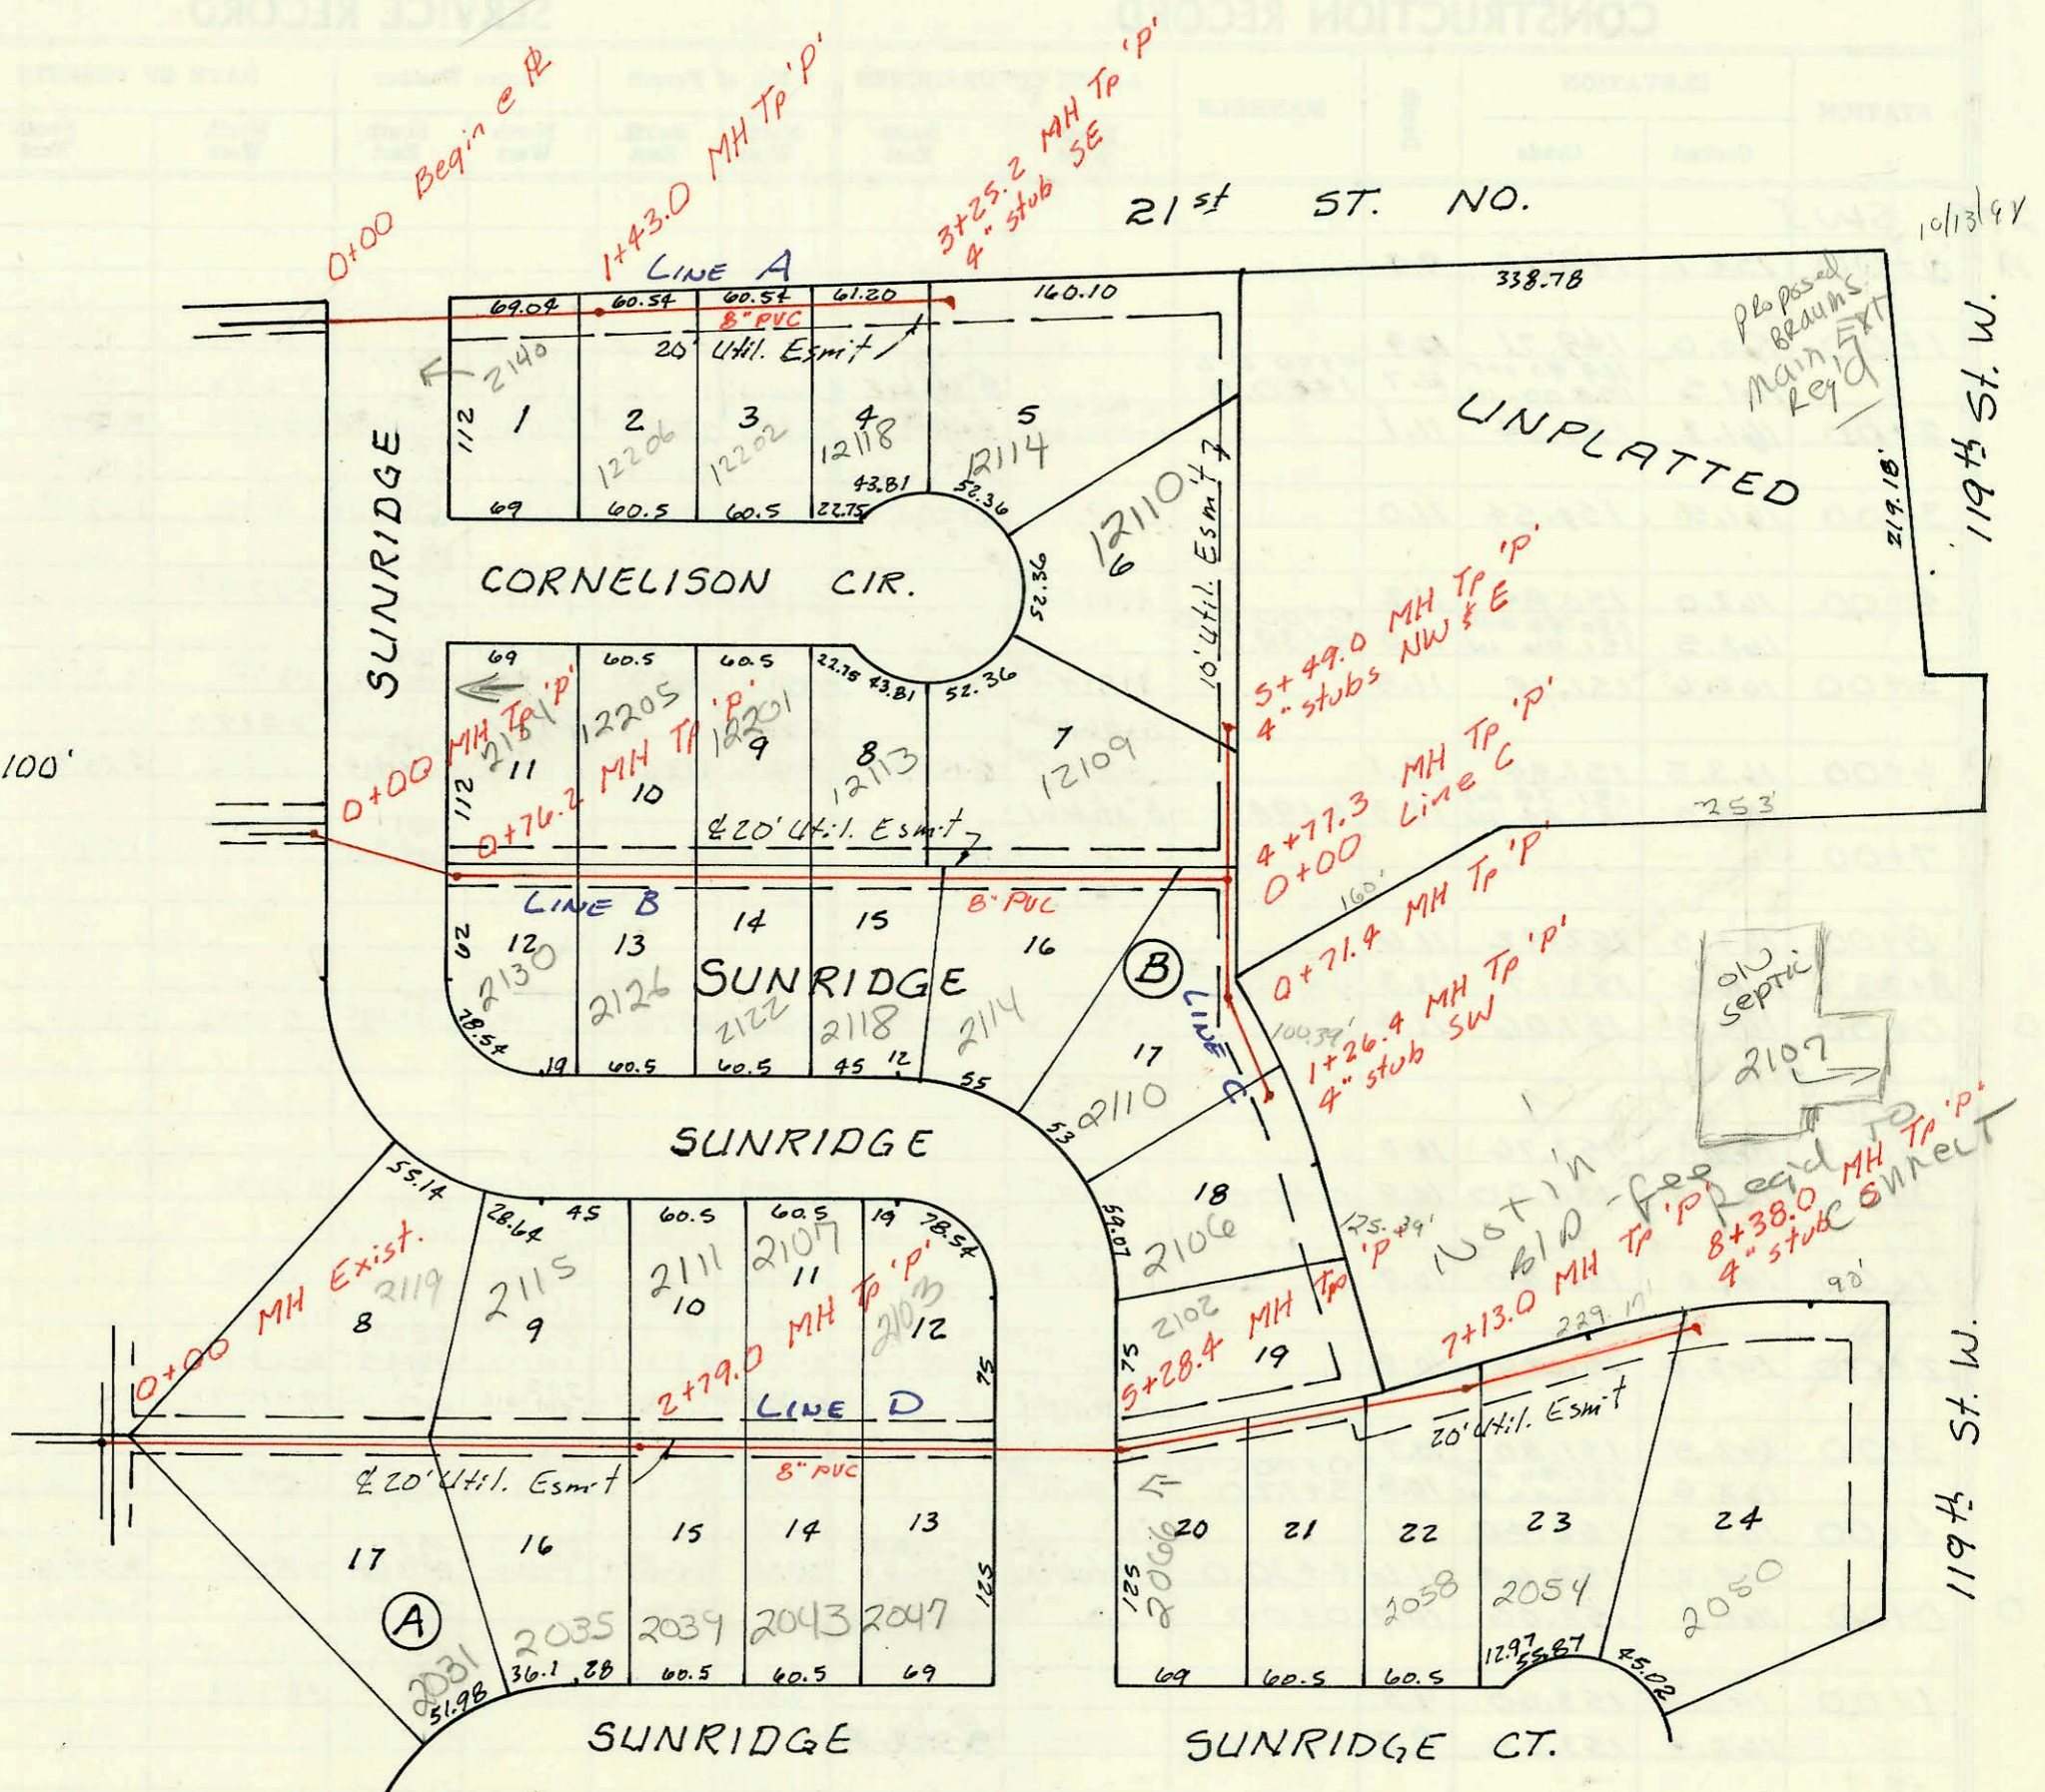

LAT 276, SW1  
 468-81928 (608083)  
 Built By Mid States  
 Booked 1-22-90 from Plan.  
 MH

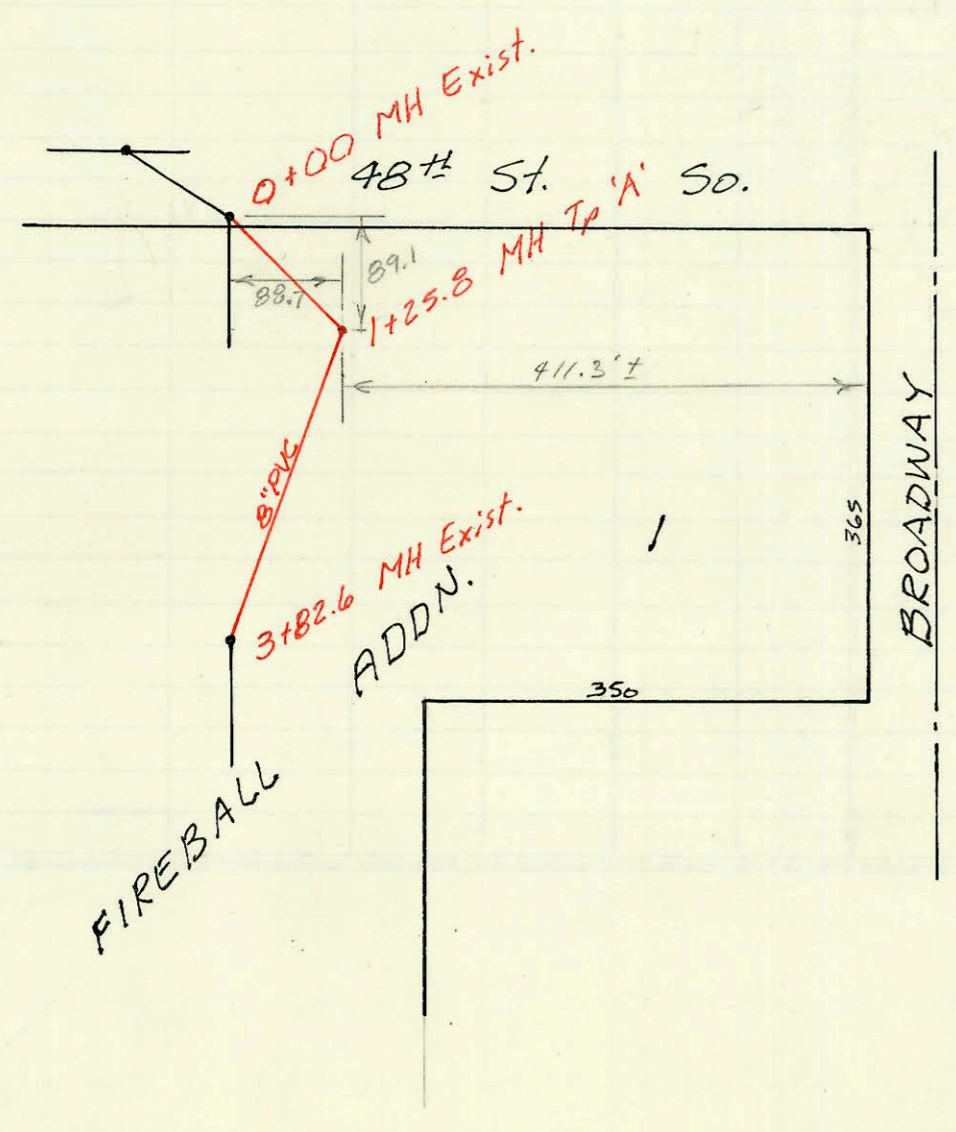

Priv. San. Sewer Relocation to serve  
 Lot 1, Fireball Addn.  
 222 PPS Built By Stannard Const.  
 Booked 2-15-90 from As Built Plan  
 MP

N  
SCALE 1"=150'

CONSTRUCTION RECORD							SERVICE RECORD					
STATION	ELEVATION		Depth	MANHOLE	4-INCH "Y" BRANCHES		No. of Permit		House Number		DATE OF PERMITS	
	Ground	Grade			North West	South East	North West	South East	North West	South East	North West	South East
LAT 276 SW1 LINE A	0+00	166.0	153.17	12.8								
	1+00	165.1	154.33	10.8								
		165.6	154.83	10.8	1+43.0							
	2+00	165.5	155.49	10.0								
	3+00	166.5	156.65	9.9								
		167.3	156.95	10.4	3+25.2							
LINE B	0+00	163.3	152.76	10.5	0+00							
		164.2	153.78	10.4	0+76.2							
	1+00	164.0	153.89	10.1								
	2+00	165.0	154.36	10.6								
	3+00	165.7	154.83	10.9								
	4+00	166.5	155.30	11.2	0+00 L-C							
		167.2	155.76 IN	11.5	4+77.3							
	5+00	167.0	155.86	11.1								
LINE C	0+00	167.2	155.76	11.4	0+00 B							
		166.8	156.02	10.8	0+71.4							
	1+00	166.5	156.18	10.3								
LINE D	0+00	161.4	149.90	11.5	0+00							
	1+00	162.0	150.98	11.0								
	2+00	163.0	152.06	10.8								
		164.3	152.91	11.4	2+79.0							
	3+00	164.0	153.14	10.9								
	4+00	165.0	154.22	10.8								
	5+00	165.0	155.30	9.7								
		165.8	155.60	10.2	5+28.4							
	6+00	166.4	156.30	10.1								
	7+00	166.5	157.28	9.2								
		166.9	157.41	9.5	7+13.0							
	8+00	167.5	158.26	9.2								
		168.6	158.68	9.9	8+38.0							
Priv. Sewer Relocation for Lot 1 Fireball Addn.	0+00	86.18	80.22	6.0	0+00							
	1+00	86.8	80.44	6.4								
		86.76	80.61 IN	6.3	1+25.8							
	2+00	86.5	80.76	5.7								
	3+00	86.3	80.96	5.3								
		86.38	81.13	5.3	3+82.6							