

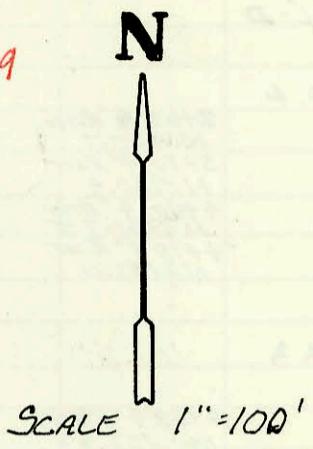


LAT 278, SWI.  
 46B-81930 (608091)  
 Built By Mid-States  
 Booked 1-29-90 from Plan  
 MP

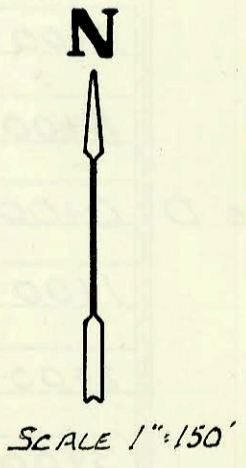

SAN. SEWER LIFT STATION AND FORCE MAIN  
 FOR LAT 276, 277, 278, 279, SWI  
 46B-81927 (608075)  
 Built By MID-STATES CONST.  
 Booked 2-1-90 from Plan  
 MP

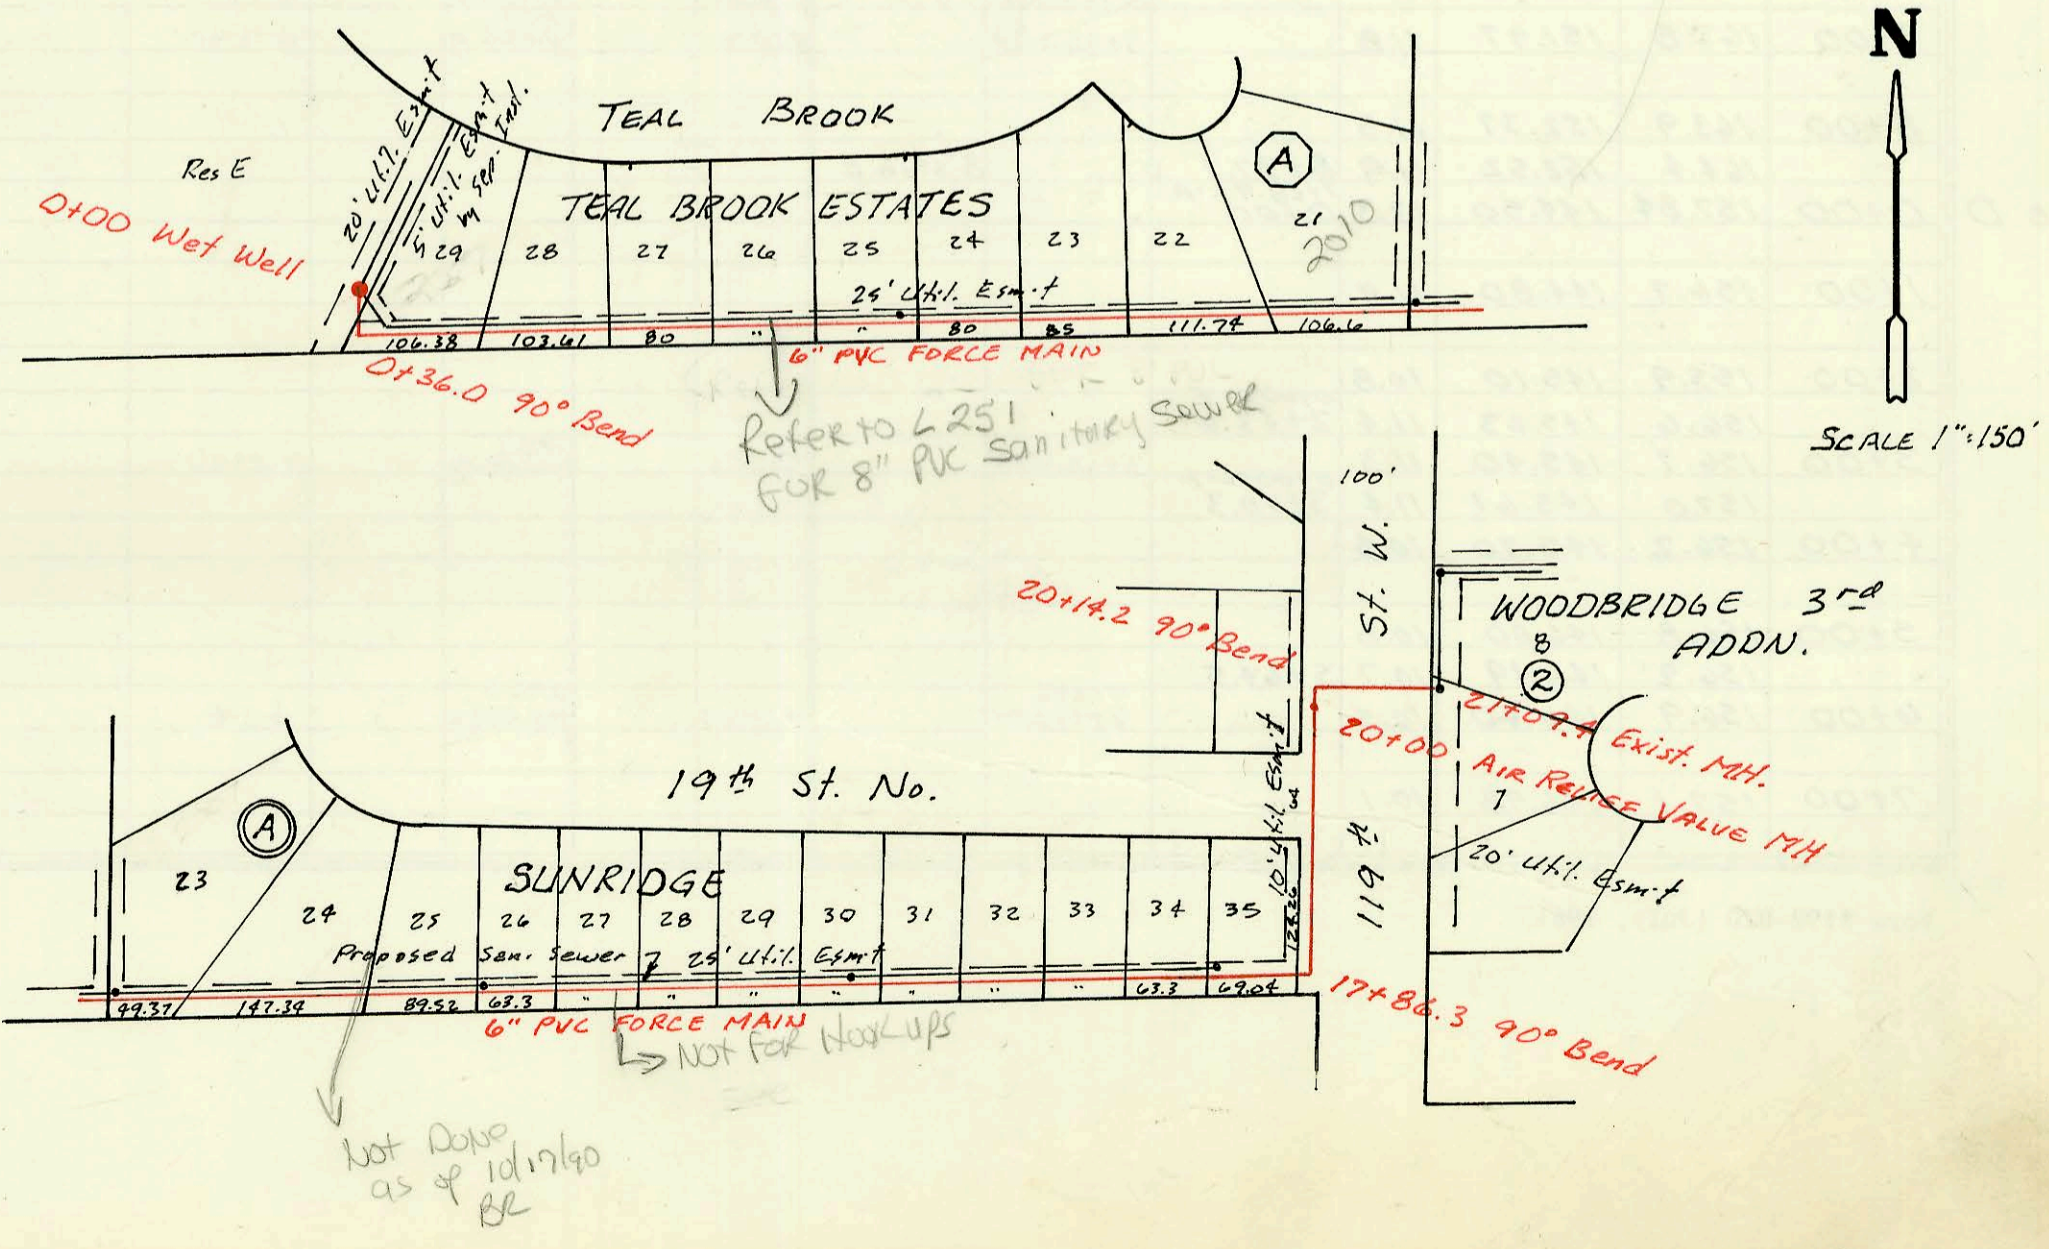

Not done  
 as of 10/17/90  
 BE

CONSTRUCTION RECORD							SERVICE RECORD					
STATION	ELEVATION		Depth	MANHOLE	4-INCH "Y" BRANCHES		No. of Permit		House Number		DATE OF PERMITS	
	Ground	Grade			North West	South East	North West	South East	North West	South East	North West	South East
LAT 278 SW I												
LINE A	0+00	158.7	148.78	9.9								
	1+00	160.6	149.71	10.9								
		161.5	149.90 OUT 150.00 IN	11.7	0+00 L-C 1+20.0					2152 Pintail		9-2-92
	2+00	161.3	150.24	11.1		4" SDR 35 2+25.0 tap	2+49.0 TAP	92 8218.7	25282	2109 Pintail	2123 Sunridge	6-4-92 5-7-90
	3+00	161.5	150.54	11.0		3+29.0 TAP	3+20.0 TAP	194407	24654	2110 Pintail	2129 Sunridge	4-1-91 1-22-90
	4+00	162.0	150.84 150.96 OUT 151.06 IN	11.2 11.5	0+00 L-B 4+39.0		4+14.0 TAP		24826	2114 Pintail		2-20-90
	5+00	162.6	151.14	11.5		4+71.0 TAP 5+76.0 TAP	5+56.0 TAP	24543	26220	2118 Pintail 2122 Pintail	2134 Sunridge	1-3-90 9-26-90 3-27-90
	6+00	163.5	151.44 151.74 OUT 151.84 IN	12.1 13.3			6+06.0 tap		193907		2143 Sunridge	2-28-91
	7+00				6+98.0		8" stub W		24541		2147 Sunridge	1-3-90
	8+00	164.5	152.92	11.6								
LINE B	8+23.1	166.5	153.17	13.3								
	0+00	162.5	151.06	11.4		4" SDR 35 0+39.5 tap	0+39.0 TAP	92 2377.7	26704	2135 Sunridge	2131 Sunridge	2-20-92 12-10-90
	1+00											
LINE C	1+15.5	162.8	152.76	10.0								
	0+00	161.5	150.00	10.9	0+00	0+65.0 TAP		26609		2034 N Pintail		8-23-90
	1+00	161.5	150.60	10.9		1+03.0 TAP	4" SDR 35 35.0 tap	92 8216.7		2027 Sunridge		6-4-92
	2+00	162.0	151.20	10.8		2+22.0 TAP 4" SDR 35 2+70.0 tap	2+28.0 TAP	92 25243	91-29610.7	2026 Pintail 2022 Pintail	2023 Sunridge	8-27-90 8-2-91 7-10-91
	3+00	162.5	151.80 151.96 OUT 152.06 IN	10.7 10.8	0+00 L-D 3+27.0	3+90.0 TAP		25242		2028 Pintail		4-27-90
	4+00	163.5	152.40	11.1			4" SDR 35 4" stub W	24336	91304181	2014 Pintail	2011 Sunridge	9-14-90 8-21-91
LINE D	0+00	162.8	152.06	10.7	0+00	4" SDR 35 0+46.0 TAP	4" stub E	92 586.7			2015 Sunridge	1-13-92
	1+00	162.5	153.00	9.5				92 3121.7		2019 Sunridge		10-1-91
		162.4	153.25	9.2	1+27.0		8" stub E					
SAN. SEW LIFT STA. \$ F.M for Lat 276-277-278-279 SW I												
	0+00	158.00	144.80	13.2	WET WELL 0+00							
	0+36	152.0	145.88	6.1								
	1+00	154.5	147.80	6.7								
	2+00	158.5	150.80	7.7								
	3+00	161.7	153.80	7.9								
	4+00	162.5	154.40	8.1								
	5+00	163.0	155.00	8.0								
	6+00	163.5	155.60	7.9								
	7+00	163.6	156.20	7.4								
	8+00	163.6	156.80	6.8								
	9+00	164.0	157.40	6.6								
	10+00	164.3	158.00	6.3								
	11+00	165.1	158.60	6.5								
	12+00	165.8	159.34	6.5								
	13+00	166.1	160.08	6.0								
	14+00	166.5	160.28	6.2								
	15+00	167.0	160.48	6.5								
	16+00	168.0	160.68	7.3								
	17+00	168.6	160.88	7.7								
	17+86.3	169.0	161.05	8.0								
	18+00	168.9	161.08	7.8								
	19+00	168.5	161.28	7.2								
	20+00	168.6	161.48	7.1	20+00							
	20+4.2	168.2	161.42	6.8								
	20+79.2		161.16									
	20+82.4		158.93									
	20+95.9		158.99									
	20+99.2		161.40									
	21+09.4	169.11	161.50	7.6	EXIST. 21+09.4							