


21st St. No.



LAT 279, SW1
 468-81931 (608109)
 Built By Mid-States
 Booked 1-31-90 from Plan
 MP

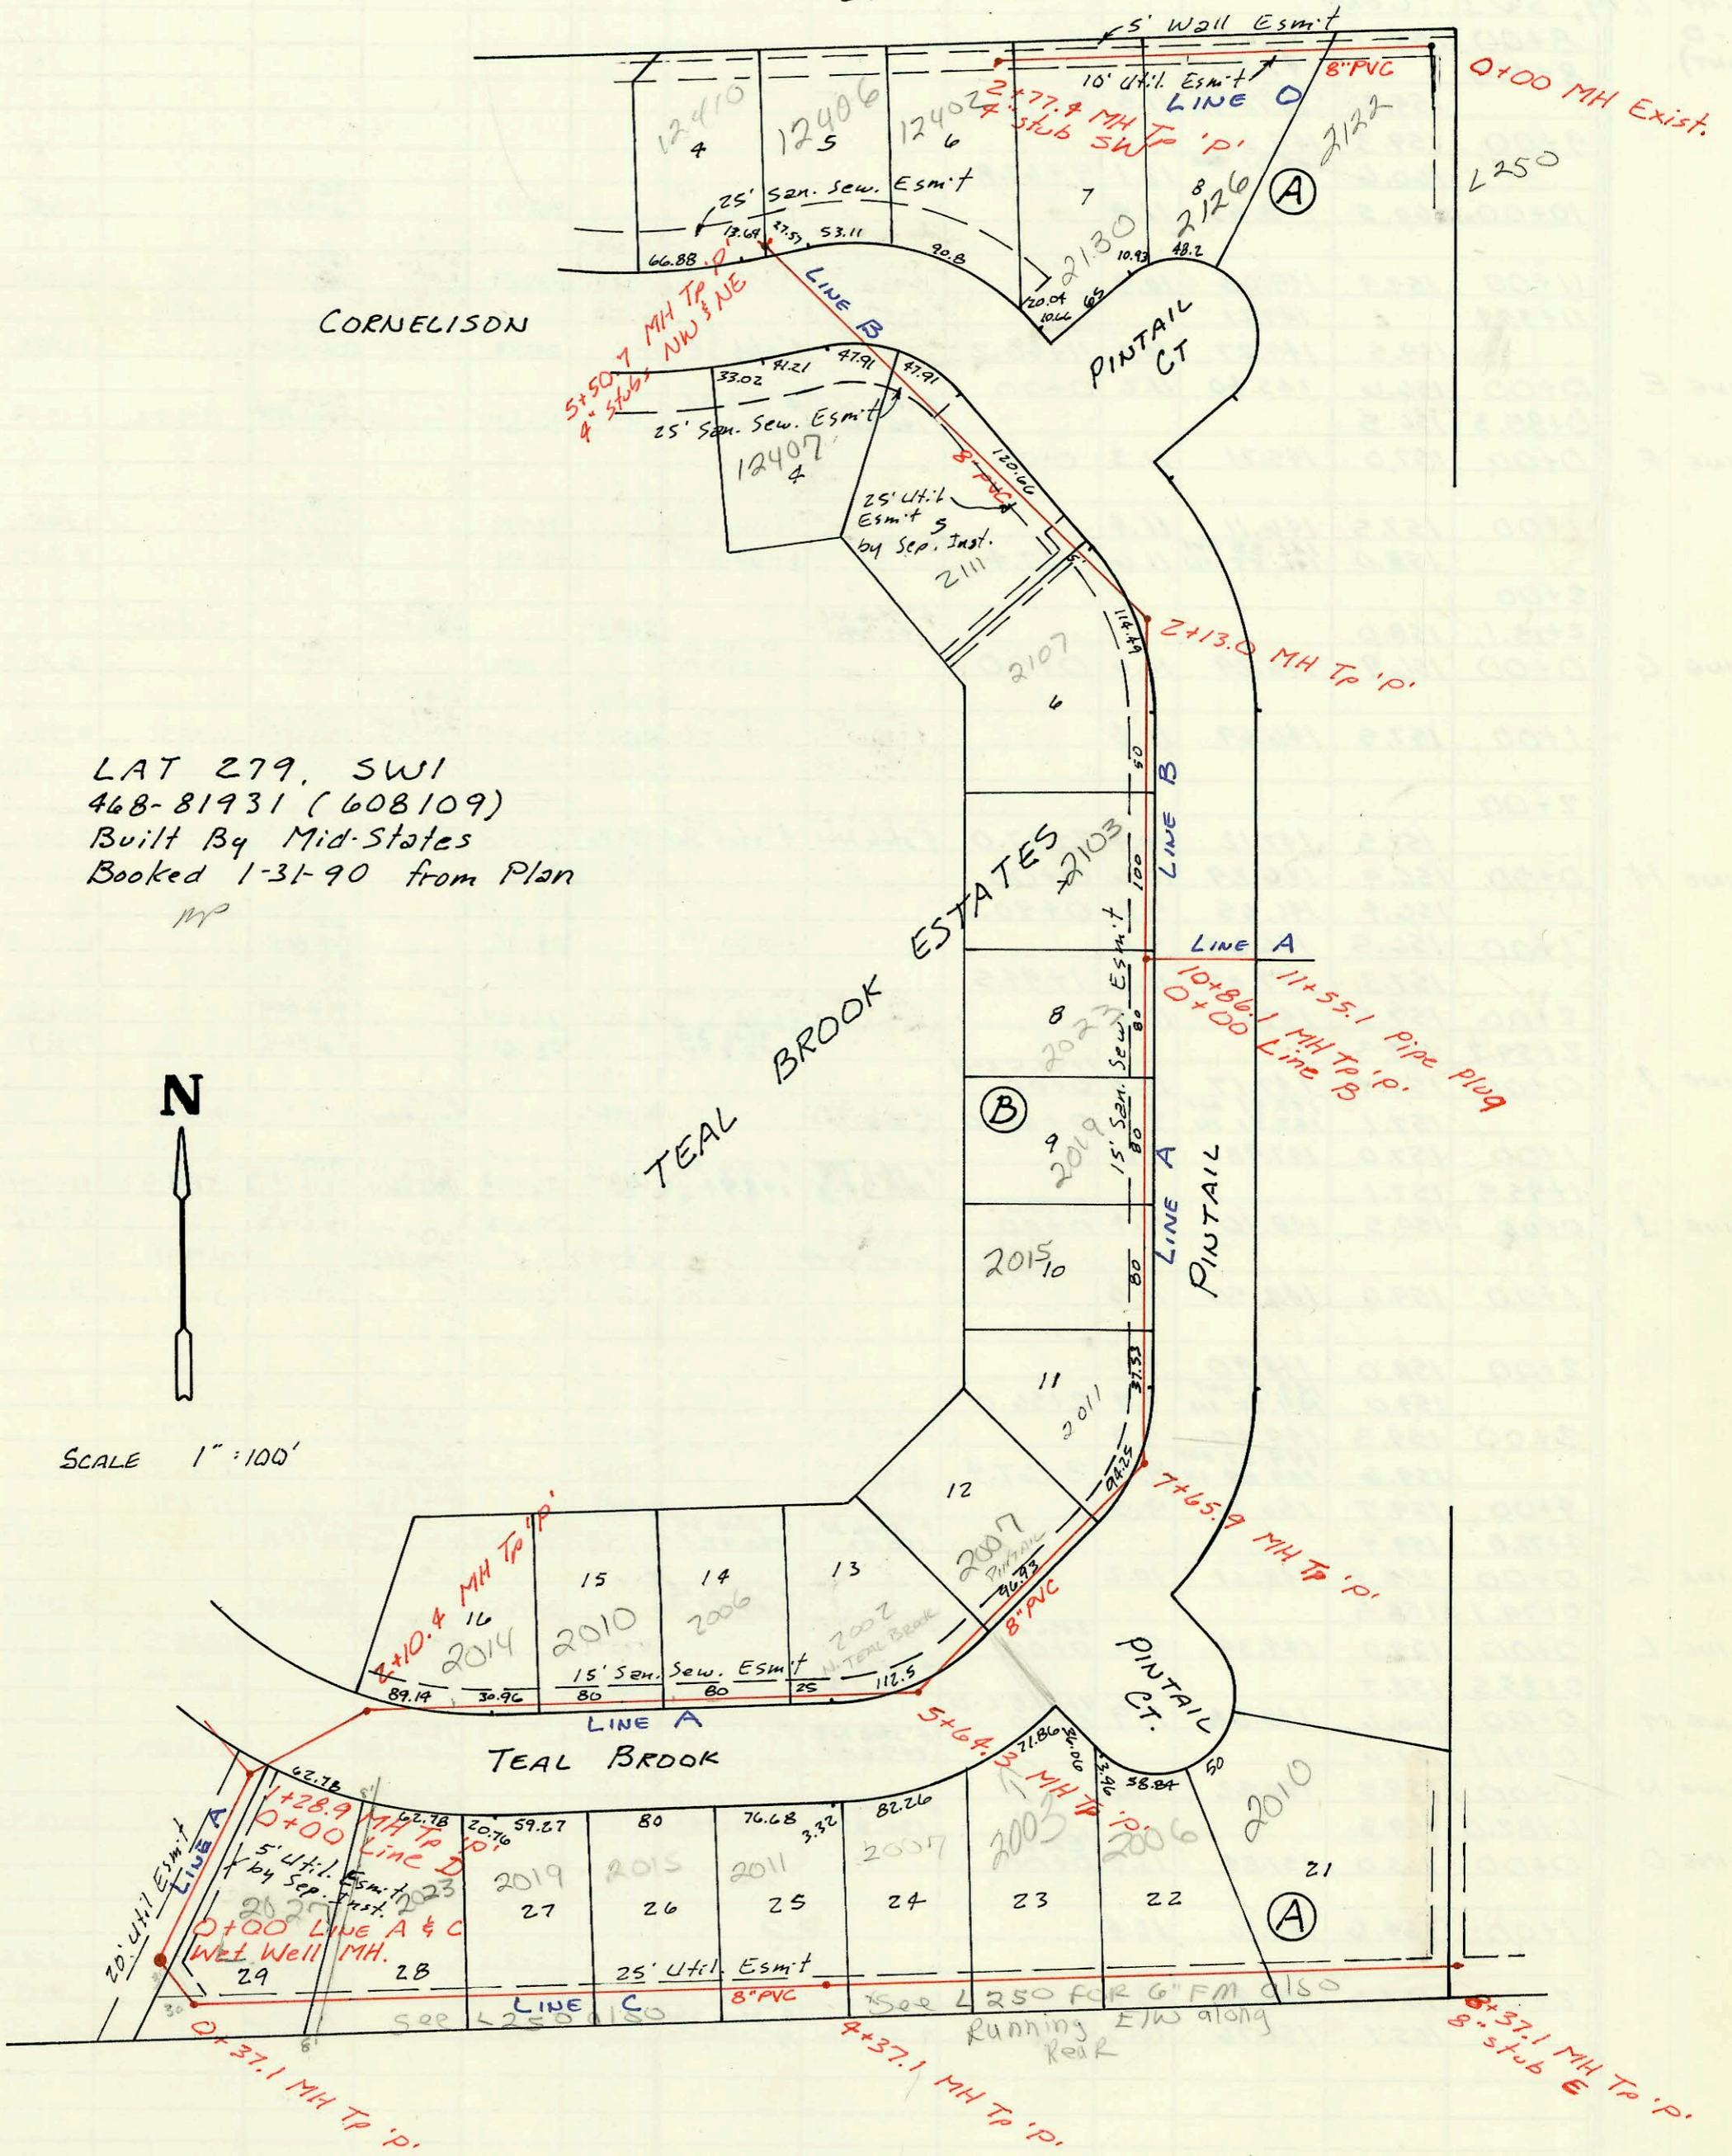

SCALE 1" = 100'

CONSTRUCTION RECORD						SERVICE RECORD						
STATION	ELEVATION		Depth	MANHOLE	4-INCH "Y" BRANCHES		No. of Permit		House Number		DATE OF PERMITS	
	Ground	Grade			North West	South East	North West	South East	North West	South East	North West	South East
LAT 27° 9' SW I												
LINE A												
0+00	158.00	143.88	14.1	0+00								
1+00	157.5	144.28	13.2									
	157.84	144.40 OUT 144.50 IN	13.4	1+28.9 0+00 L-D								
2+00		144.91 OUT 145.01 IN	13.2	2+10.4								
3+00	158.8	145.31	13.5		2+65 4" Riser NW 150.7		91-26975-7		2004 Teal Break		7-15-91	
					3+30 4" Riser N 150.9		91-37427-7		2010 Teal Break		11-14-91	
4+00	159.5	145.65	13.9		4+10 4" Riser N 151.7		26123		2006 Teal Break		9-12-90	
					4+90 4" Riser N 152.0		25901		2002 Teal Break		8-2-90	
5+00	160.3	145.99	14.3									
	160.7	146.21 OUT 146.31 IN	14.5	5+64.3								
6+00	161.0	146.42	14.6									
					6+33 4" Riser NW 153.5		21296		2007 Pintail		11-15-89	
7+00	161.5	146.72	14.8		7+25 4" Riser NW 153.3		92-67357		2011 Pintail		5-8-92	
	160.9	146.91 OUT 147.01 IN	14.0	7+65.9								
8+00	160.6	147.12	13.5									
					8+60 4" Riser W 152.3		26592		2015 Pintail		11-21-90	
9+00	160.1	147.44	12.7									
10+00	159.5	147.76	11.7									
	159.1	148.03 OUT 148.13 IN	11.1	10+86.1	10+02.1 TAP 4" SDR 35		91-26513-7		2019 Pintail		7-9-91	
					10+43.1 TAP		91-36046-7		2023 Pintail		10-23-91	
11+00												
LINE B												
0+00	159.1	148.03	11.1	0+00	0+35.0 TAP		25421		2103 Pintail		5-29-90	
1+00	159.5	148.35	11.2									
2+00		148.71 OUT 148.81 IN	11.3	2+13.0	SDR 35 2+49.0 TAP		91-36217-7		2107 Pintail		8-19-91	
3+00	160.0	149.09	10.9									
					3+41.0 TAP		26900		2111 Pintail		1-22-91	
4+00	160.1	149.41	10.7									
					4+61.9 TAP		24886		12401 CORNUSSION		3-2-90	
5+00	159.3	149.73	9.6									
	159.9	149.89	10.0	5+50.7	SDR 35 4" stub NW	4" stub NE	91-32195-7	26797	12410 CORNUSSION	12406 CORNUSSION	9-10-91	10-24-90
0+00	158.0	148.78	11.2									
	154.4	147.00 OUT 149.00 IN	5.4	0+37.1	0+91.1 TAP		26335		2087 Teal Break		10-17-90	
1+00	156.2	149.30	6.9									
					1+86.1 TAP		26305		2003 Teal Break		10-11-90	
2+00	159.6	149.78	9.8									
					2+58.1 TAP		21526-7		2019 Teal Break		4-20-91	
3+00	161.5	150.26	11.2									
4+00	162.5	150.74	11.8									
	163.4	150.92	12.5	4+37.1	SDR 35 4+21.1 TAP		91-22814-7		2015 Teal Break		10-1-90	
5+00	163.2	151.17	12.0									
					4" PVC 40 5+16.1 TAP		92953-7		2007 Teal Break		1-15-92	
					5+79.7 TAP		25010		2003 Teal Break		3-28-90	
6+00	163.6	151.57	12.0									
					4" SDR 35 TAP 76' W of ETL		91-32817-7		2006 Pintail		9-17-91	
7+00	163.8	151.97	11.8		7+36.1 TAP		26331		2010 Pintail		10-16-90	
8+00	163.9	152.37	11.5									
	164.4	152.52	11.9	8+37.1		8" stub E						
LINE C												
0+00	157.84	144.50	13.3	0+00								
1+00	156.7	144.80	11.9									
2+00	155.9	145.10	10.8									
	156.6	145.23	11.4	0+00 L-E 2+43.6								
3+00	156.7	145.40	11.3									
	157.0	145.61	11.4	0+00 L-F 3+70.3	3+12.6 TAP		26243		2087 Teal Break		9-27-90	
4+00	156.2	145.70	10.5									
5+00	156.8	146.00	10.8									
	156.9	146.19	10.7	5+64.5								
6+00	156.9	146.40	10.5		4" SDR 6+02.5 TAP		91-32532-7		2103 Teal Break		12-3-91	
7+00	157.1	146.98	10.1									