


21st ST. NO.

8333
w. 21st
ALL STAR
SPORTS
CENTEK

8081
church


LAT 5, MAIN 15, SWI
468-81815 (740076)
Built By Stannard Const.
Booked 2-5-90 from Plan

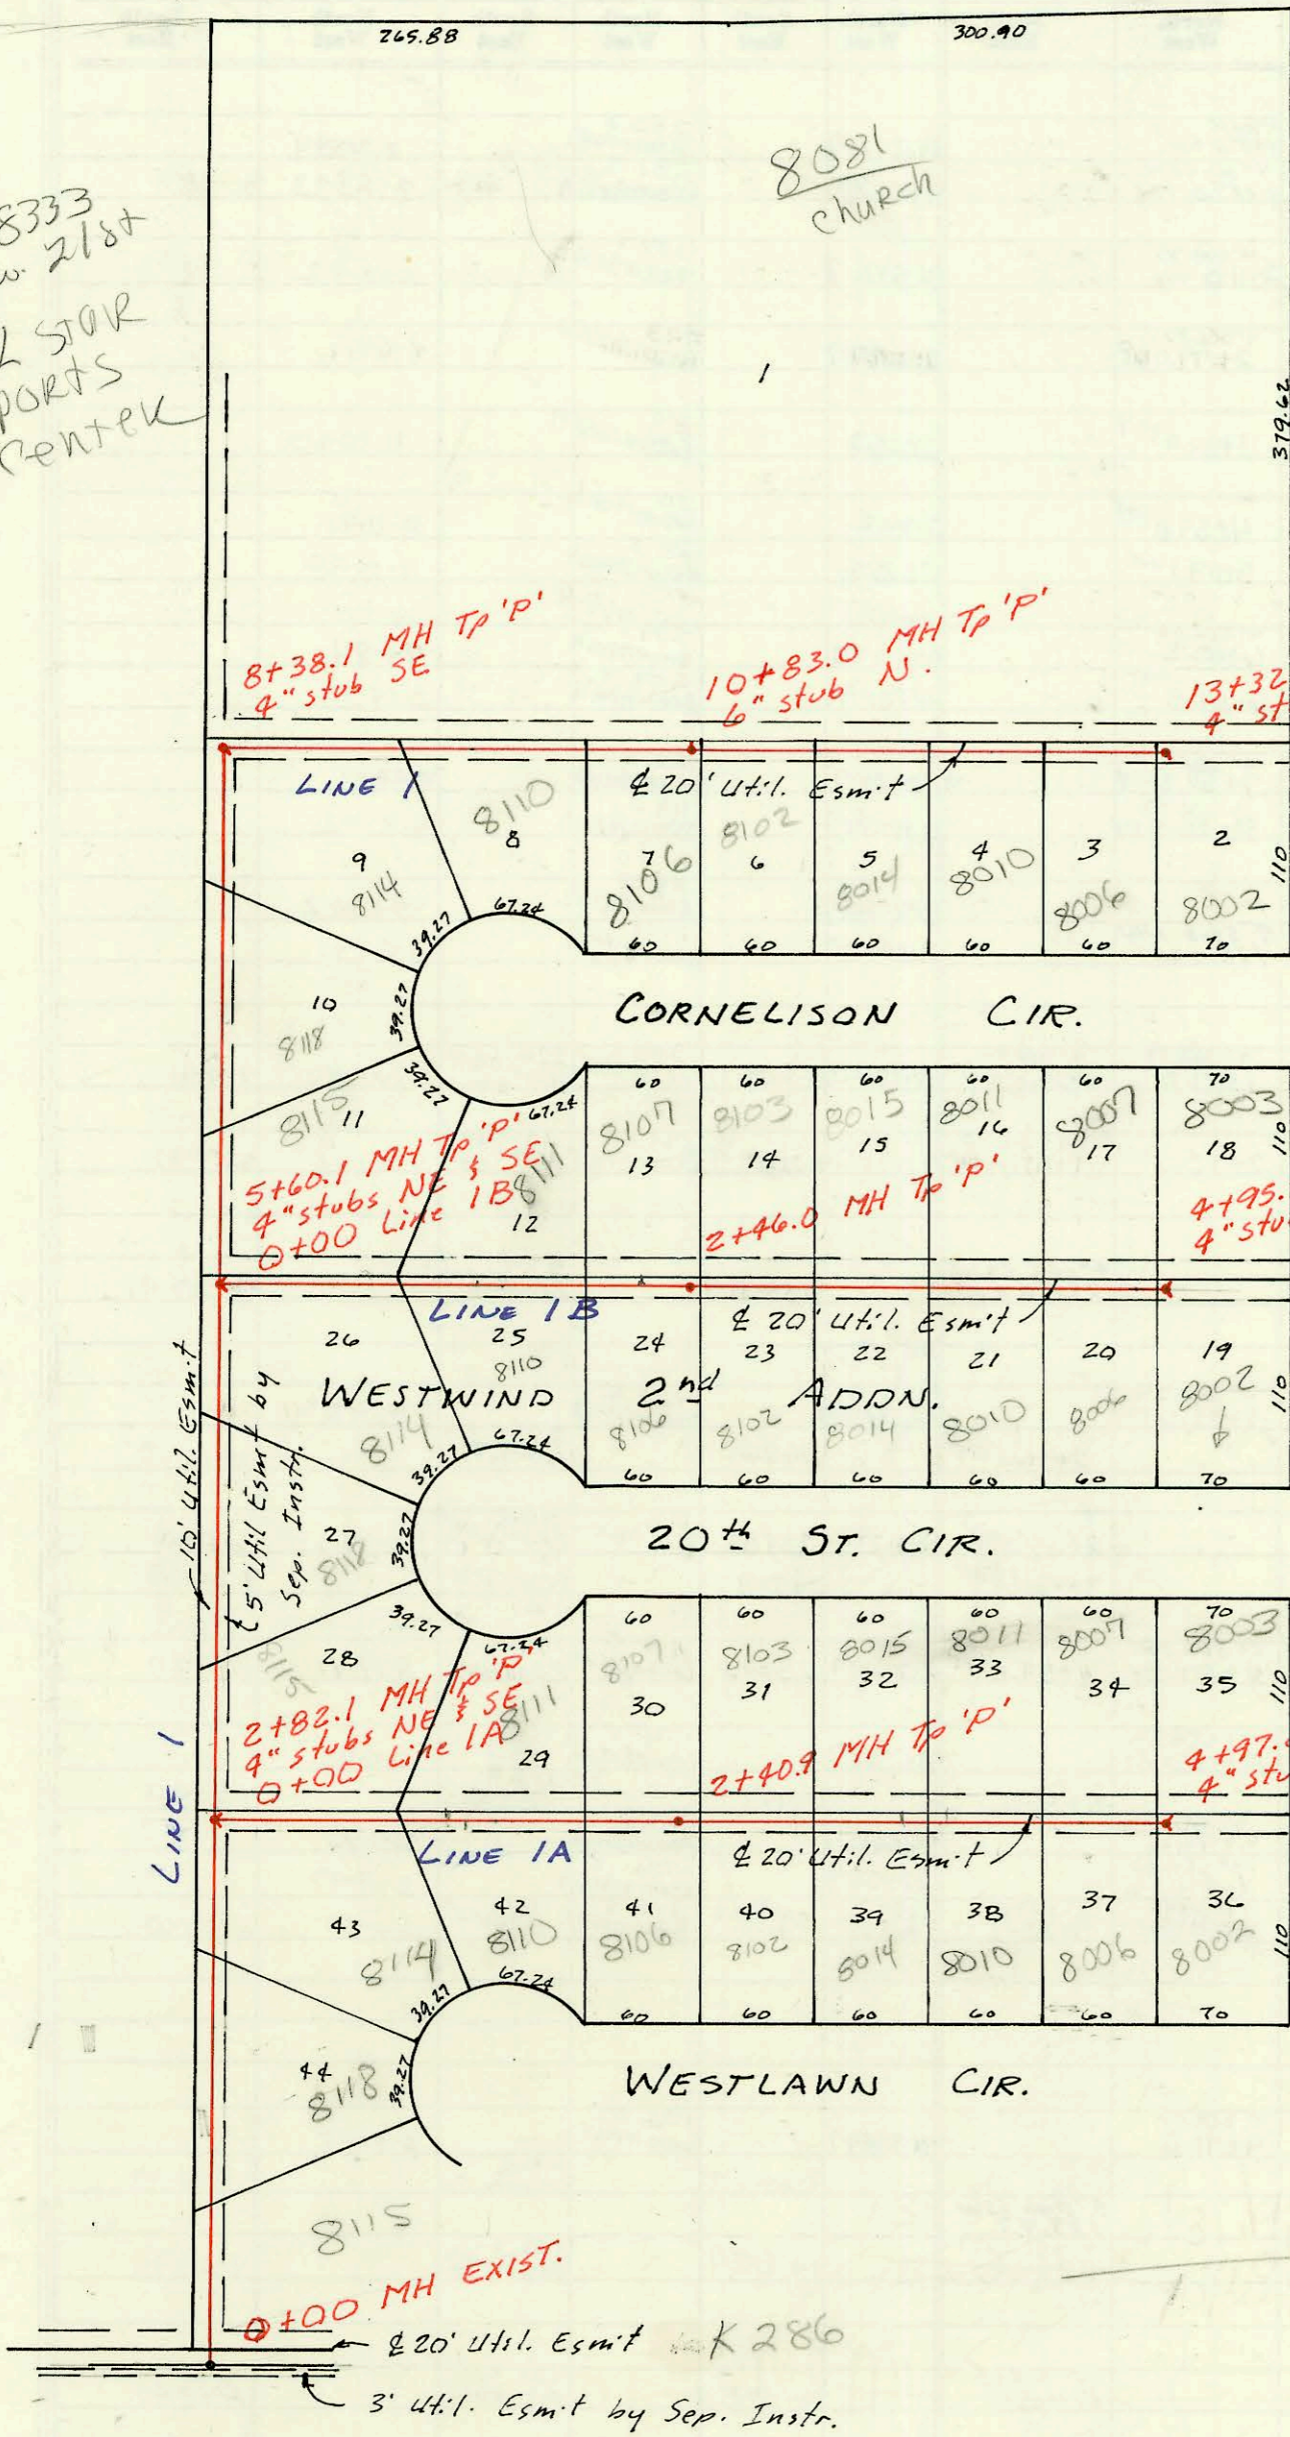

SCALE 1"=100'

Priv. San. Sewer to serve part of
Lot 14, Sherwood Glen 5th Addn.
217 PPS Built By McCullough Exc.
Booked 2-13-90 from As Built Plan

WMP

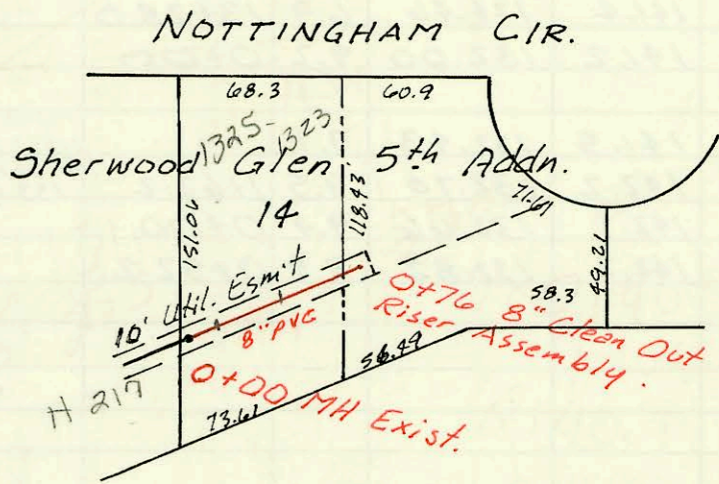

SCALE 1"=80'

CONSTRUCTION RECORD						SERVICE RECORD						
STATION	ELEVATION		Depth	MANHOLE	4-INCH "Y" BRANCHES		No. of Permit		House Number		DATE OF PERMITS	
	Ground	Grade			North West	South East	North West	South East	North West	South East	North West	South East
LAT 5, LINE 1												
0+00	160.1	144.61	15.5	EXIST 0+00								
1+00	159.5	144.93	14.6			0+30 4" Riser E 151.21	24446		8115 W 20th CL			12-11-89
2+00	159.3	145.24	14.1			1+25 4" Riser E 150.51	24477		8118 W 20th CL			2-11-89
3+00	159.4	145.50	13.9	0+00 L-1A 2+82.1	4" stub NE 149.50	4" stub SE 149.50	25867		8115 W 20th			7-27-90
4+00	160.4	145.87	14.5			4+00 4" Riser E 151.35	26134		8118 W 20th CL			9-14-90
5+00	159.7	146.17	13.5									
6+00	159.2	146.47	12.7	0+00 L-1B 5+60.1	4" stub NE 149.00	4" stub SE 149.00	25502		8114 W 20th CL			6-8-90
7+00	159.5	146.77	12.7			6+75 4" Riser E 150.69	25908		8118 see below CORNELISON			8-2-90
8+00	159.9	147.07	12.8									
9+00	160.0	147.27	12.8	8+38.1		4" stub SE 150.00	27014	8333 W 21st	8114 CORNELISON	8115 CORNELISON	8-4-98	2-5-91
10+00	159.5	147.76	11.7									
11+00	159.5	148.00	11.4	10+83.0	6" stub N 152.00	4" stub SE 10+75.0 TAP	24450	91-31767 W 21st N	8081 W 21st N	8106 CORNELISON	12-11-89	8-26-91
12+00	159.3	148.06	11.2			4" stub SE 11+32.6 TAP	92-2398-7		8102 CORNELISON			2-20-92
13+00	159.1	148.36	10.7			11+68.0 TAP	25930		8074 CORNELISON			8-8-90
14+00	159.0	148.66	10.3			12+28.2 TAP	25929		8070 CORNELISON			8-8-90
15+00	159.0	148.75	10.3	13+32.2		12+37.2 TAP	24889		8002 CORNELISON			3-5-90
16+00	159.4	149.60	13.8	0+00		4" stub SE 149.00	24582		8002 CORNELISON			1-9-90
17+00	158.8	145.90	12.9			0+86.0 TAP	24477		8114 W 20th CL			12-19-89
18+00	158.2	146.20	12.0			1+20 4" Riser N 149.96	25760	25062	8111 W 20th CL	8113 W 20th CL	7-18-90	4-4-90
19+00	158.0	146.32	11.7	2+40.9		2+07.9 TAP	26100	25763	8107 W 20th CL	8106 W 20th CL	9-10-90	7-18-90
20+00	157.7	146.50	11.2			2+76.9 TAP	26427	26728	8103 W 20th CL	8102 W 20th CL	1-24-91	12-11-90
21+00	157.8	146.80	11.0			3+53.8 TAP	26365	26352	8005 W 20th CL	8074 W 20th CL	10-22-90	1-10-90
22+00	157.8	146.80	11.0			4+05.3 TAP	24617	25158	8011 W 20th CL	8070 W 20th CL	1-10-90	4-17-90
23+00	156.9	147.09	9.8	4+97.8		4+72.8 TAP	26647	21327-7	8007 W 20th CL	8006 W 20th CL	11-30-90	4/23/91
24+00	159.0	146.44	12.6	0+00		4" stub NE 147.42	74769	26787	8003 W 20th	8002 W 20th	2-6-90	12-19-90
25+00	159.0	146.74	12.3			0+77.0 TAP	26015		8115 CORNELISON			6-8-90
26+00	158.9	147.04	11.9			1+35.0 TAP	92-2337	26787	8111 W 20th CL	8110 W 20th CL	3-4-92	12-11-90
27+00	158.8	147.17	11.6	2+46.0		2+18.0 TAP	24983	25865	8101 CORNELISON	8106 W 20th CL	3-21-90	7-26-90
28+00	158.7	147.34	11.4			2+92.0 TAP	26542	26554	8103 CORNELISON	8102 W 20th CL	11-14-90	11-15-90
29+00	158.3	147.64	10.7			3+56.0 TAP	92-49287	26480	8013 CORNELISON	8014 W 20th CL	4-8-92	11-7-90
30+00	157.9	147.93	10.0	4+95.9		4+03.9 TAP	19385-7	24982	8011 CORNELISON	8010 W 20th CL	2-23-91	8-21-90
31+00	157.9	147.93	10.0			4+75.9 TAP	25260	26135	8007 CORNELISON	8006 W 20th CL	5-2-90	9-14-90
32+00	132.72	126.77	6.0	EXIST 0+00		4" stub NE 148.26	24449	26028	8003 CORNELISON	8002 W 20th CL	12-11-89	8-27-90
Priv. San Sewer for part Lot 14, Sherwood Glen 5 th Addn.												
0+00	132.72	126.77	6.0	EXIST 0+00		0+11 4" WYE N	2001- 01296		1325 Nottingham			5-29-01
0+76	131.90	127.06	4.8			0+42 4" WYE N 0+71 4" stub N	2001- 01281		1323 Nottingham			5-24-01

25908-8/2/90 8118 W. CORNELISON Ch - Records show size to be 163.1" S. of MH 8138.1
 However INSPECTOR'S meas wa 138.1" S. of MH 8138.1 -