
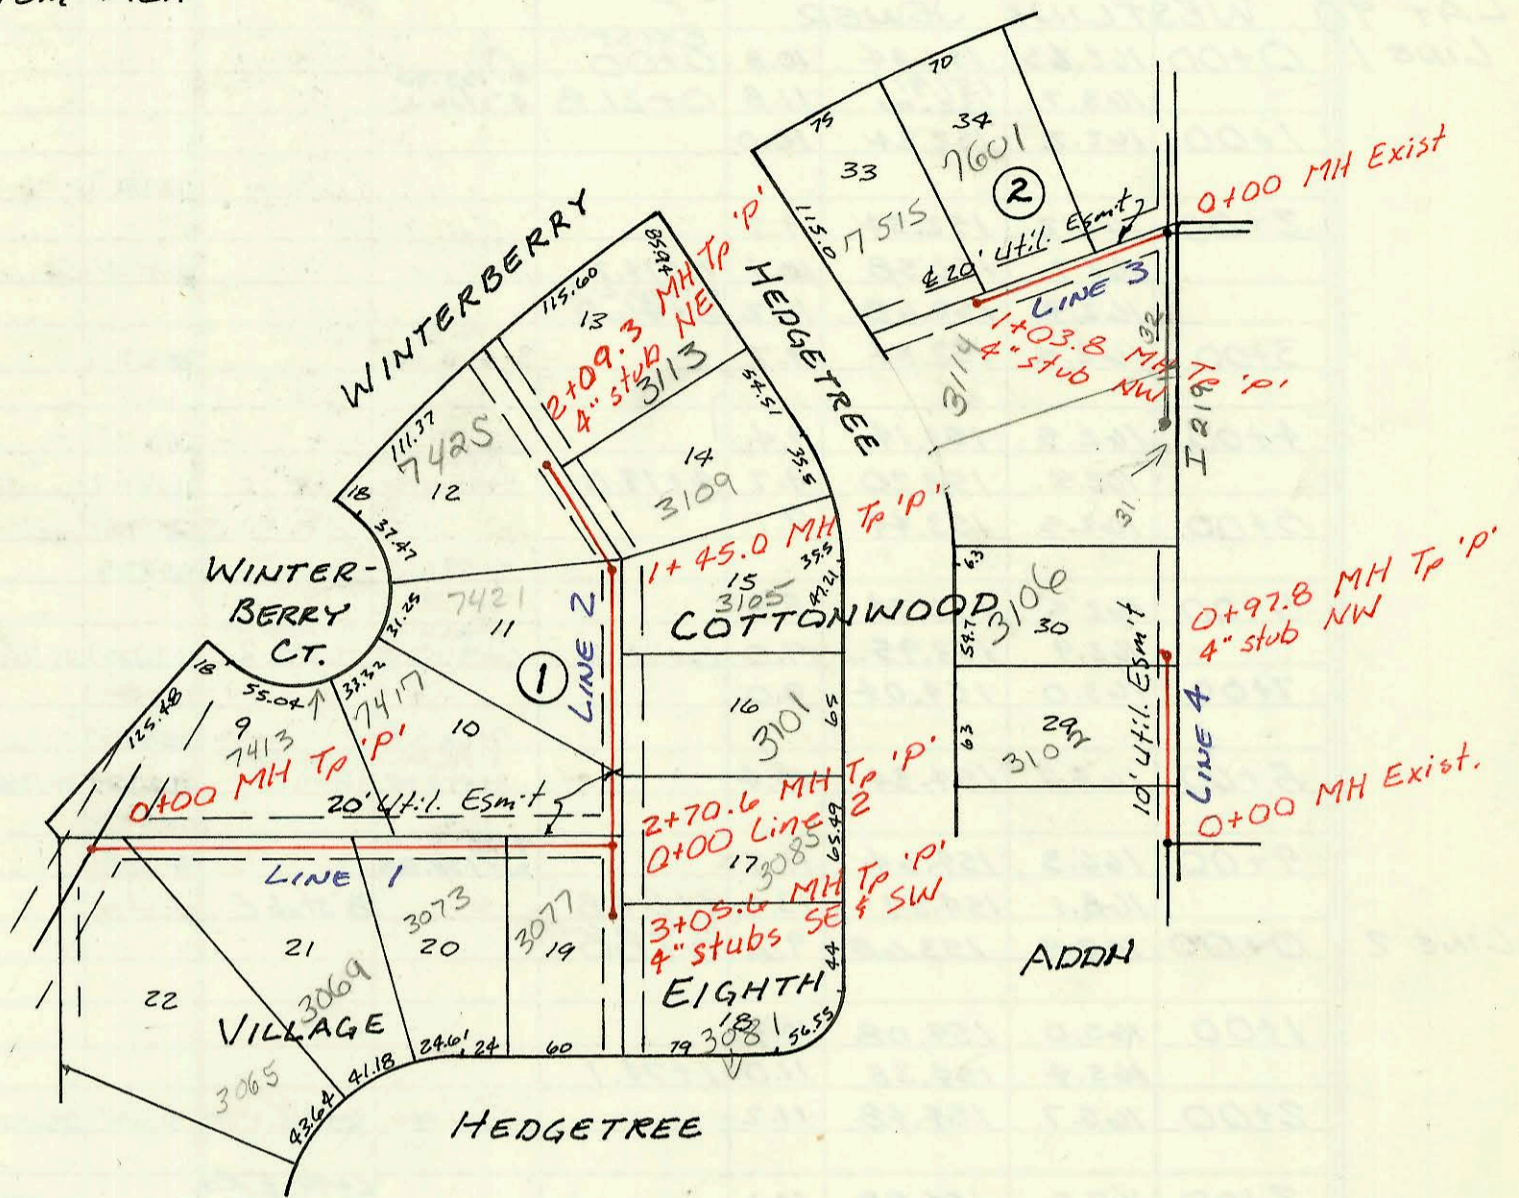




LAT 44, MAIN 7, S.S. # 23
 468-81812 (740233)
 Built By Mid States Const.
 Booked 4-4-90 from Plan

PP

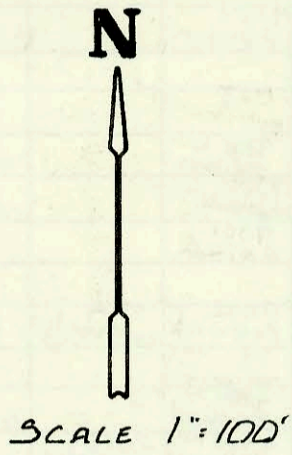

LAT 19, MAIN 13, W.I.S.
 468-81972 (740191)
 BUILT BY WILDCAT CONST.
 Booked 4-5-90 from Plan

PP

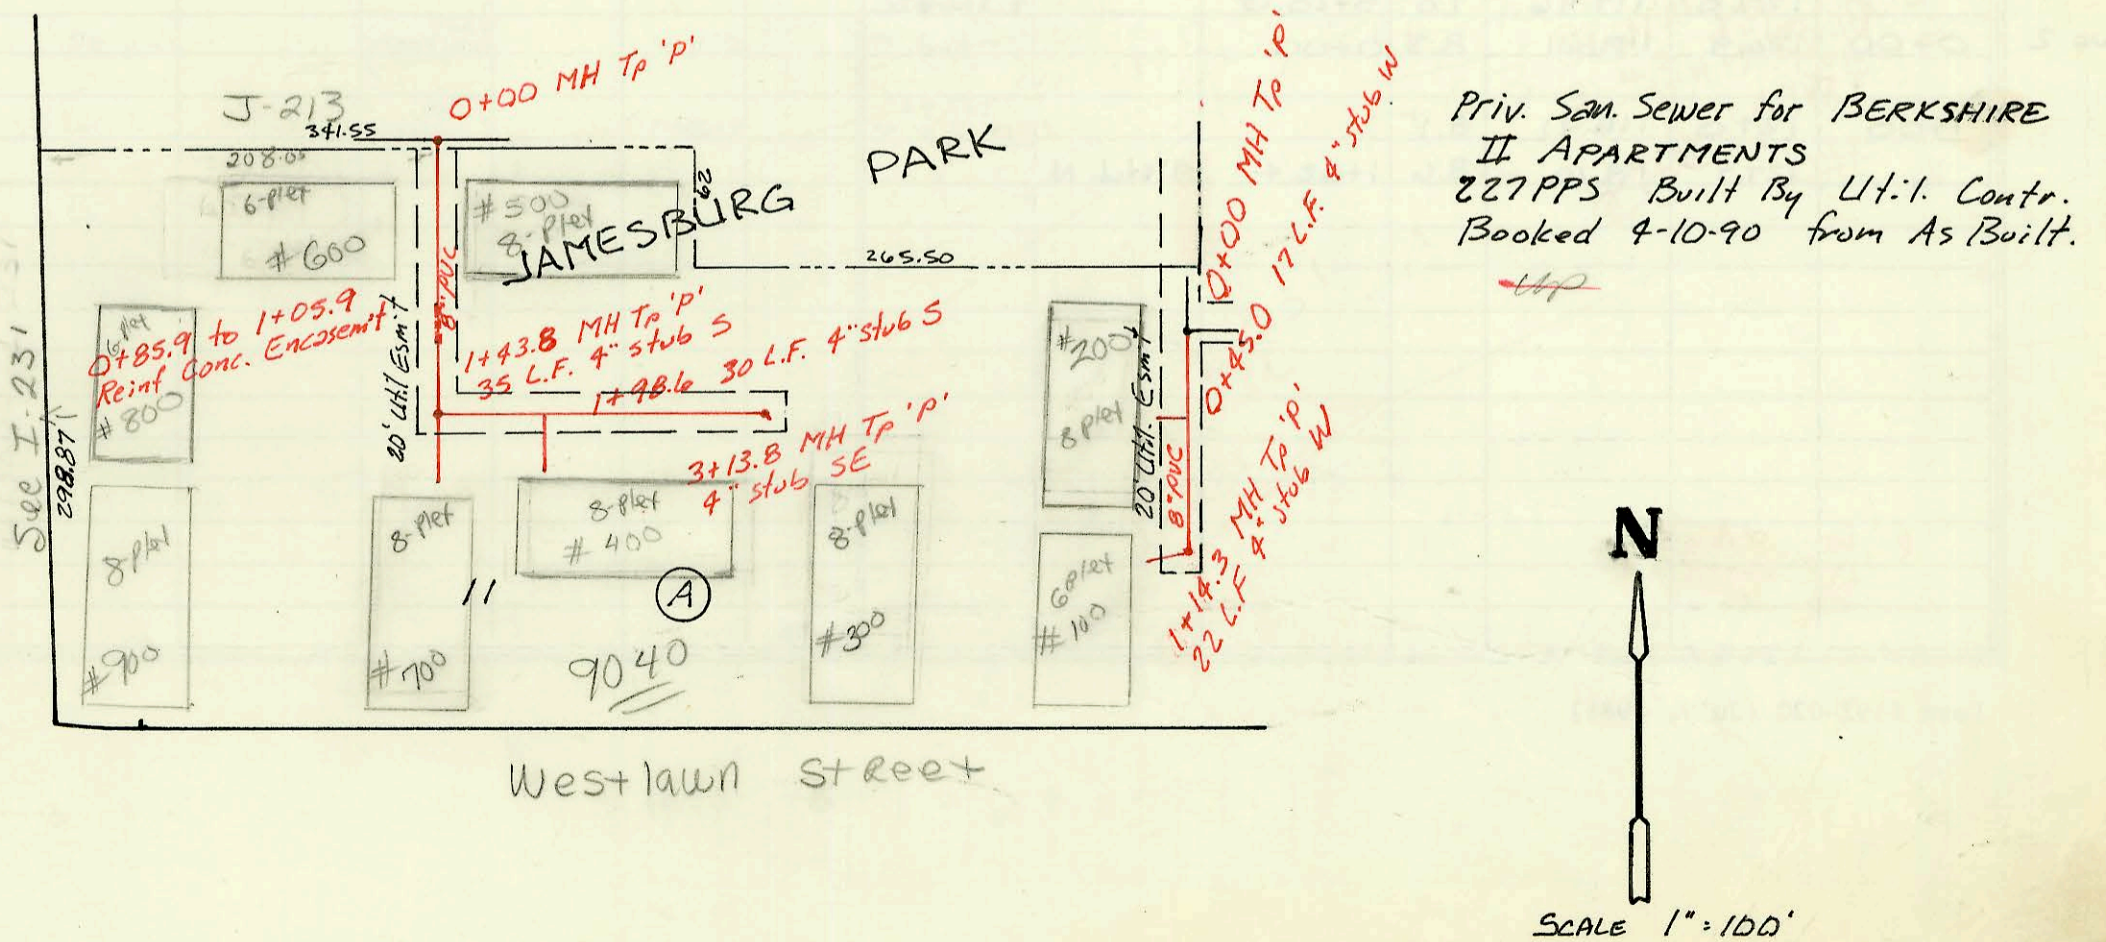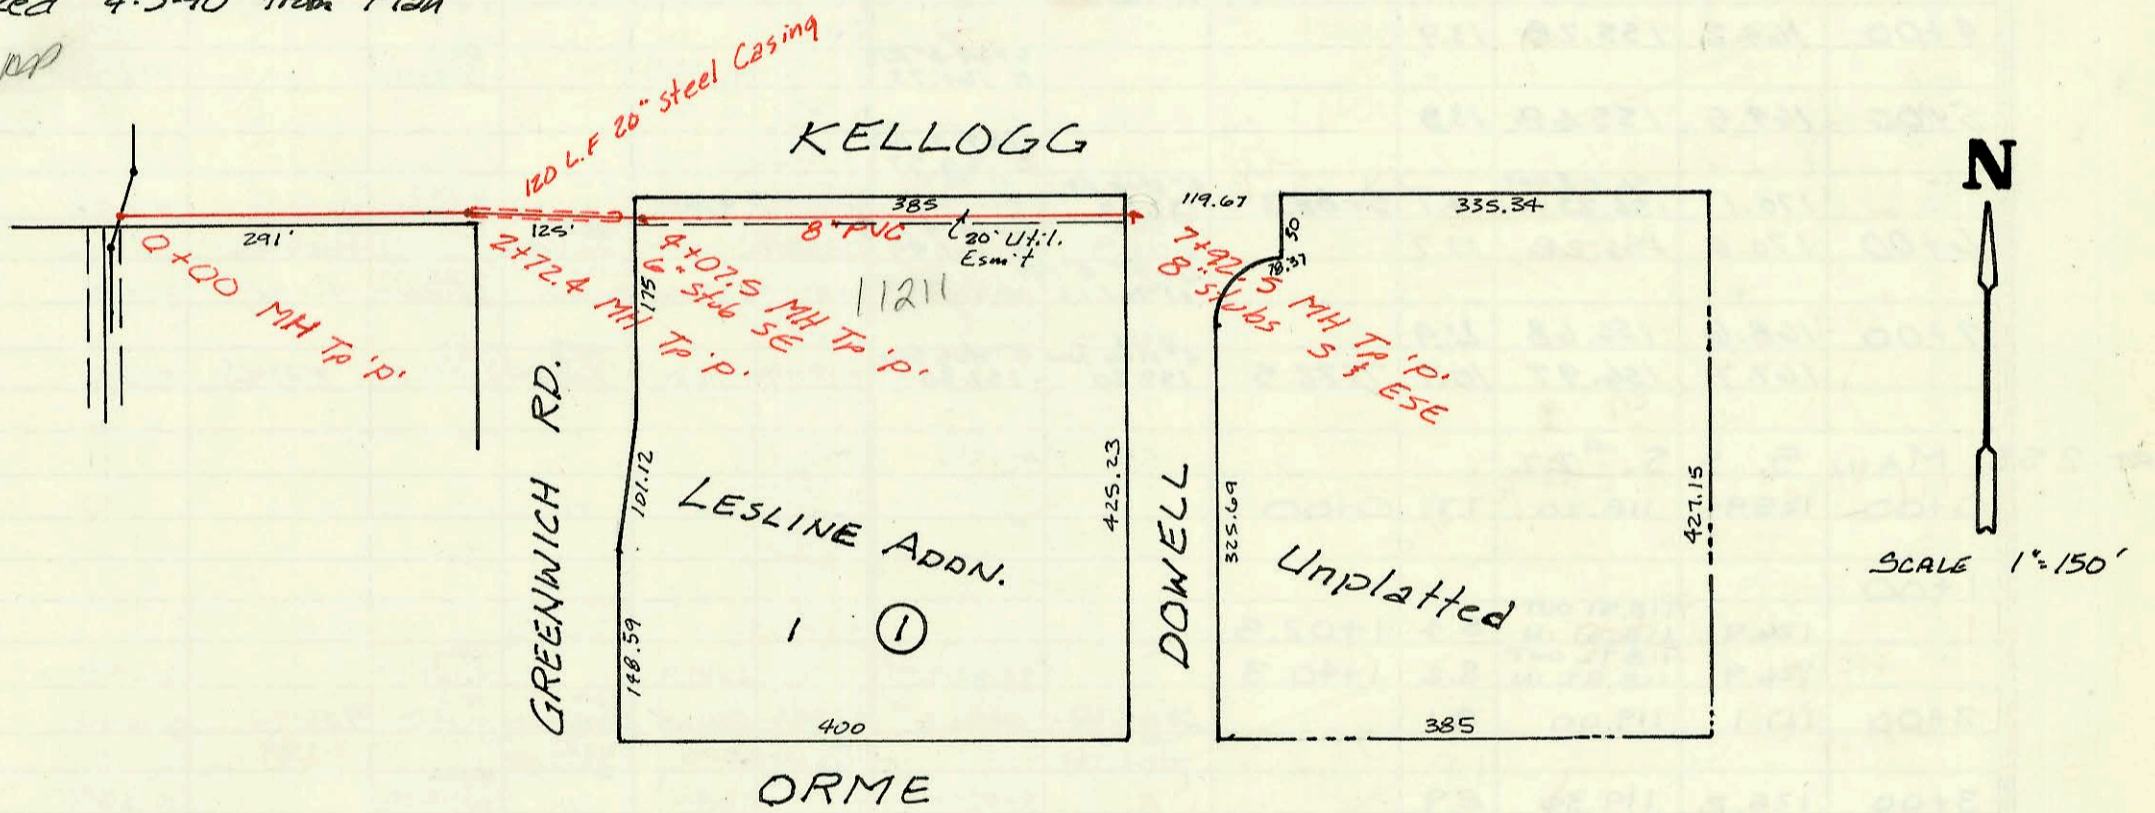

Priv. San. Sewer for BERKSHIRE
 II APARTMENTS
 227 PPS Built By Ut. I. Contr.
 Booked 4-10-90 from As Built.

PP

CONSTRUCTION RECORD							SERVICE RECORD						
STATION	ELEVATION		Depth	MANHOLE	4-INCH "Y" BRANCHES		No. of Permit		House Number		DATE OF PERMITS		
	Ground	Grade			North West	South East	North West	South East	North West	South East	North West	South East	
LAT 44, MAIN	7, S.S. #23												
LINE 1	0+00	195.00	183.00	12.0	0+00	0+87.6	0+06.0 top	20694	26345	7413 winterbeck	3065 Hedge tree	4-19-91	10-19-90
	1+00	195.8	184.00	11.8									
	2+00	197.0	185.00	12.0									
		198.20	185.81 IN	12.5	0+00 L-2	2+40.6 top	2+58.6 top	91-36577	91-241817	7417 winterbeck	3073 Hedge tree	11-1-91	6-14-91
	3+00												
		197.50	186.16	11.3	3+05.6	4" stub SW R 186.50	4" stub SE R 186.50				3081 Hedge tree		10-4-90
LINE 2	0+00	198.20	185.81	12.4	0+00								
	1+00	199.0	186.81	12.2									
		199.80	187.26 OUT 187.36 IN	12.5	1+45.0	1+96.0 top	1+27.0 top	24794	26957	7425 winterbeck	3105 Hedge tree	2-12-90	1-29-91
	2+00	199.0	187.91	11.1									
		199.00	188.00	11.0	2+09.3	4" stub NE R 188.33	4" stub NE R 188.33		25355		3113 Hedge tree		5-18-90
LINE 3	0+00	201.40	190.00	11.4	0+00								
	1+00												
		200.40	190.52	9.9	1+03.8	4" stub NW R 190.85		91-20657		7601 winterbeck		4-13-90	
LINE 4	0+00	199.32	190.00	9.3	0+00	0+46.8 top		26672		7425 winterbeck	3102 Hedge tree	12-4-90	
		200.40	190.49	9.9	0+97.8	4" stub NW R 190.82		91-38405		7601 winterbeck	3106 Hedge tree	12-3-91	
LAT 19,	MAIN 13, W 15												
	0+00	159.88	144.00	15.9	0+00								
	1+00	160.3	144.40	15.9									
	2+00	161.7	144.80	16.9									
		162.2	145.09	17.1	2+72.4								
	3+00	163.0	145.20	17.8									
	4+00	162.9	145.60	17.1									
		163.40	145.63	17.8	4+07.5		6" stub SE R 156.00		24281		11211 Kelllogg		11-14-89
	5+00	163.7	146.00	17.7									
	6+00	165.0	146.40	18.6									
	7+00	166.3	146.80	19.5									
		168.3	147.17	21.1	7+92.5		8" stub S 8" stub ESE						
Priv. Sew.	Sewer for Berkshire Apartments												
	0+00	161.10	151.55	9.6	0+00								
	1+00	158.7	151.99	6.7									
		159.20	152.28 OUT 152.28 IN	7.1	1+43.8		4" stub S R 155.50		25552		9040 westlawn		6-15-90
	1+98.6						4" stub S R 155.50		25549		9040 westlawn		6-15-90
	2+00	159.5	153.13	6.4									
	3+00	160.0	154.63	5.4									
		160.34	154.84	5.5	3+13.8		4" stub SE R 155.54		25187		9040 westlawn		4-12-90
	0+00	161.83	155.03	6.8	0+00								
	0+45.0						4" stub W R 157.44		25126		9040 westlawn		4-12-90
	1+00	163.8	156.04	7.8									
		164.09	156.19	7.9	1+14.3		4" stub SW R 158.00		25125		9040 westlawn		4-12-90