


LAT 90, WESTLINK SEWER
468-81938 (740142)
Built By Utility Contr.
Booked 5-1-90 from Plan.

MP

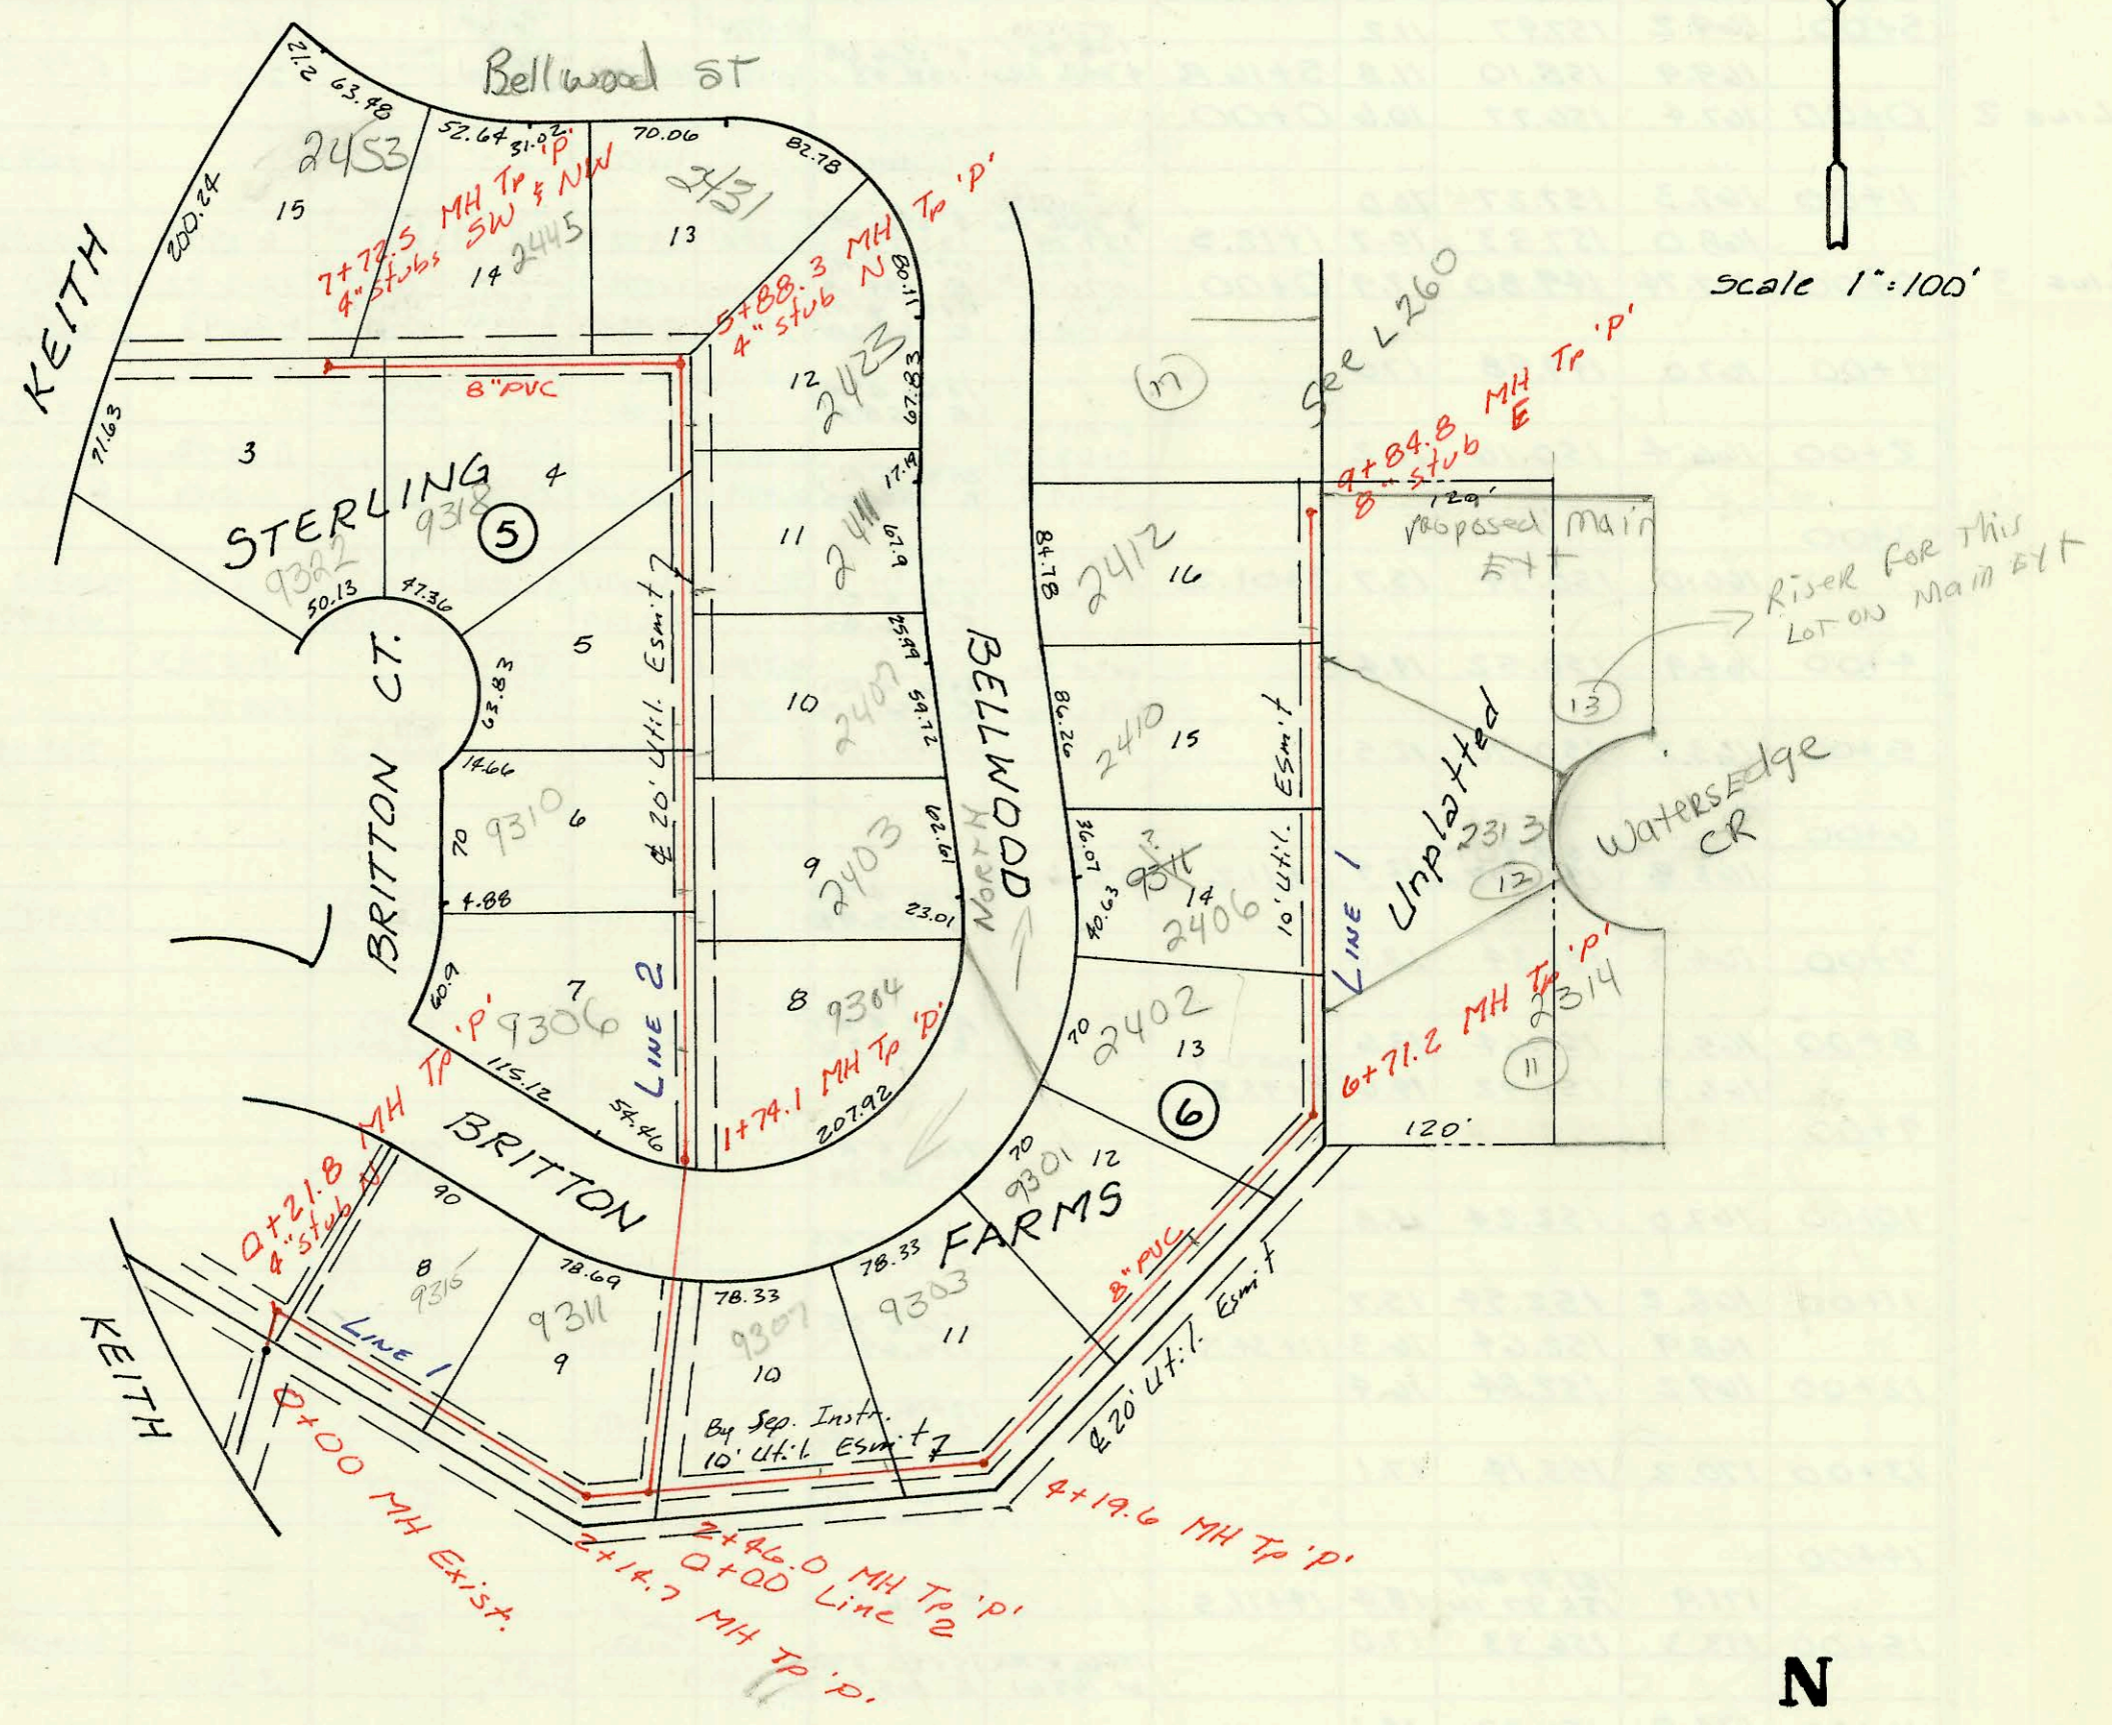


Scale 1"=100'



Scale 1"=150'

LAT 255, MAIN 5, S.S # 22
468-82016 (740282)
Built By Standard Const.
Booked 6-8-90 from Plan

MP

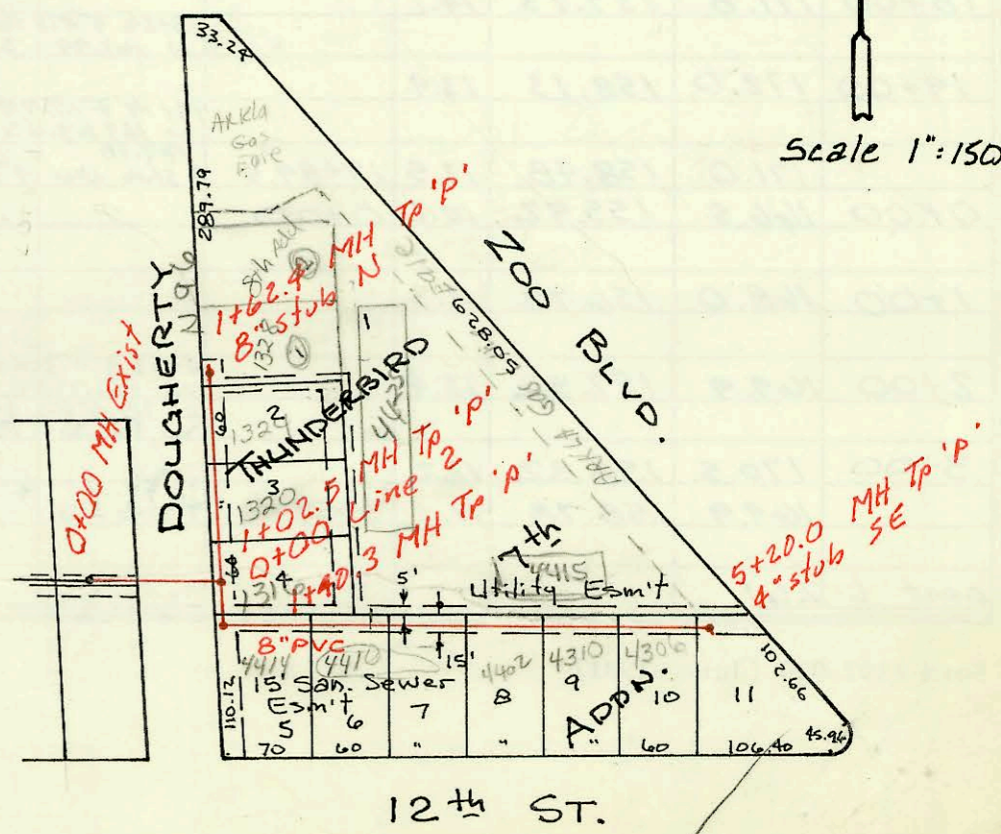

12th St.

CONSTRUCTION RECORD							SERVICE RECORD						
STATION	ELEVATION		Depth	MANHOLE	4-INCH "Y" BRANCHES		No. of Permit		House Number		DATE OF PERMITS		
	Ground	Grade			North West	South East	North West	South East	North West	South East	North West	South East	
LAT 90, WESTLINK SEWER													
LINE 1 0+00	162.63	151.84	10.8	EXIST									
	163.7	151.91	11.8	0+21.8	4" stub N								
1+00	162.2	152.24	10.0										
2+00	162.2	152.54	9.7					26920-7	9315	Britton		7-15-91	
	162.7	152.58	10.1	2+14.7	4" SDR 35	1499.1 tap		9311	W	Britton		8-31-93	
	162.9	152.68	10.2	2+46.0									
3+00	162.5	152.84	9.7		4" SDR 35	3+61.0 tap			9307	Britton		3-12-92	
	162.5	153.14	9.4										
4+00	162.9	153.20	9.7	4+19.6	4" pvc 40	4+45.6 tap			9303	W	Britton		7-15-91
	162.5	153.44	9.1						9301	Britton		5-19-90	
6+00	162.5	153.74	8.8										
	162.9	153.95	9.0	6+71.2	4" pvc 40	6+85.2 tap	4" sch 40 pvc	6+76.2	9316	2514	Bellwood	Watersedge	7-23-92
7+00	163.0	154.04	9.0										
8+00	164.7	154.34	10.4		7+68.2	8+49.2 tap	4" sch 40 pvc	8+11.8	9307	2313	Bellwood	Watersedge	5-30-91
	166.3	154.64	11.7		9+25	4" R/S	W/158.88						1-27-94
LINE 2 0+00	162.9	153.68	9.2	0+00									
	165.0	154.08	10.9										
1+00	165.4	154.38	11.0	1+74.1									
	165.7	154.48	11.2		4" SDR 35	2+31.1 tap		9318	W	Britton		12-6-93	
3+00	167.5	154.88	12.6										
	169.2	155.28	13.9										
4+00	169.5	155.68	13.8										
	170.1	156.03 out	14.1	5+88.3	4" stub N	157.50	4" SDR 35	5+79.3	9316	2423	Bellwood		11-12-96
6+00	170.0	156.28	13.7		4" sch 40	6+06.9	4" sch 40 pvc	6+10.4 tap	9316	2421	Bellwood		5-29-96
	168.6	156.68	11.9		4" sch 40	6+45.4 tap	4" sch 40 pvc	6+66.3 tap	9316	2445	Bellwood		9-2-94
7+00	167.7	156.97	10.7	7+72.5	4" stub NW	157.30	4" stub SW	157.30	9316	2453	Bellwood		8-21-95
	168.1	154.89	13.2	9+84.8			8" stub E						
LAT 25 S, MAIN S, S.S. #22													
0+00	125.94	118.20	7.7	0+00									
1+00	126.9	118.51 out	8.4	1+02.5									
	126.9	118.61 in	8.2	1+40.3									
2+00	127.1	119.00	8.1										
	128.2	119.30	8.9										
3+00	127.8	119.60	8.2										
	126.9	119.90	7.0	5+20.0									
LINE 2 0+00	126.9	118.61	8.3	0+00									
	127.0	118.91	8.1										
1+00	127.7	119.10	8.6	1+62.4									
	127.1	119.10	8.6	1+62.4	8" stub N								