

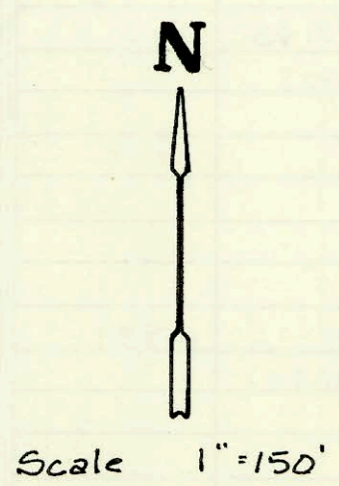
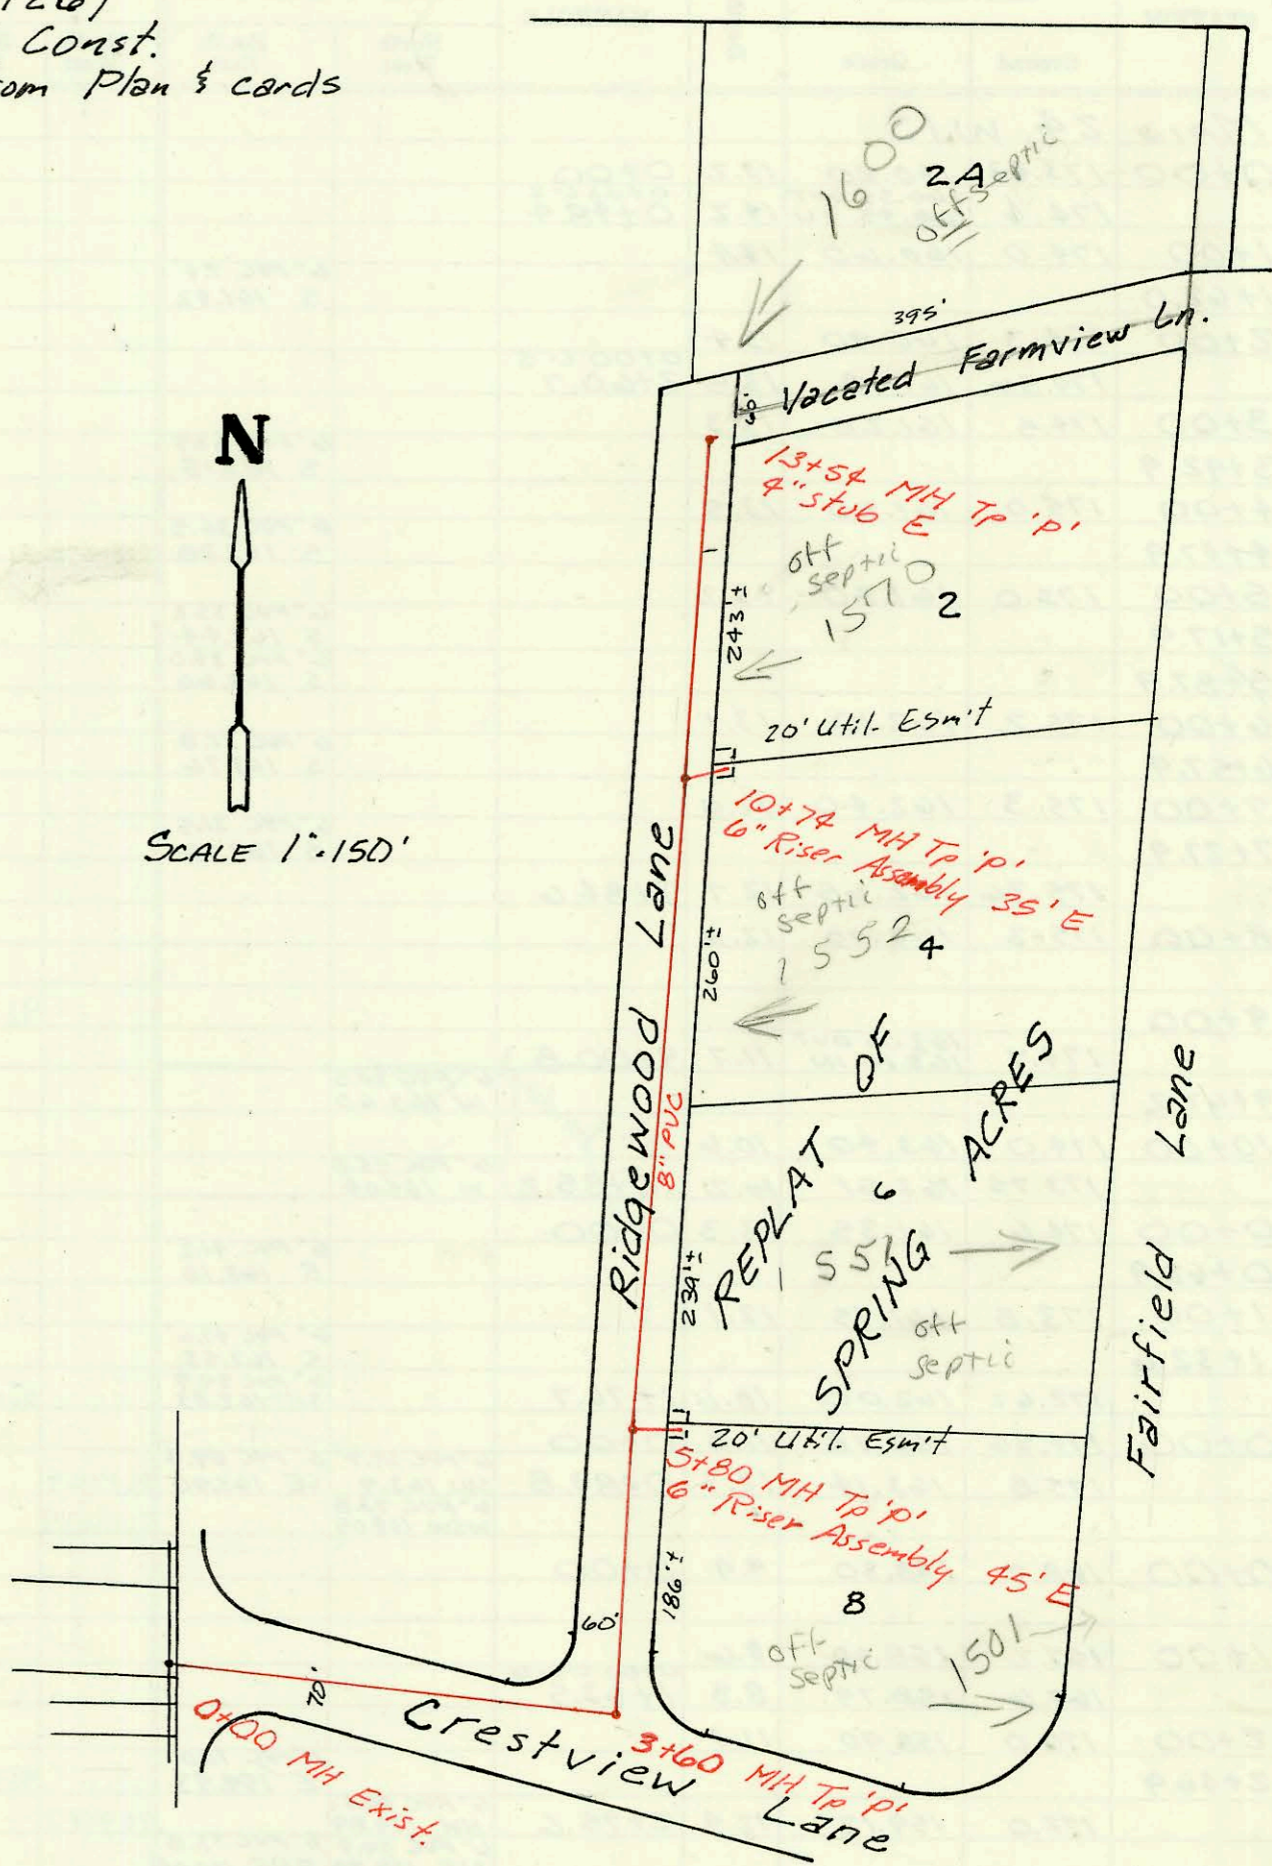


LAT 113, MAIN 2, S.S. #12
468-81982 (740126)
Built By Stannard Const.
Booked 5-7-90 from Plan & cards

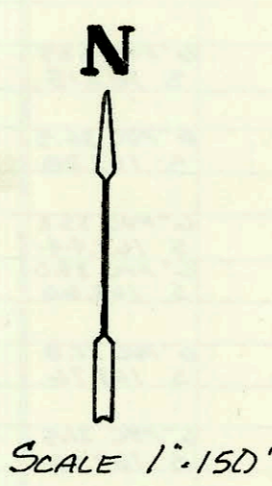

LAT 6, MAIN 1, COWSKIN INTERCEPTOR
468-81984 (740225)
Built By Utility Contr.
Booked 5-8-90 from Plan

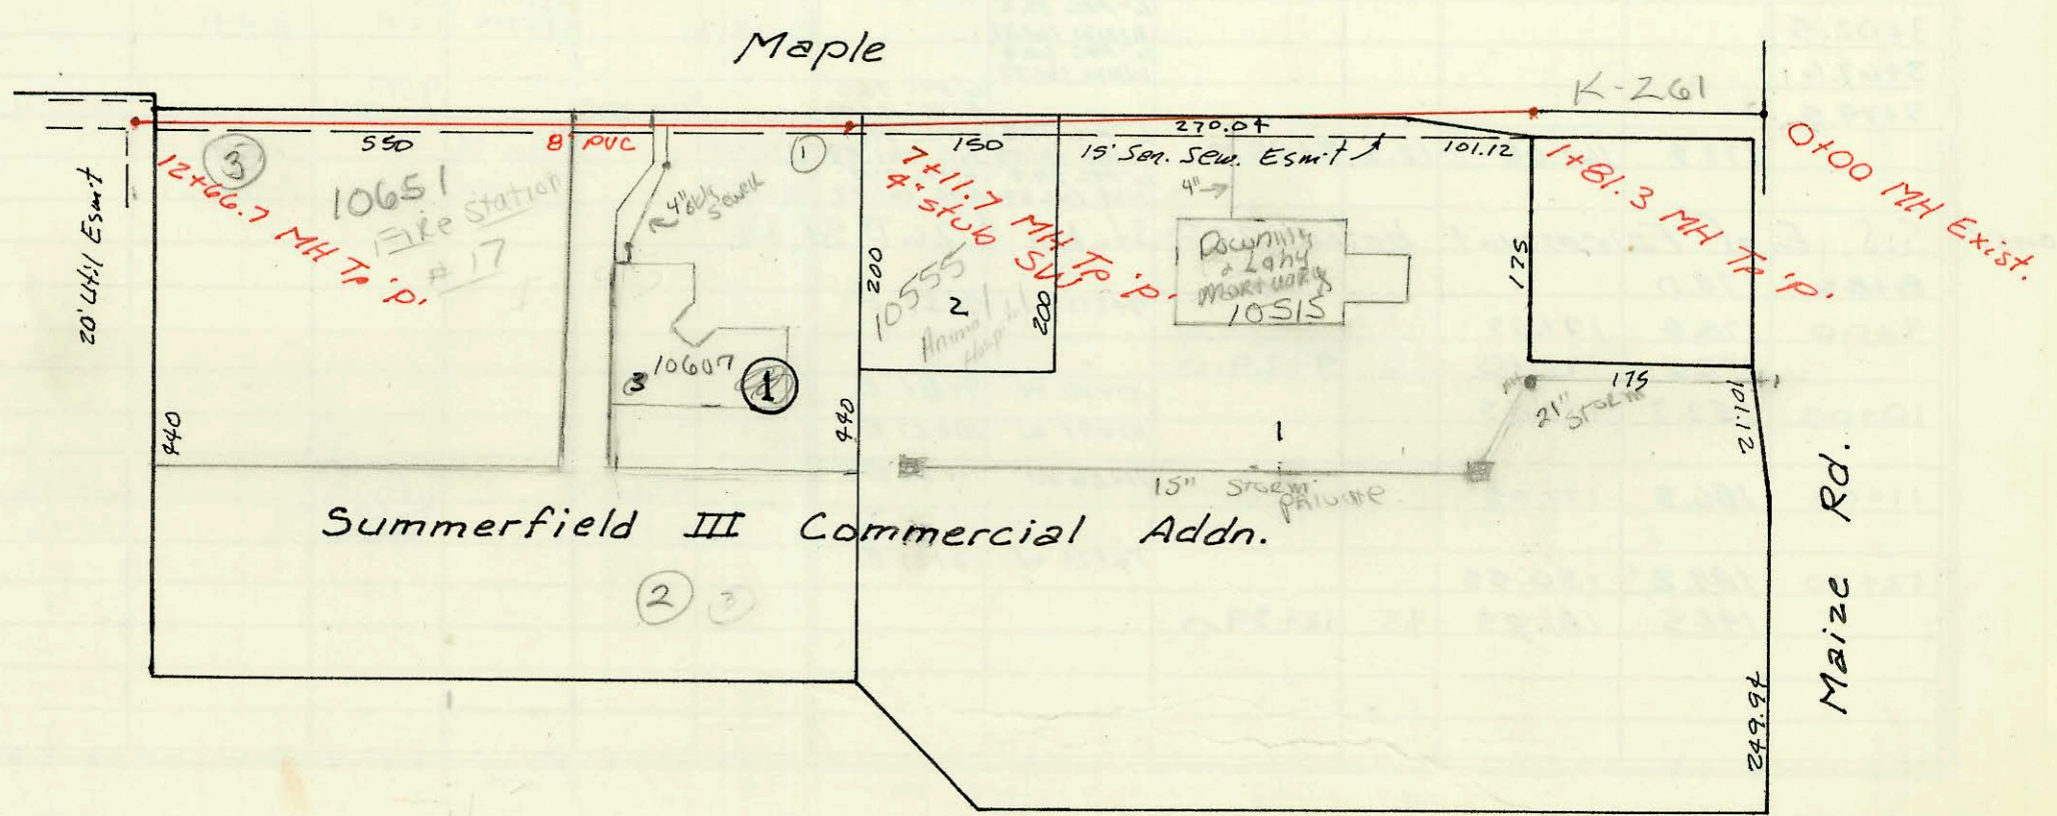

| CONSTRUCTION RECORD | | | | | | SERVICE RECORD | | | | | | |
|---|-----------|-------------------------|-------|----------------|---------------------|----------------|---------------|------------|--------------|------------|-----------------|------------|
| STATION | ELEVATION | | Depth | MANHOLE | 4-INCH "Y" BRANCHES | | No. of Permit | | House Number | | DATE OF PERMITS | |
| | Ground | Grade | | | North West | South East | North West | South East | North West | South East | North West | South East |
| LAT 113 Main 2, S.S. #12 0+00 | 217.1 | 204.00 | 13.1 | EXIST. 0+00 | | | | | | | | |
| 1+00 | 217.6 | 204.40 | 13.2 | | | | | | | | | |
| 2+00 | 216.8 | 204.80 | 12.0 | | | | | | | | | |
| 3+00 | 216.4 | 205.20 | 11.2 | | | | | | | | | |
| | 216.1 | 205.44 OUT 207.60 IN | 10.7 | 3+60 | | | | | | | | |
| 4+00 | 215.5 | 207.76 | 7.7 | | | | | | | | | |
| 5+00 | 215.9 | 208.16 | 7.7 | | | | | | | | | |
| | 216.0 | 208.48 | 7.5 | 5+80 | | | | | | | | |
| 6+00 | 216.0 | 208.56 | 7.4 | | | | | | | | | |
| 7+00 | 216.2 | 208.96 | 7.2 | | | | | | | | | |
| 8+00 | 216.0 | 209.36 | 6.6 | | | | | | | | | |
| | | | | | | | | | | | | |
| 9+00 | 216.4 | 209.76 | 6.6 | | | | | | | | | |
| 10+00 | 217.0 | 210.16 | 6.8 | | | | | | | | | |
| | 217.0 | 210.46 | 6.5 | 10+74 | | | | | | | | |
| 11+00 | 217.0 | 210.56 | 6.4 | | | | | | | | | |
| 12+00 | 218.0 | 210.96 | 7.0 | | | | | | | | | |
| | | | | | | | | | | | | |
| 13+00 | 219.5 | 211.36 | 8.1 | | | | | | | | | |
| | 219.5 | 211.58 | 7.9 | 13+54 | | | | | | | | |
| LAT 6, Main 1, CSI 0+00 | | | | EXIST 0+00 | | | | | | | | |
| 1+00 | | | | | | | | | | | | |
| | 134.9 | 120.83 OUT 122.83 IN | 14.1 | 1+81.3 | | | | | | | | |
| 2+00 | 134.6 | 122.89 | 11.7 | | | | | | | | | |
| 3+00 | 135.2 | 123.19 | 12.0 | | | | | | | | | |
| 4+00 | 135.7 | 123.49 | 12.2 | | | | | | | | | |
| 5+00 | 136.3 | 123.79 | 12.5 | | | | | | | | | |
| | | | | | | | | | | | | |
| 6+00 | 136.8 | 124.09 | 12.7 | | | | | | | | | |
| 7+00 | 137.4 | 124.39 | 13.0 | | | | | | | | | |
| | 137.9 | 124.42 | 13.5 | 7+11.7 | | | | | | | | |
| 8+00 | 138.2 | 124.69 | 13.5 | | | | | | | | | |
| | | | | | | | | | | | | |
| 9+00 | 138.8 | 124.99 | 13.8 | | | | | | | | | |
| 10+00 | 139.5 | 125.29 | 14.2 | | | | | | | | | |
| 11+00 | 140.3 | 125.59 | 14.7 | | | | | | | | | |
| | | | | | | | | | | | | |
| 12+00 | 140.9 | 125.89 | 15.0 | | | | | | | | | |
| | 141.8 | 126.09 | 15.7 | 12+66.7 | | | | | | | | |
| LAT 91 LINE 5 WESTLINK SEWER (CONT) 0+00 | 168.1 | 154.89 | 13.2 | EXIST 0+00 | | | | | | | | |
| 1+00 | 169.6 | 155.29 | 14.3 | | | | | | | | | |
| | | | | | | | | | | | | |
| 2+00 | 170.6 | 155.69 | 14.9 | | | | | | | | | |
| | | | | | | | | | | | | |
| 3+00 | 171.1 | 156.09 | 15.0 | | | | | | | | | |
| | | | | | | | | | | | | |
| 4+00 | 170.8 | 156.49 | 14.3 | | | | | | | | | |
| | 170.7 | 156.60 | 14.1 | 4+28.7 | | | | | | | | |