

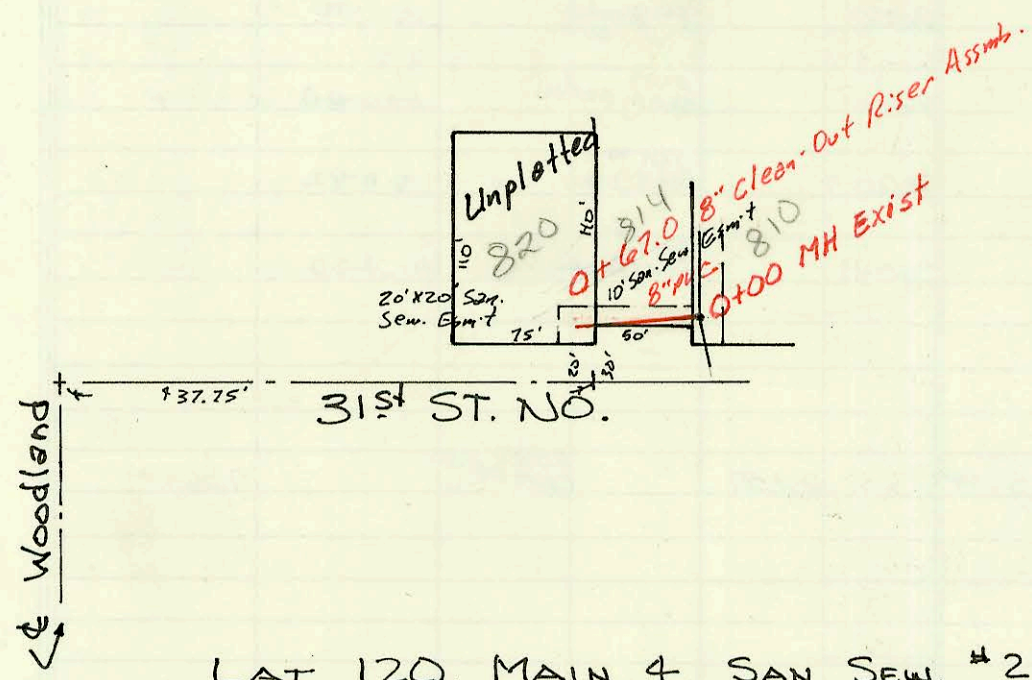


LAT 288, SW INTERCEPTOR
468-82014 (740258)
Built By DULING CONST.
Booked 7-24-90 From Plan

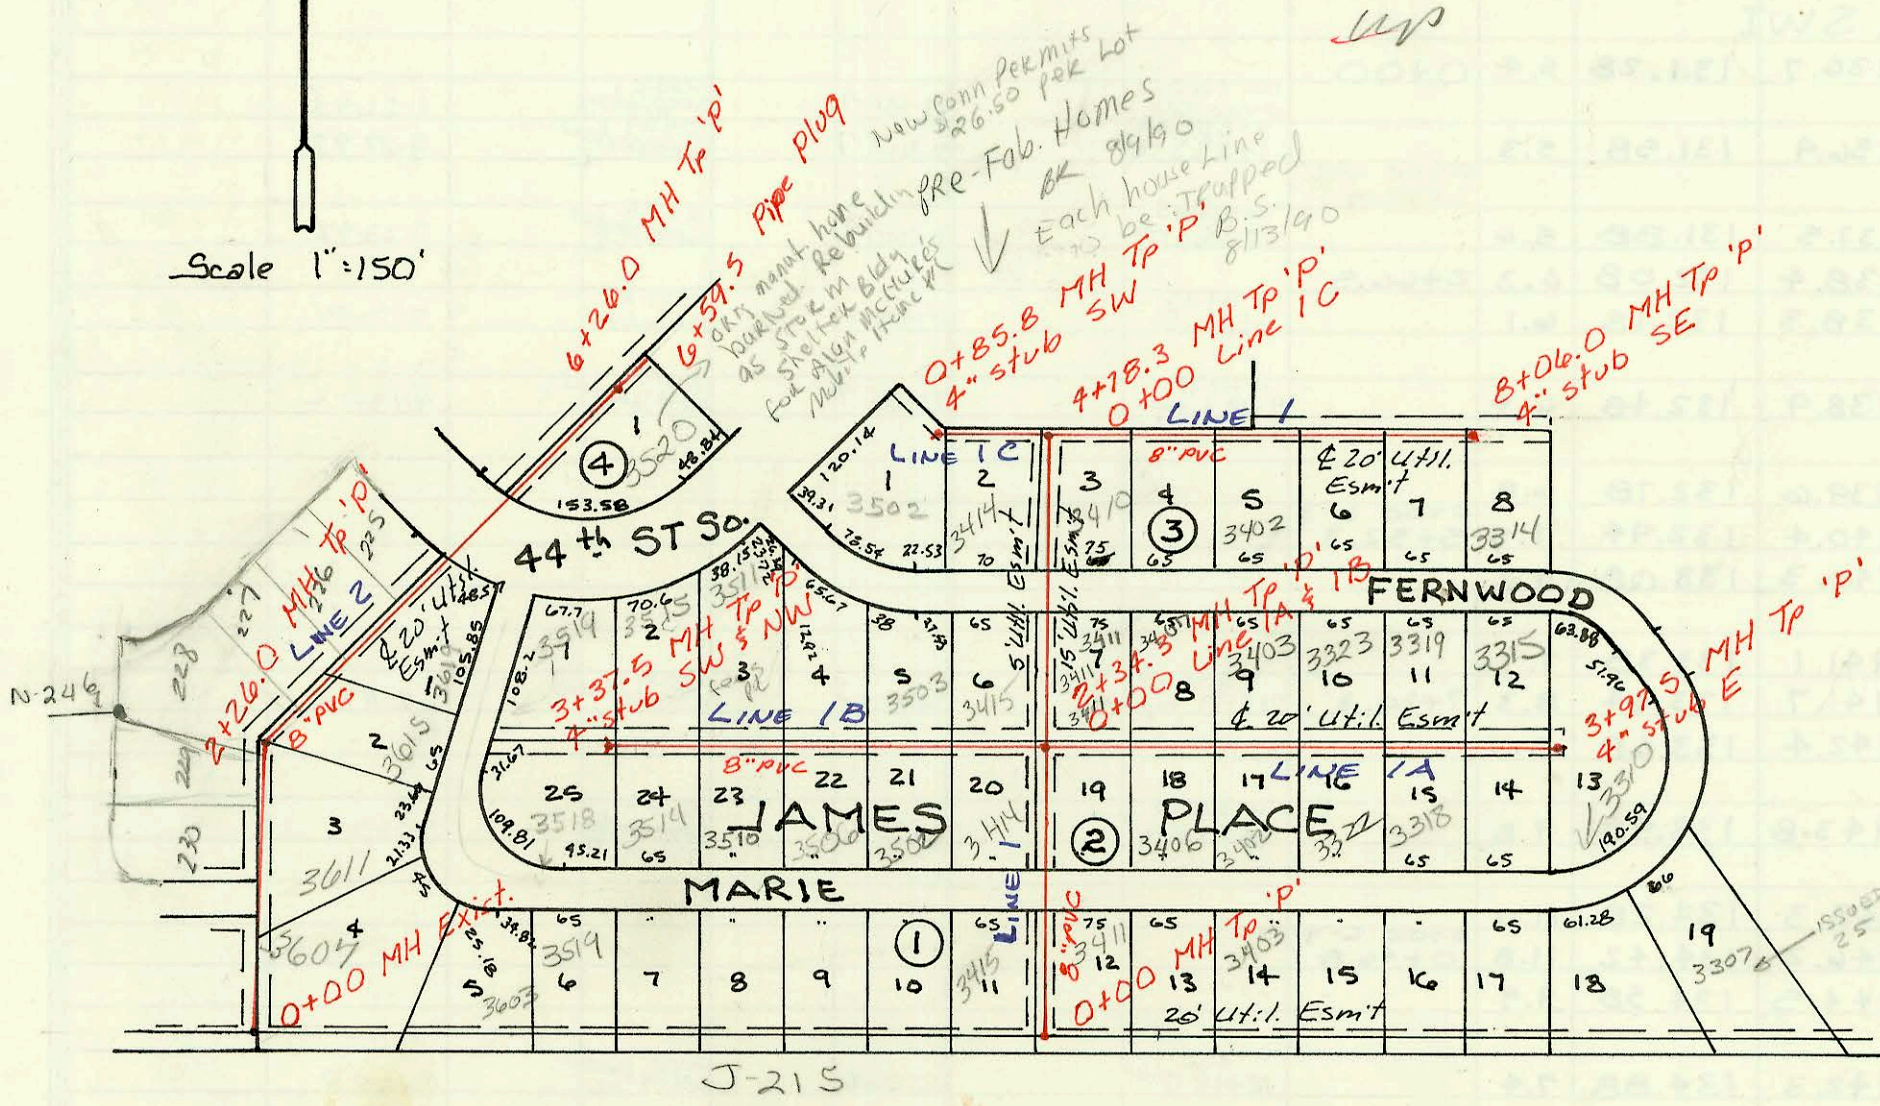

LAT 48, S.S. #20
468-82057 (740472)
Built By Silver Eagle
Booked 9-20-90 from Plan

LAT 120, MAIN 4, SAN. SEW. #23
468-82056 (740464)
Built By Stannard Const.
Booked 8-1-90 from Plan

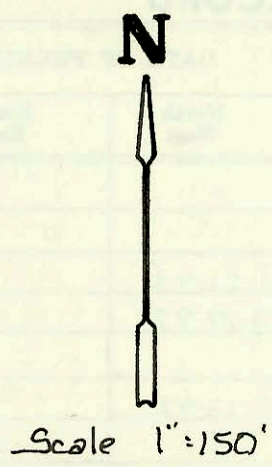