


21<sup>st</sup> ST. NO.

LAT 56, MAIN 22, W.I.S.  
468-82035 (740365)  
Built By Nowak Const  
Booked 8-14-90 from Plan 5 NCH-11



Scale 1"=150'

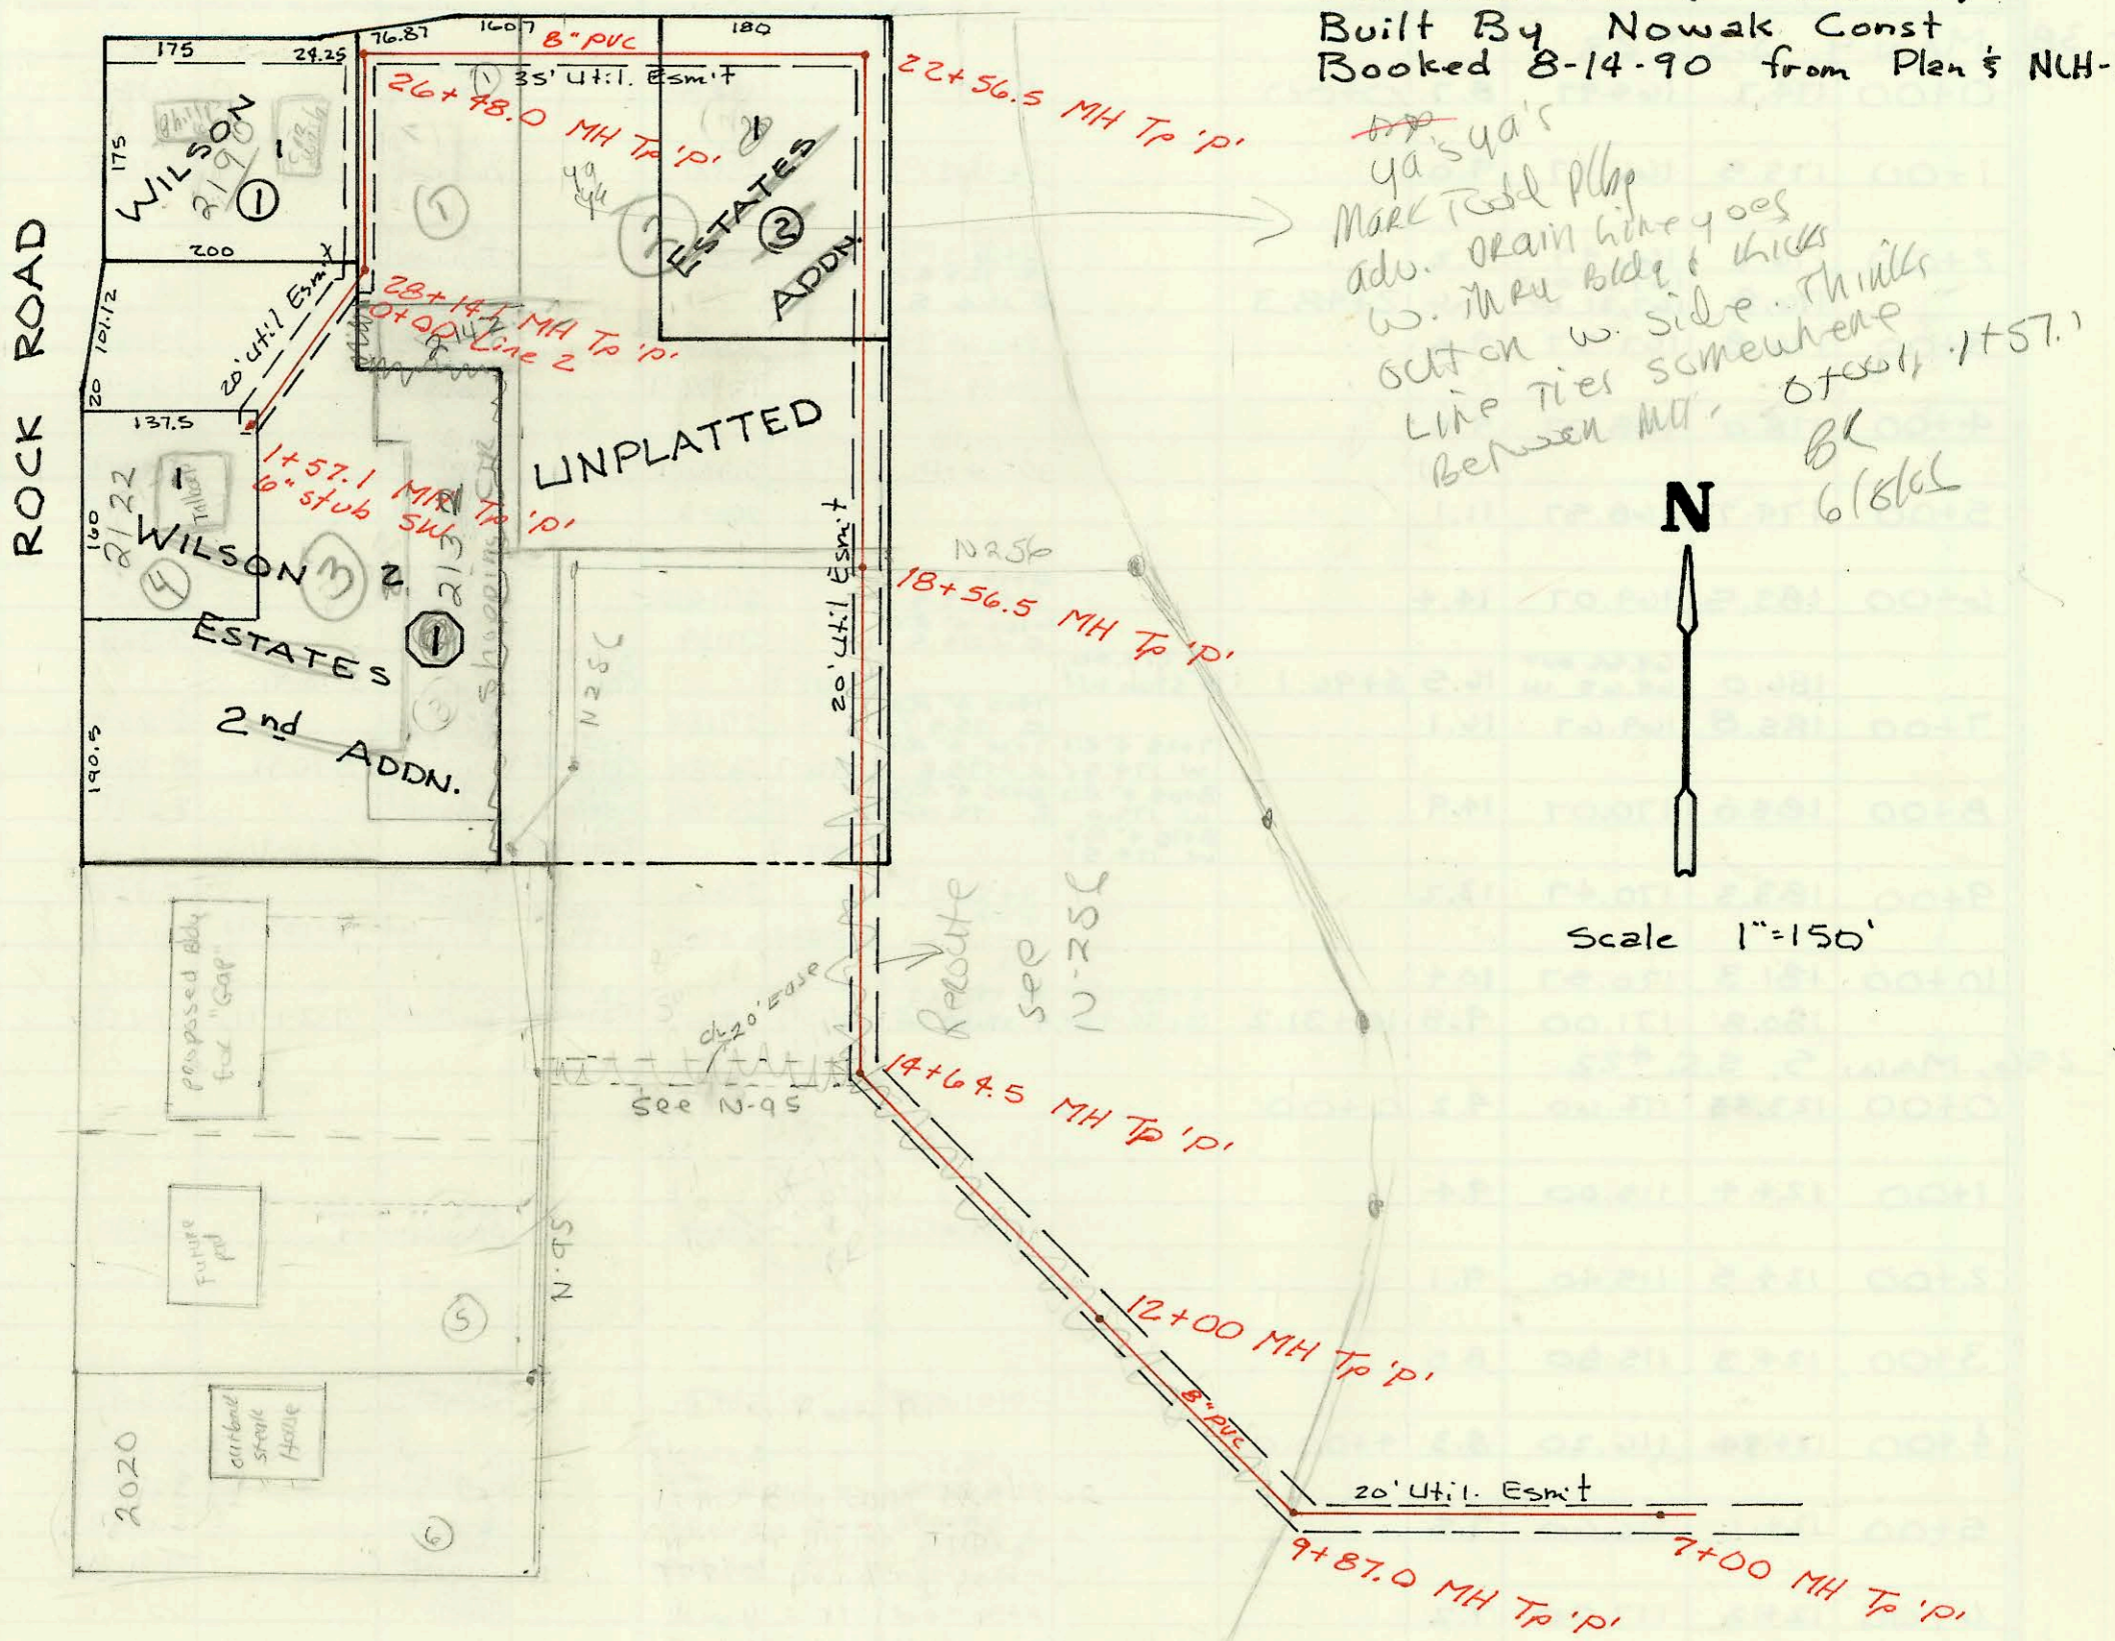