


NOTE:
 Platted 10' Util Easement
 along W.L., N.P.L. and E.P.L.
 of this Plat. City to maintain
 sewers in util easement only.
 Lines in side park are to be maintained
 by park owner.

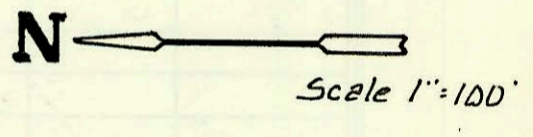

PRIVATE SANITARY SEWER FOR LAMPLIGHTER
 MOBILE HOME PARK ADDITION - PHASE II
 PRIVATE PROJECT NO. 334 PPS (607861)
 BUILT BY A PLUS PLUMBING
 BOOKED 10-22-92 FROM AS BUILTS

Priv. Sanitary Sewer for Lamplighter
 Mobile Home Park Addn. Phase II
 468-76-245-80001-000-000-055
 Built By
 Booked 8-23-90 from As Built Plans

PRIVATE SANITARY SEWER FOR LAMPLIGHTER
 MOBILE HOME PARK ADDITION - PHASE IV
 PRIV. PROJ. NO. 407 PPS (607861)
 BUILT BY A PLUS PLUMBING
 BOOKED 11-5-93 FROM AS BUILTS

PRIVATE SANITARY SEWER FOR LAMPLIGHTER
 MOBILE HOME PARK ADDITION - PHASE V
 PRIV. PROJ. 455 PPS (607861)
 BUILT BY A PLUS PLUMBING
 BOOKED 7-19-94 FROM AS BUILTS

See memo from C. Fugitt Sewer Maint
 4-5-00

CONSTRUCTION RECORD

SERVICE RECORD

STATION	ELEVATION		Depth	MANHOLE	4-INCH "Y" BRANCHES		No. of Permit		House Number		DATE OF PERMITS	
	Ground	Grade			North West	South East	North West	South East	North West	South East	North West	South East
Priv. S.S. for Lamplighter Mobile Home Park (2320 E. MacArthur)												
LINE I	11+12	82.78	78.69	4.1	11+12							
		83.18	78.82	4.4	11+95.8							
	12+00	83.8	78.84	5.0								
	13+00	82.5	79.23	3.3								
	14+00	83.2	79.62	3.6								
		83.34	79.74	3.6	14+31.1							
LINE F	0+00	83.18	78.90	4.3	0+00	0+42.0 TAP	0+47.0 TAP	25690	25709	Lot 6	Lot 25	7-10-90
	1+00	83.5	79.26	4.2		1+12.0 TAP	1+17.5 TAP	25691	25708	Lot 7	Lot 24	7-10-90
						1+84.5 TAP	1+85.5 TAP	25692	25707	Lot 8	Lot 23	7-10-90
	2+00	83.1	79.61	3.5		2+55.5 TAP		25693		Lot 9		7-10-90
						2+99.9 TAP	2+53.5 TAP	25694	25706	Lot 10	Lot 22	7-10-90
	3+00	83.5	79.97	3.5		3+20.6 TAP	3+27.4 TAP	25695	25705	Lot 11	Lot 21	7-10-90
		83.24	80.01	3.2	3+12.4		3+92.4 TAP		25704		Lot 20	7-10-90
	4+00	84.0	80.26	3.7								
						4+65.4 TAP		25696		Lot 12		7-10-90
	5+00	84.3	80.55	3.8		5+34.9 TAP	5+13.1 TAP	25697	25703	Lot 13	Lot 19	7-10-90
							5+32.9 TAP		25702		Lot 18	7-10-90
	6+00	84.7	80.84	3.9		6+05.1 TAP	6+02.6 TAP	25698	25701	Lot 14	Lot 17	7-10-90
		84.23	81.02	3.2	6+62.1	6+57.1 TAP	4" stub S	25699	25700	Lot 15	Lot 16	7-10-90
LINE G	0+00	83.18	78.88	4.3	0+00	0+27.0 TAP	0+22.0 TAP	25684	25710	Lot 5	Lot 26	7-10-90
							0+92.5 TAP		25711		Lot 27	7-10-90
	1+00	84.4	79.23	5.2		1+03.0 TAP		25685		Lot 4		7-10-90
						1+65.0 TAP	1+60.0 TAP	25687	25712	Lot 3	Lot 28	7-10-90
	2+00	84.7	79.57	5.1		2+35.0 TAP	2+31.0 TAP	25696	25713	Lot 2	Lot 29	7-10-90
							3+02.0 TAP		25714		Lot 30	7-10-90
	3+00	84.3	79.92	4.4								
		84.00	79.94	4.1	3+05.8	4" stub N		25685		Lot 1		7-10-90
LINE I	14+31.1	83.34	79.74	3.6	14+31.1							
	15+00	83.30	79.95	3.4								
	16+00	83.70	80.27	3.4								
		83.73	80.53 OUT 80.58 IN	3.2	16+80.5							
Private Main I Sanitary Sewer for Lamplighter Mobile Home Park (334 PPS) Extensions												
Private Main I	0+00	84.03	79.97	4.1	0+00	4" SDR 35 0+34.0 TAP		92-1672-7		2320 # 65 E. MacArthur		8-31-92
	1+00	84.20	80.40	3.8		4" SDR 35 0+96.0 TAP		92-25210-7		2320 # 64 E. MacArthur		8-31-92
						4" SDR 35 1+57.0 TAP		92-25211-7		2320 # 63 E. MacArthur		8-31-92
	2+00	84.20	80.83	3.4		4" SDR 35 2+16.5 TAP		92-25212-7		2320 # 62 E. MacArthur		8-31-92
						4" SDR 35 2+79.0 TAP		92-25213-7		2320 # 61 E. MacArthur		8-31-92
	3+00	84.50	81.26	3.2		4" SDR 35 2+97.1 TAP		92-25214-7		2320 # 60 E. MacArthur		8-31-92
		84.57	81.27	3.3	3+02.1							
Main II	0+00	84.27	79.75	4.5		4" SDR 35 0+06.5 TAP		92-25215-7		2320 # 25 E. MacArthur		
						4" SDR 35 0+51.0 TAP		92-25216-7		2320 # 26 E. MacArthur		8-31-92
	1+00	84.30	80.40	3.9		4" SDR 35 1+06.0 TAP		92-25217-7		2320 # 24 E. MacArthur		8-31-92
						4" SDR 35 1+69.0 TAP		92-25218-7		2320 # 23 E. MacArthur		8-31-92
	2+00	84.00	81.05	3.0		4" SDR 35 2+25.0 TAP		92-25219-7		2320 # 22 E. MacArthur		8-31-92
						4" SDR 35 2+82.0 TAP		92-25220-7		2320 # 21 E. MacArthur		8-31-92
	3+00	84.50	81.71	2.8		4" SDR 35 3+37.0 TAP		92-25221-7		2320 # 20 E. MacArthur		8-31-92
	4+00	86.20	82.36	3.8								
		86.27	82.37	3.9	4+00.5							
Private Sanitary Sewer to Service Lamplighter Mobile Home Park - Phase IV (407 PPS)												
LINE H	0+00	83.34	79.74	3.6	0+00	14+31.1 - LINE I						
	1+00	83.80	80.03	3.8								
	2+00	84.10	80.31	3.8								
		83.52	80.51	3.0	2+70.9							
	3+00	84.40	80.60	3.8								
	4+00	84.60	80.89	3.7								
	5+00	85.00	81.17	3.8								
		84.43	81.31	3.1	5+48.1							
LINE I	0+00	83.34	79.74	3.6	0+00	14+31.1 - LINE I						
	1+00	83.90	80.04	3.9								
Form #192-020 (July, 1981)												
	2+00	84.30	80.34	4.0								
	3+00	84.50	80.64	3.9								
	4+00	85.00	80.94	4.1								
		84.03	81.03	3.0	4+28.4							