


PRIVATE SANITARY SEWER FOR LAMPLIGHTER MOBILE HOME PARK ADDITION - PHASE II
 PRIVATE PROJECT NO. 334 PPS (607861)
 BUILT BY A PLUS PLUMBING
 BOOKED 10-22-92 FROM AS BUILTS

Priv. Sanitary Sewer for Lamplighter Mobile Home Park Addn. Phase II
 468-76-245-80001-000-000-055
 Built By
 Booked 8-23-90 from As Built Plans

PRIVATE SANITARY SEWER FOR LAMPLIGHTER MOBILE HOME PARK ADDITION - PHASE IV
 PRIV. PROJ. NO. 407 PPS (607861)
 BUILT BY A PLUS PLUMBING
 BOOKED 11-5-93 FROM AS BUILTS

PRIVATE SANITARY SEWER FOR LAMPLIGHTER MOBILE HOME PARK ADDITION - PHASE V
 PRIV. PROJ. 455 PPS (607861)
 BUILT BY A PLUS PLUMBING
 BOOKED 7-19-94 FROM AS BUILTS

NOTE:
 Platted 10' Util Easement along W.L., N.P.L. and E.P.L. of this Plat. City to maintain sewers in util easement only. Lines in side park are to be maintained by park owner.

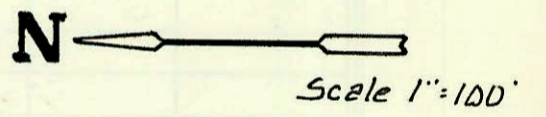

See memo from C. Fugitt Sewer Maint 4-5-00

CONSTRUCTION RECORD						SERVICE RECORD						
STATION	ELEVATION		Depth	MANHOLE	4-INCH "Y" BRANCHES		No. of Permit		House Number		DATE OF PERMITS	
	Ground	Grade			North West	South East	North West	South East	North West	South East	North West	South East
Private Sanitary Sewer To Serve Lamplighter Mobile Home Park Addition - Phase V												
LINE 1 0+00	83.73	80.53 OUT 80.64 IN	3.2	0+00								
1+00	84.00	80.81	3.2									
2+00	84.40	80.98	3.4									
		84.91	3.8	2+77.2								
3+00	84.70	81.24	3.5									
4+00	85.00	81.87	3.2									
5+00	85.30	82.39	2.9									
		86.58	3.7	5+81.1								
LINE 2 0+00	83.73	80.53 OUT 80.59 IN	3.2	0+00								
1+00	84.00	81.06	2.9									
2+00	84.40	81.54	2.9									
3+00	84.70	82.01	2.7									
		85.16	2.7	3+96.8								

