




LAT 6, MAIN 13, SW INTERCEPTOR  
468-82071 (740555)  
Built By Nowak Const.  
Booked 1-23-91 from Plan.

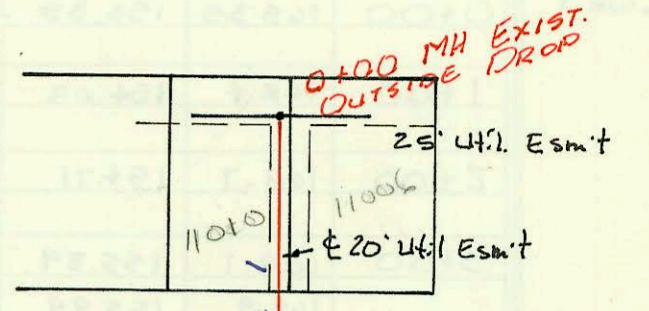

Scale 1"=100'

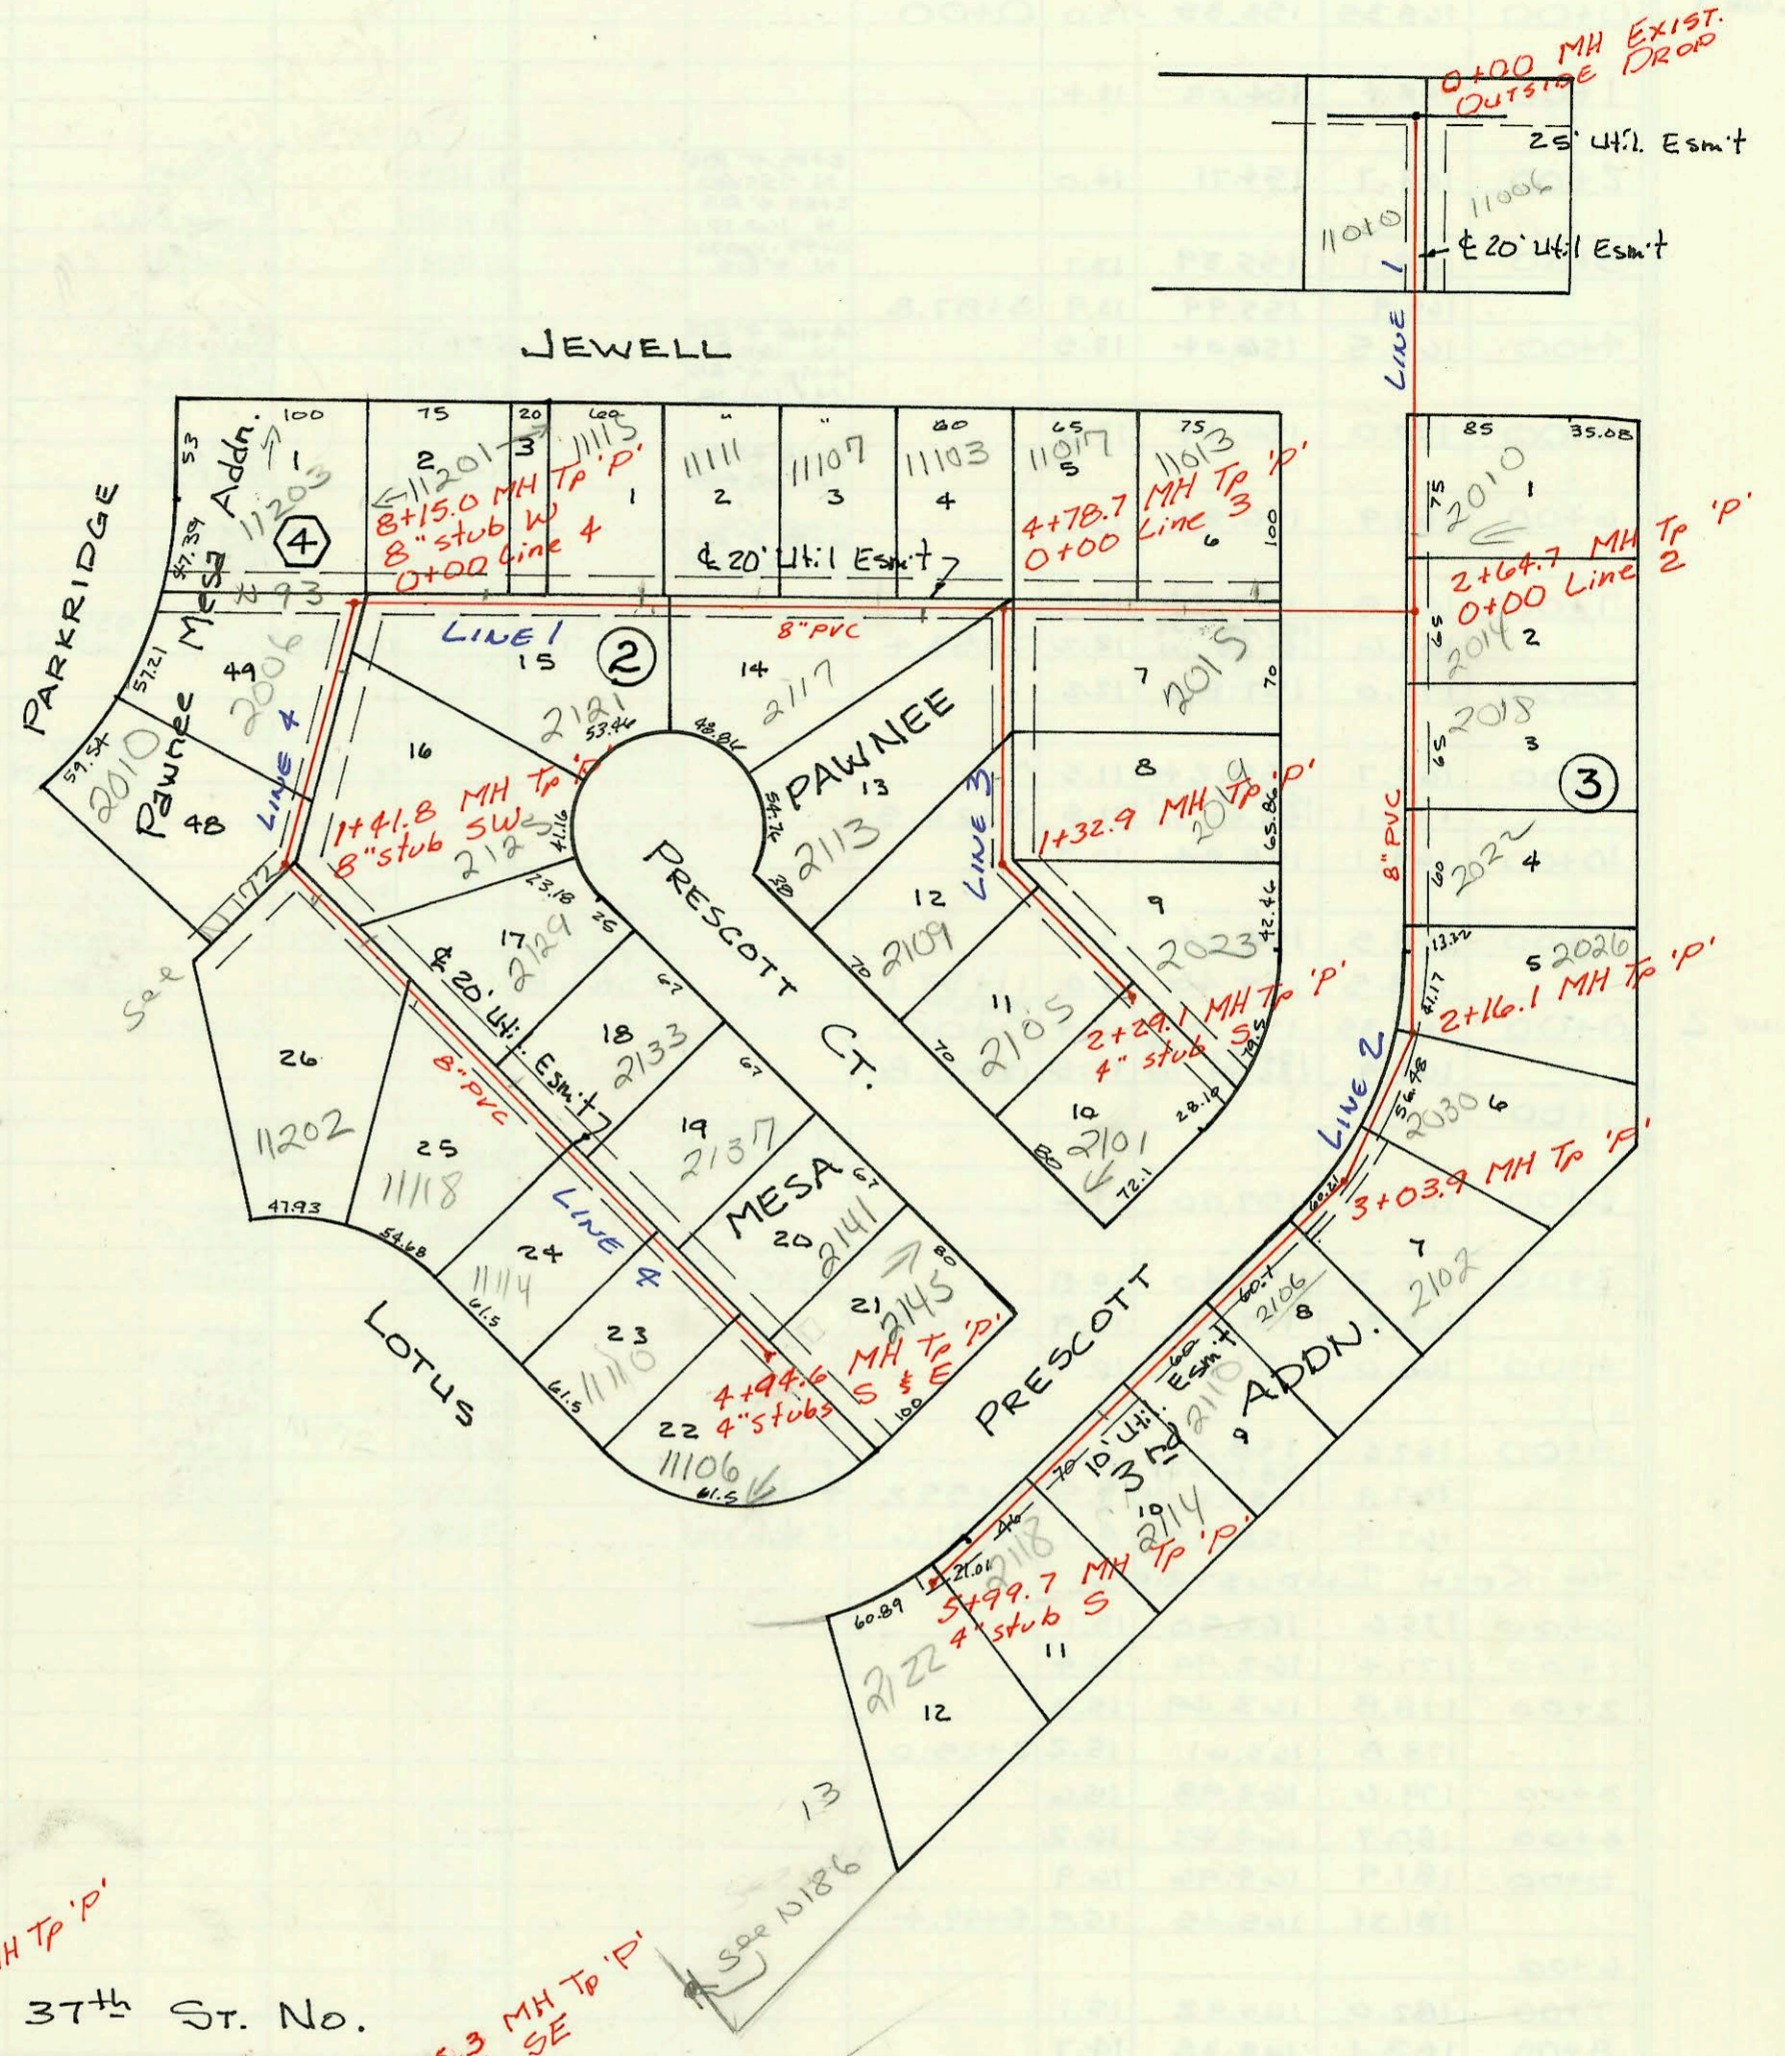

2+26.5 MH TP 'P'  
37th St. No.

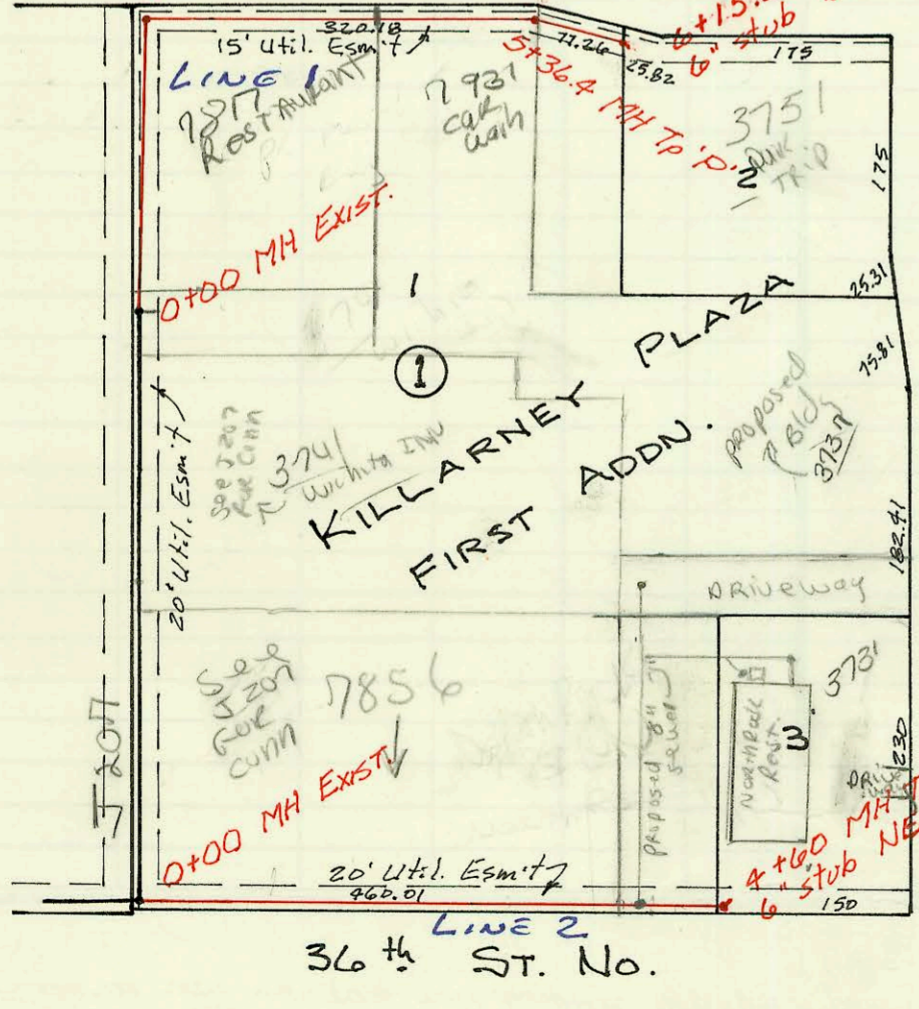

LAT 28, MAIN 9, S.S. # 23  
468-81750 (740563)  
Built By Nowak Const.  
Booked 1-25-91 from Plan



Scale 1"=150'

CONSTRUCTION RECORD						SERVICE RECORD						
STATION	ELEVATION		Depth	MANHOLE	4-INCH "Y" BRANCHES		No. of Permit		House Number		DATE OF PERMITS	
	Ground	Grade			North West	South East	North West	South East	North West	South East	North West	South East
LAT 6, MAIN 13, SW 1												
0+00	145.11	127.49	17.4	0+00								
1+00	141.3	127.89	13.4									
2+00	142.0	128.29	13.7									
	141.5	128.55 OUT 128.65 IN	13.0	0+00 L-2 2+64.7								
3+00	141.1	128.79	12.3									
					3+45 4" RIS N 132.0	3+80 4" RIS S 132.0	73-19947	2162	11013 W Jewell	2415 Prescott	9-23-93	0-12-92
4+00	142.5	129.19	13.3									
	143.0	129.51	13.5	0+00 L-3 4+78.7	4+15 4" RIS N 132.5		91-302547	760	11011 Jewell		8-19-91	
5+00	143.0	129.59	13.4									
					5+45 4" RIS N 133.5	5+20 4" RIS S 133.5	2150	93-19727	11107 Jewell	2177 Prescott	2-21-92	7-23-93
6+00	143.5	129.99	13.5									
					6+05 4" RIS N 133.5	6+60 4" RIS S 133.5	72-68057		11111 W Jewell		5-8-92	
7+00	143.7	130.39	13.3									
					7+40 4" RIS N 134.0		73-264827		11201 W Jewell		10-8-93	
8+00	144.0	130.79	13.2									
	144.1	130.85	13.3	0+00 L-4 8+15.0	8" stub W							
0+00	141.5	130.11	11.4	0+00								
1+00	141.8	130.51	11.3									
2+00	142.0	130.91	11.1									
	142.0	130.97 OUT 131.07 IN	11.0	2+16.1								
3+00												
	141.4	131.42 OUT 131.52 IN	10.0	3+03.9								
4+00	141.4	131.91	9.5									
5+00	141.4	132.31	9.1									
	141.3	132.70	8.0	5+99.7								
0+00	143.0	131.48	11.5	0+00								
1+00	143.3	131.88	11.4									
	143.5	132.01 OUT 132.11 IN	11.5	1+32.9								
2+00	142.5	132.38	10.1									
	142.3	132.49	9.8	2+29.1								
0+00	144.1	130.95	13.2	0+00								
1+00	144.0	131.35	12.7									
	144.0	131.52 OUT 131.62 IN	12.5	1+41.8								
2+00	143.6	131.85	11.8									
3+00	143.0	132.25	10.8									
4+00	142.5	132.65	9.9									
	142.0	133.03	9.0	4+94.6								
LAT 28, MAIN 9, S.S. #23												
0+00	196.35	186.70	9.7	0+00								
1+00	197.8	187.70	10.1									
2+00	198.7	188.70	10.0									
	199.50	188.97 OUT 189.07 IN	10.5	2+26.5								
3+00	199.8	189.80	10.0									
4+00	200.8	190.80	10.0									
5+00	201.4	191.80	9.6									
	202.5	192.16 OUT 192.26 IN	10.3	5+36.4								
6+00	202.4	192.90	9.5									
	204.0	193.10	10.9	6+15.3								
0+00	192.99	182.99	10.0	0+00								
1+00	195.0	184.39	10.6									
2+00	196.3	185.79	10.5									
3+00	197.0	187.19	9.8									
	Form #192-020 (July 1981)											
4+00	198.0	188.59	9.4									
	199.6	189.43	10.2	4+60.0	6" stub NE							

LAT 6, Line 1

Line 2

Line 3

Line 4

LAT 28, Line 1

Line 2

92-36487-7 10-12-92 11115 W Jewell - 4" SDR 35 Tap 6+65 (NO RISER FOUND) 95-12967 2/22 PRESCOTT - house sewer comes out back and main is in front. 3-4" PVC 45 (H) 2-4" PVC 45 (H)

96-3626-9 3-19-96 11202 W Lotus - TAP 1+80.4 4" SDR 35 7856 3/24 8/21/95

7856 5/36/91 8-21-95