


### Mobile Home Park


Note: ALL 8" Lines except Line one from MH 0+00 to MH 0+91.3 are privately maintained by Southborough Estates. Any easements shown on orig. plans are private. (not dedicated utility eas.) A main line trap was installed on Line one as part of project. There are no platted lots.

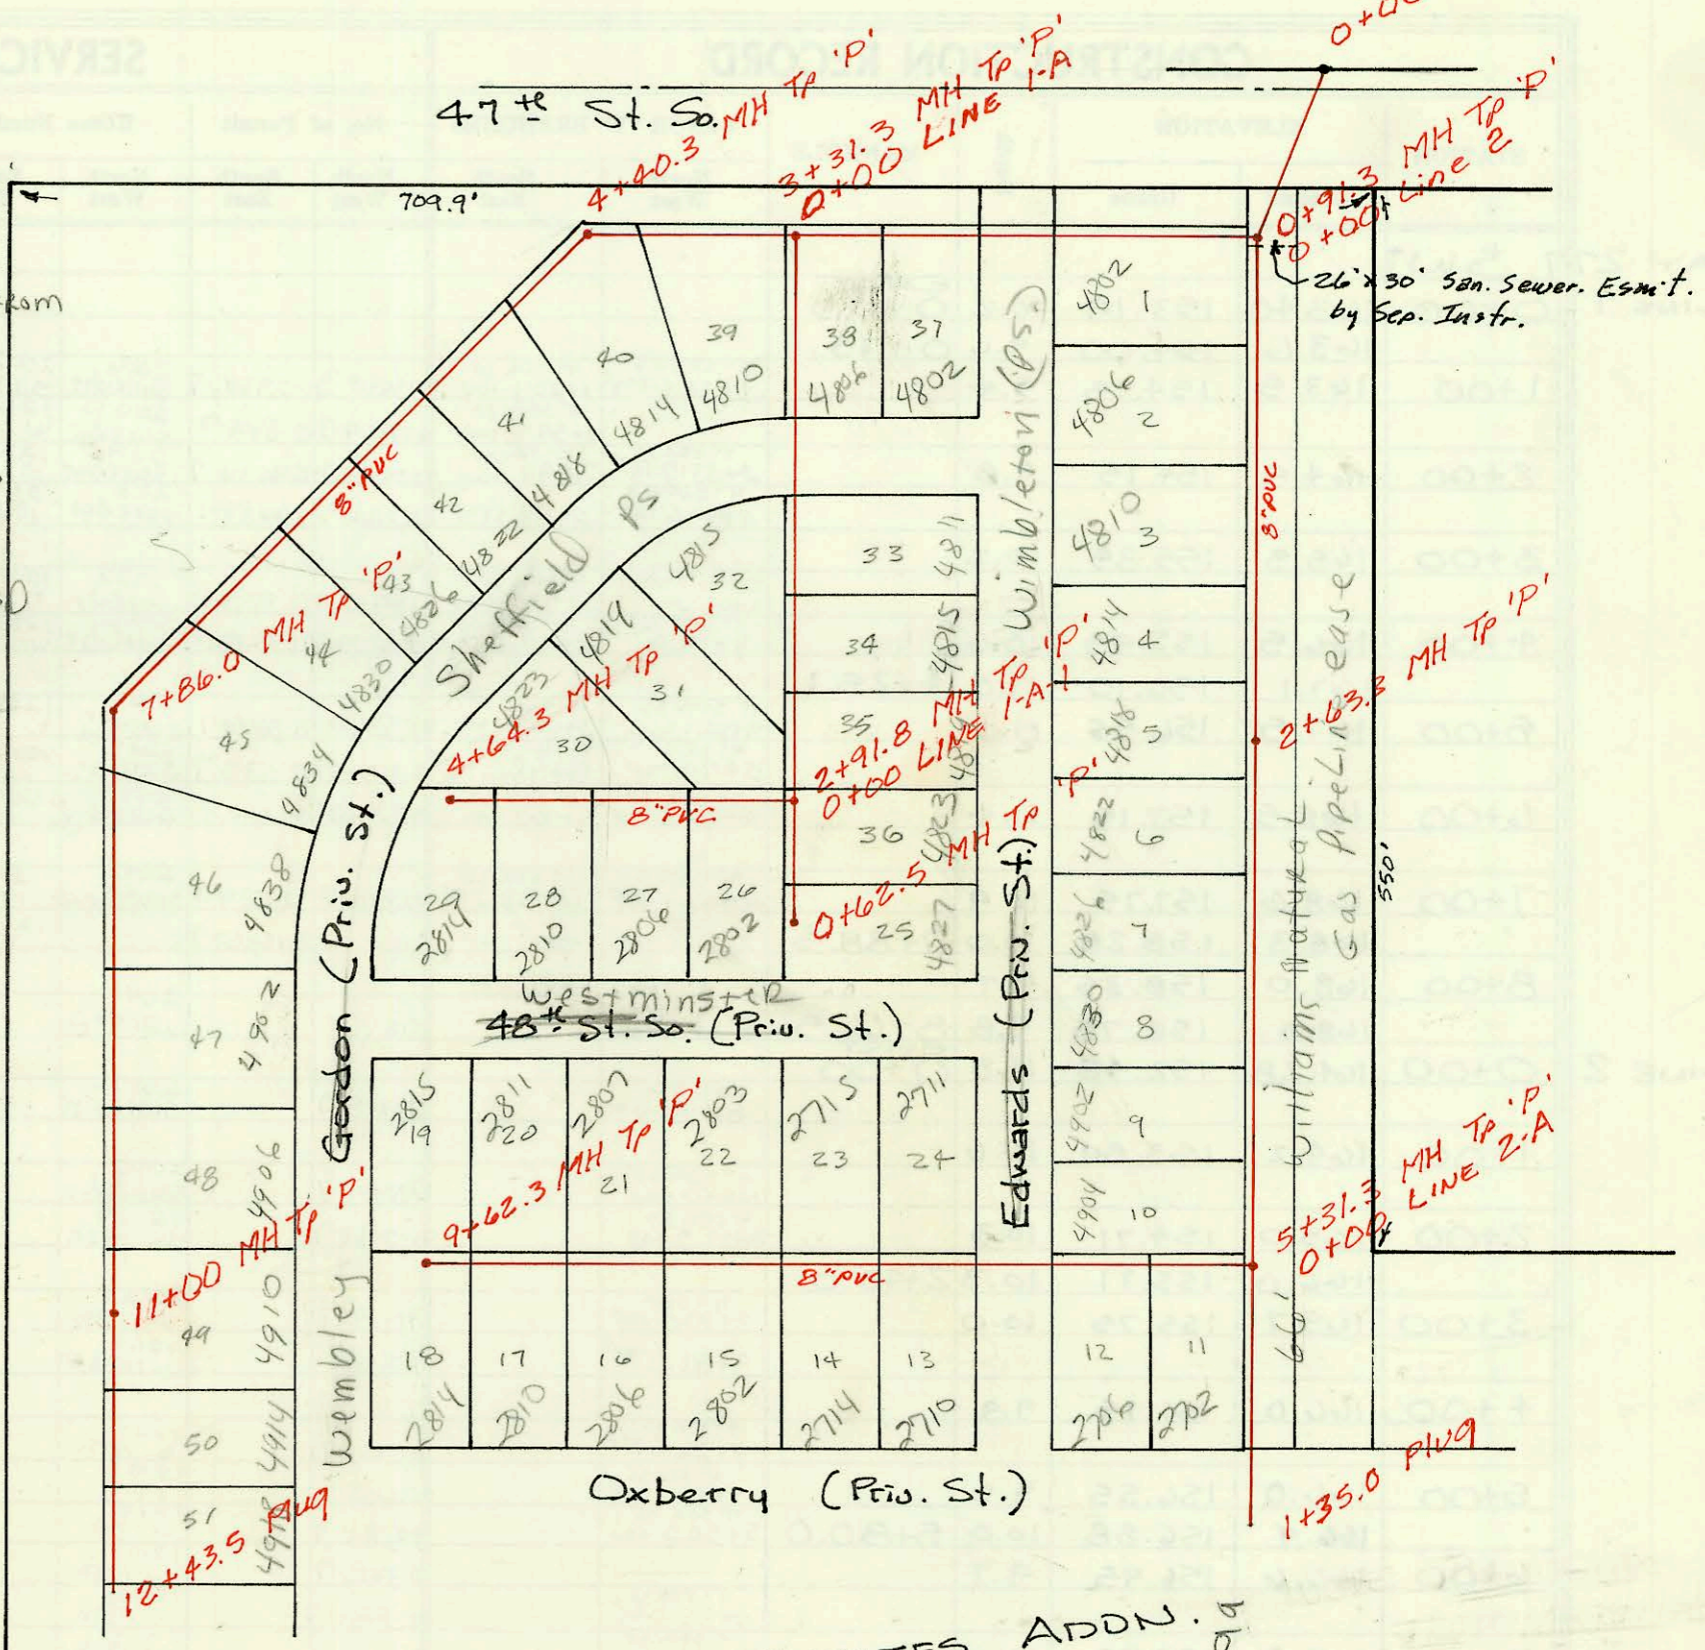

Scale 1"=100'

SOUTHBOROUGH ESTATES ADDN.  
Lot 1, BLK 1

(Privately Maint. Sewer Lines by Trailer Park. No City Maint.)  
Priv. San. Sewer for Southborough Estates  
247 PPS Built by Wildcat Const.  
Booked 1-31-91 from As Built Plan

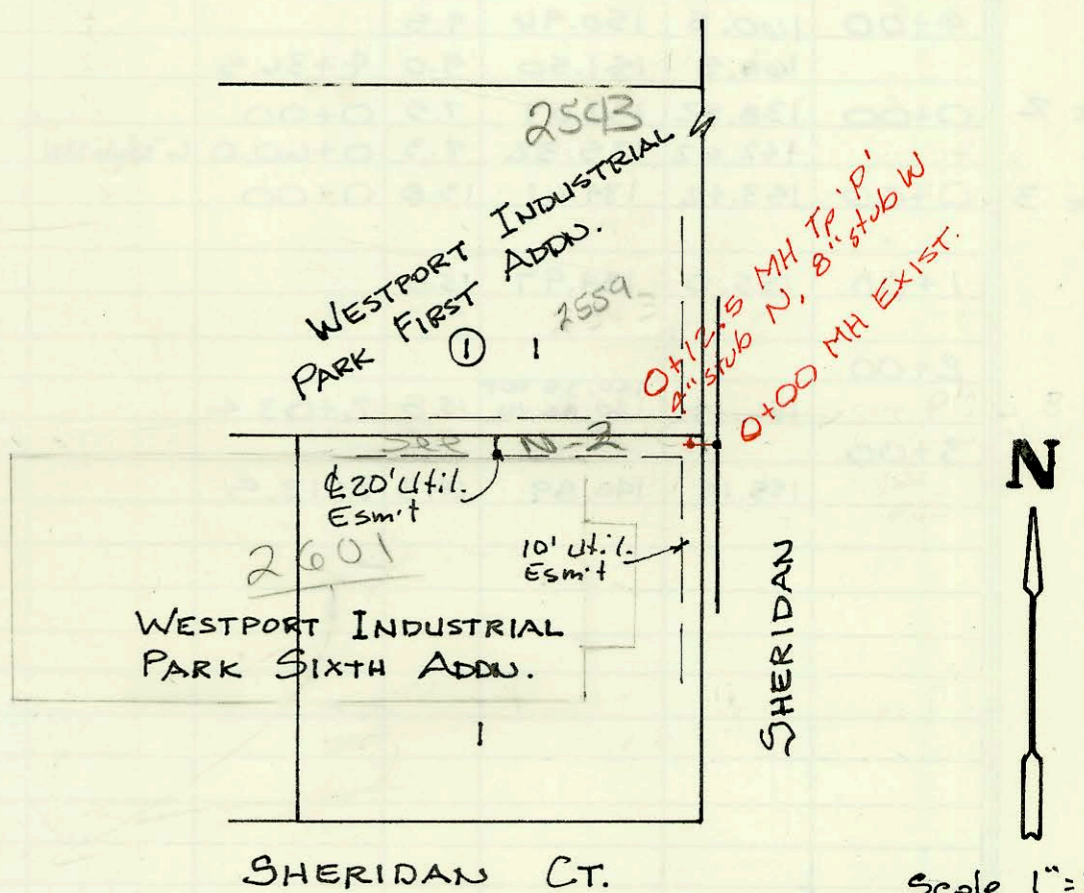

Scale 1"=100'

Priv. San. Sew. to serve S. 300' of Lot 1, Blk 1  
Westport Industrial Park 1st Addn  
259 PPS Built By MEIS CONST.  
Booked 2-5-91 from As Built Plan.

