


KELLOGG - U.S. 54

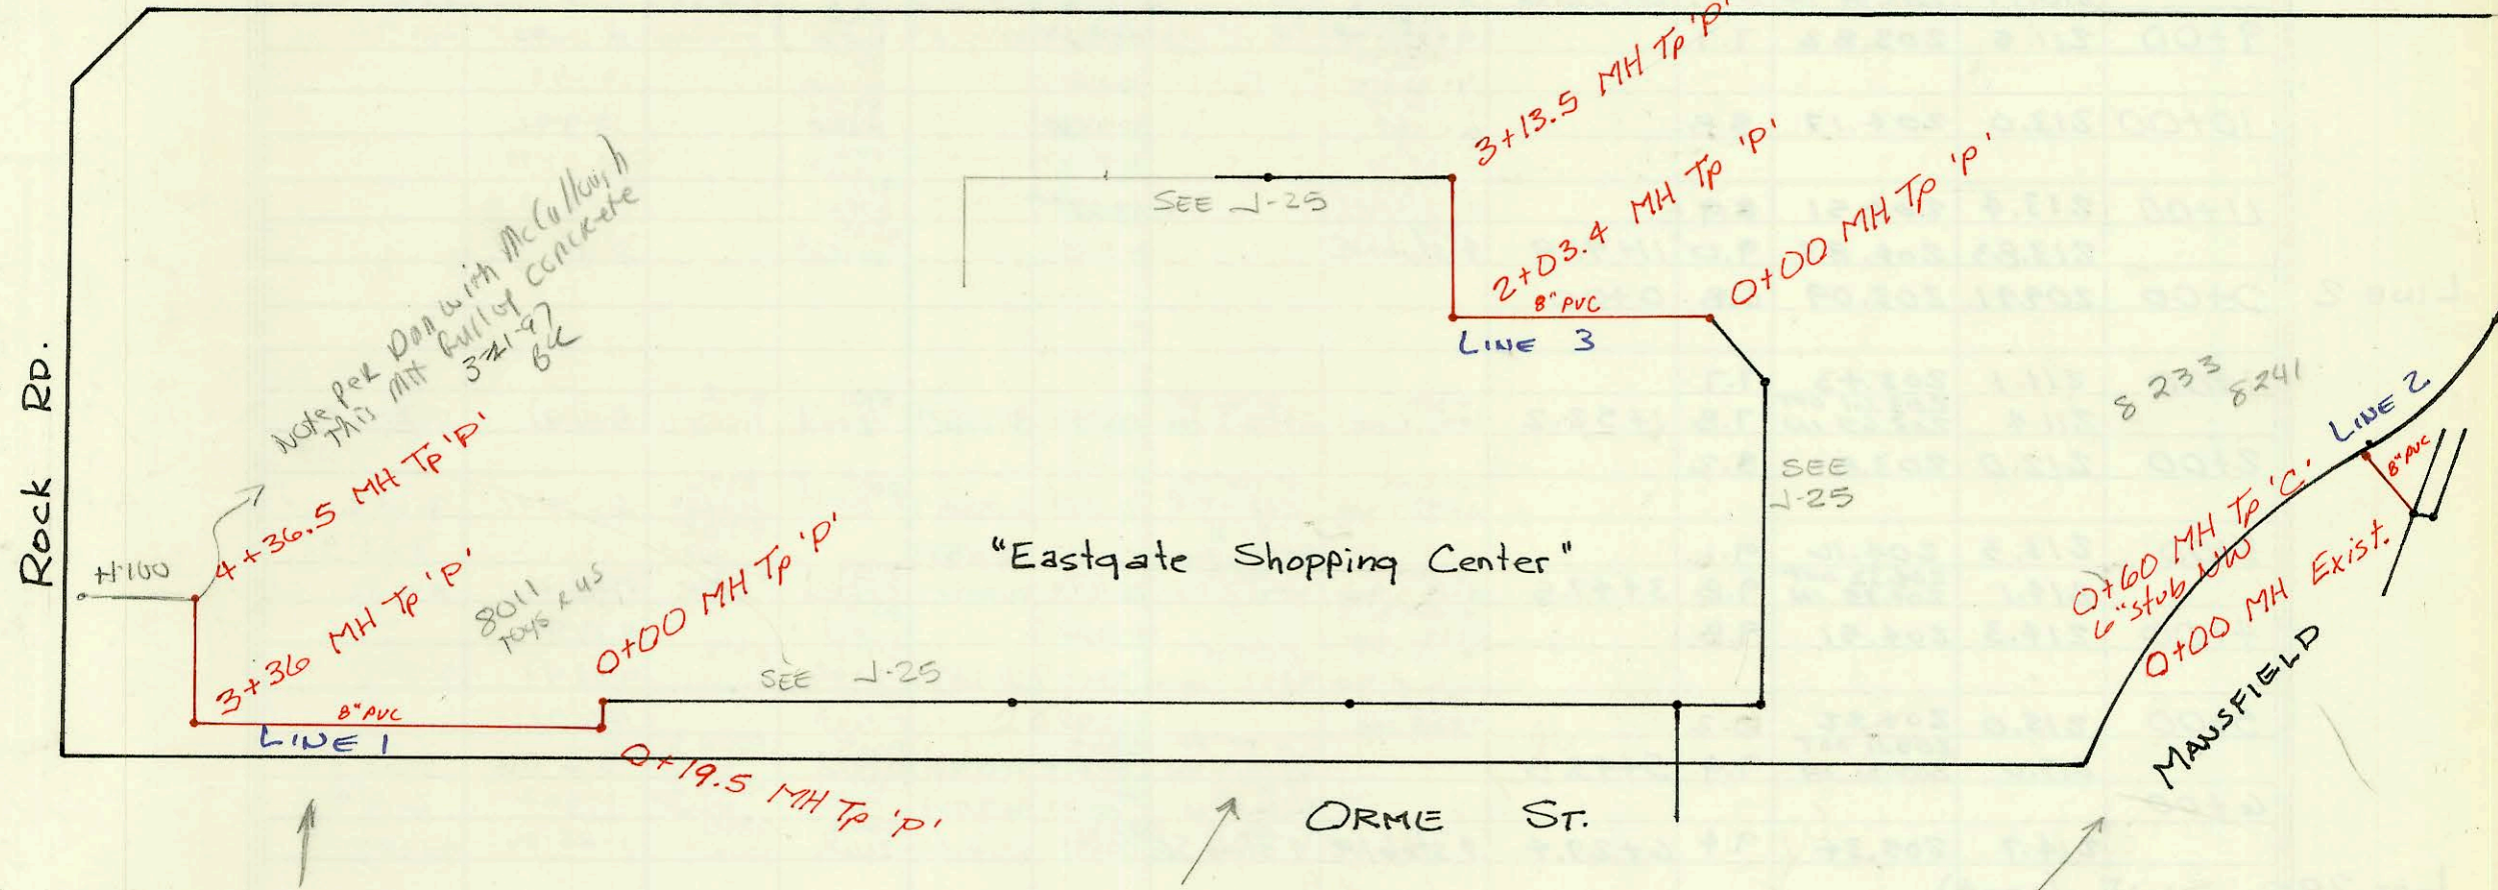

EXTRA - FILED WITH →
 Sewer for Eastgate Shopping Center is privately maintained.
 2191
 BR

Priv. S.S. for Eastgate Shopping Center, BLDG. 'L'
 258PPS Built By W.B. Carter
 Booked 2-4-91 from As Built Plan

Priv. San. Sewer for Eastgate Shopping Center
 224 PPW Built By Ricks Plumbing
 Booked 2-4-91 from As Built Plan

SWR 2000-01433 Kellogg 8241 & Kellogg (Playto's closet at Eastgate) - Jerry Parkshoe
 plog - New line to tie back to first service line &

CONSTRUCTION RECORD						SERVICE RECORD						
STATION	ELEVATION		Depth	MANHOLE	4-INCH "Y" BRANCHES		No. of Permit		House Number		DATE OF PERMITS	
	Ground	Grade			North West	South East	North West	South East	North West	South East	North West	South East
LAT 277 SW												
LINE 1												
0+00	163.40	153.19	10.2	EXIST 0+00								
	163.6	154.00	9.6	0+75.1								
1+00	163.5	154.15	9.4		4" SDR 35 1+33.6 TAP	4" SDR 35 1+23.1 TOP	91-34318-7	91-29607-7	2006 SUNRIDGE	2052 SUNRIDGE	10-1-91	8-12-91
					4" SDR 35 2+35.7 TAP	4" SDR 35 1+59.7 TAP	92-13317-7	92-5304-7	2010 SUNRIDGE	12122 W 19TH	7-15-92	4-16-92
2+00	164.5	154.75	9.8		4" SDR 35 2+80.6 TAP	4" SDR 35 2+39.1 TAP	92-24468-7	92-9626-7	2014 SUNRIDGE	12118 W 19TH	8-26-92	6-26-92
					4" SDR 35 3+66.1 TAP	4" SDR 35 3+71.1 TAP	91-21692-7	91-4847-7	2018 SUNRIDGE	12114 W. 19TH NO	5-6-91	3-18-91
3+00	165.5	155.35	10.2									
					4" SDR 35 4+14.6 TAP	4" SDR 35 4+34.1 TAP	93-71057-7	92-5799-7	2022 SUNRIDGE	12110 W 19TH	3-21-93	4-24-92
4+00	166.5	155.95	10.6									
	167.1	156.10	11.0	4+25.1			92-32177-7	91-34222-7	2006 SUNRIDGE	12106 W 19TH	9-25-92	10-1-91
5+00	167.5	156.55	11.0		4" SDR 35 5+17.1 TAP	4" SDR 35 5+108.0 TAP	2-7360	91-36551-7	2000 SUNRIDGE	12102 W 19TH	3-28-91	10-23-91
					4" SDR 35 6+00.5 TAP	4" SDR 35 5+91.1 TAP	91-36054-7	92-5309-7	2034 SUNRIDGE	12014 W 19TH	10-23-91	4-16-92
6+00	168.5	157.15	11.4				91-29662-7	92-6445-1	2038 SUNRIDGE	12010 W. 19TH	7-22-91	4-30-92
					4" SDR 35 7+00.9 TAP	4" SDR 35 6+95.5 TAP	92-17017-7	92-13344-7	2042 SUNRIDGE	12006 W 19TH	1-31-92	7-15-92
7+00	168.6	157.75	10.9									
	168.3	158.28	10.0	7+88.5				91-18527-7		12002 W 19TH		6-18-93
8+00	168.0	158.35	9.7									
	168.5	158.75	9.8	8+66.5	4" stub NW				2046 SUNRIDGE		7-29-91	
LINE 2												
0+00	164.28	152.48	11.8	EXIST 0+00								
					5" SDR 35 6+46.0 TAP				2007 SUNRIDGE		5-13-91	
1+00	164.2	153.59	10.6									
					4" SDR 35 1+39.0 TAP	4" SDR 35 4" SDR 35	23931-7		2003 SUNRIDGE		6-10-91	
2+00	165.0	154.71	10.3		4" SDR 35 2+57.5 TAP		91-29611-7		18187 W 19TH		2-12-91	
	166.0	155.71	10.3	2+90.0								
3+00	165.7	155.75	10.0		4" SDR 35 3+10.5 TAP		91-34317-7		12123 W 19TH		10-1-91	
					4" SDR 35 3+81.0 TAP		19488-7		12119 W 19TH NO		3-18-91	
4+00	166.0	156.15	9.9									
					4" SDR 35 4+56.5 TAP		91-34319-7		12115 W 19TH		10-1-91	
5+00	166.0	156.55	9.5		4" SDR 35 5+06.4 TAP		92-2655-7		12111 W 19TH		9-1-92	
	166.9	156.88	10.0	5+80.0	4" SDR 35 5+50.0 TAP		92-9625-7		12107 W 19TH		6-26-92	
6+00	166.6	156.95	9.7				91-3125-7		12153 W 19TH		12-16-91	
					4" SDR 35 6+95.0 TAP		92-24469-7		12015 W 19TH		8-26-92	
7+00	167.3	157.35	10.0		4" SDR 35 7+31.0 TAP		92-9627-7		12007 W 19TH		6-26-92	
					4" SDR 35 8+22.0 TAP		92-9651-7		12007 W 19TH		6-18-92	
8+00	168.2	157.75	10.5									
	168.6	158.00	10.6	8+60.9	4" stub N	8+55.9 TAP	93-7104-7	00004	12003 W 19TH	1959 W 19TH	3-31-93	4-11-91
PRIV. Sewer for EASTGATE SHOPPING CENTER												
LINE 1												
0+00	155.5	147.91	7.6	0+00	6" stub N				801 E Kellberg		5-21-90	
	155.5	148.01 OUT 148.21 IN	7.5	0+19.5			85358					
1+00	156.4	148.61	7.8									
2+00	157.4	149.12	8.3									
3+00	158.5	149.62	8.9									
	158.2	149.80 OUT 150.00 IN	8.4	3+36								
4+00	160.5	150.96	9.5									
	160.5	151.50	9.0	4+36.5								
LINE 2												
0+00	138.52	131.07	7.5	0+00					8233-41 E Kellberg		6-7-90	
	142.62	135.32	7.3	0+60.0	6" stub NW		25480					
LINE 3												
0+00	153.42	139.61	13.8	0+00								
1+00	155.0	139.97	15.0									
2+00												
	156.14	140.35 OUT 140.46 IN	15.8	2+03.4								
3+00	155.19	140.89	14.3	3+13.5								