


37th St. No.

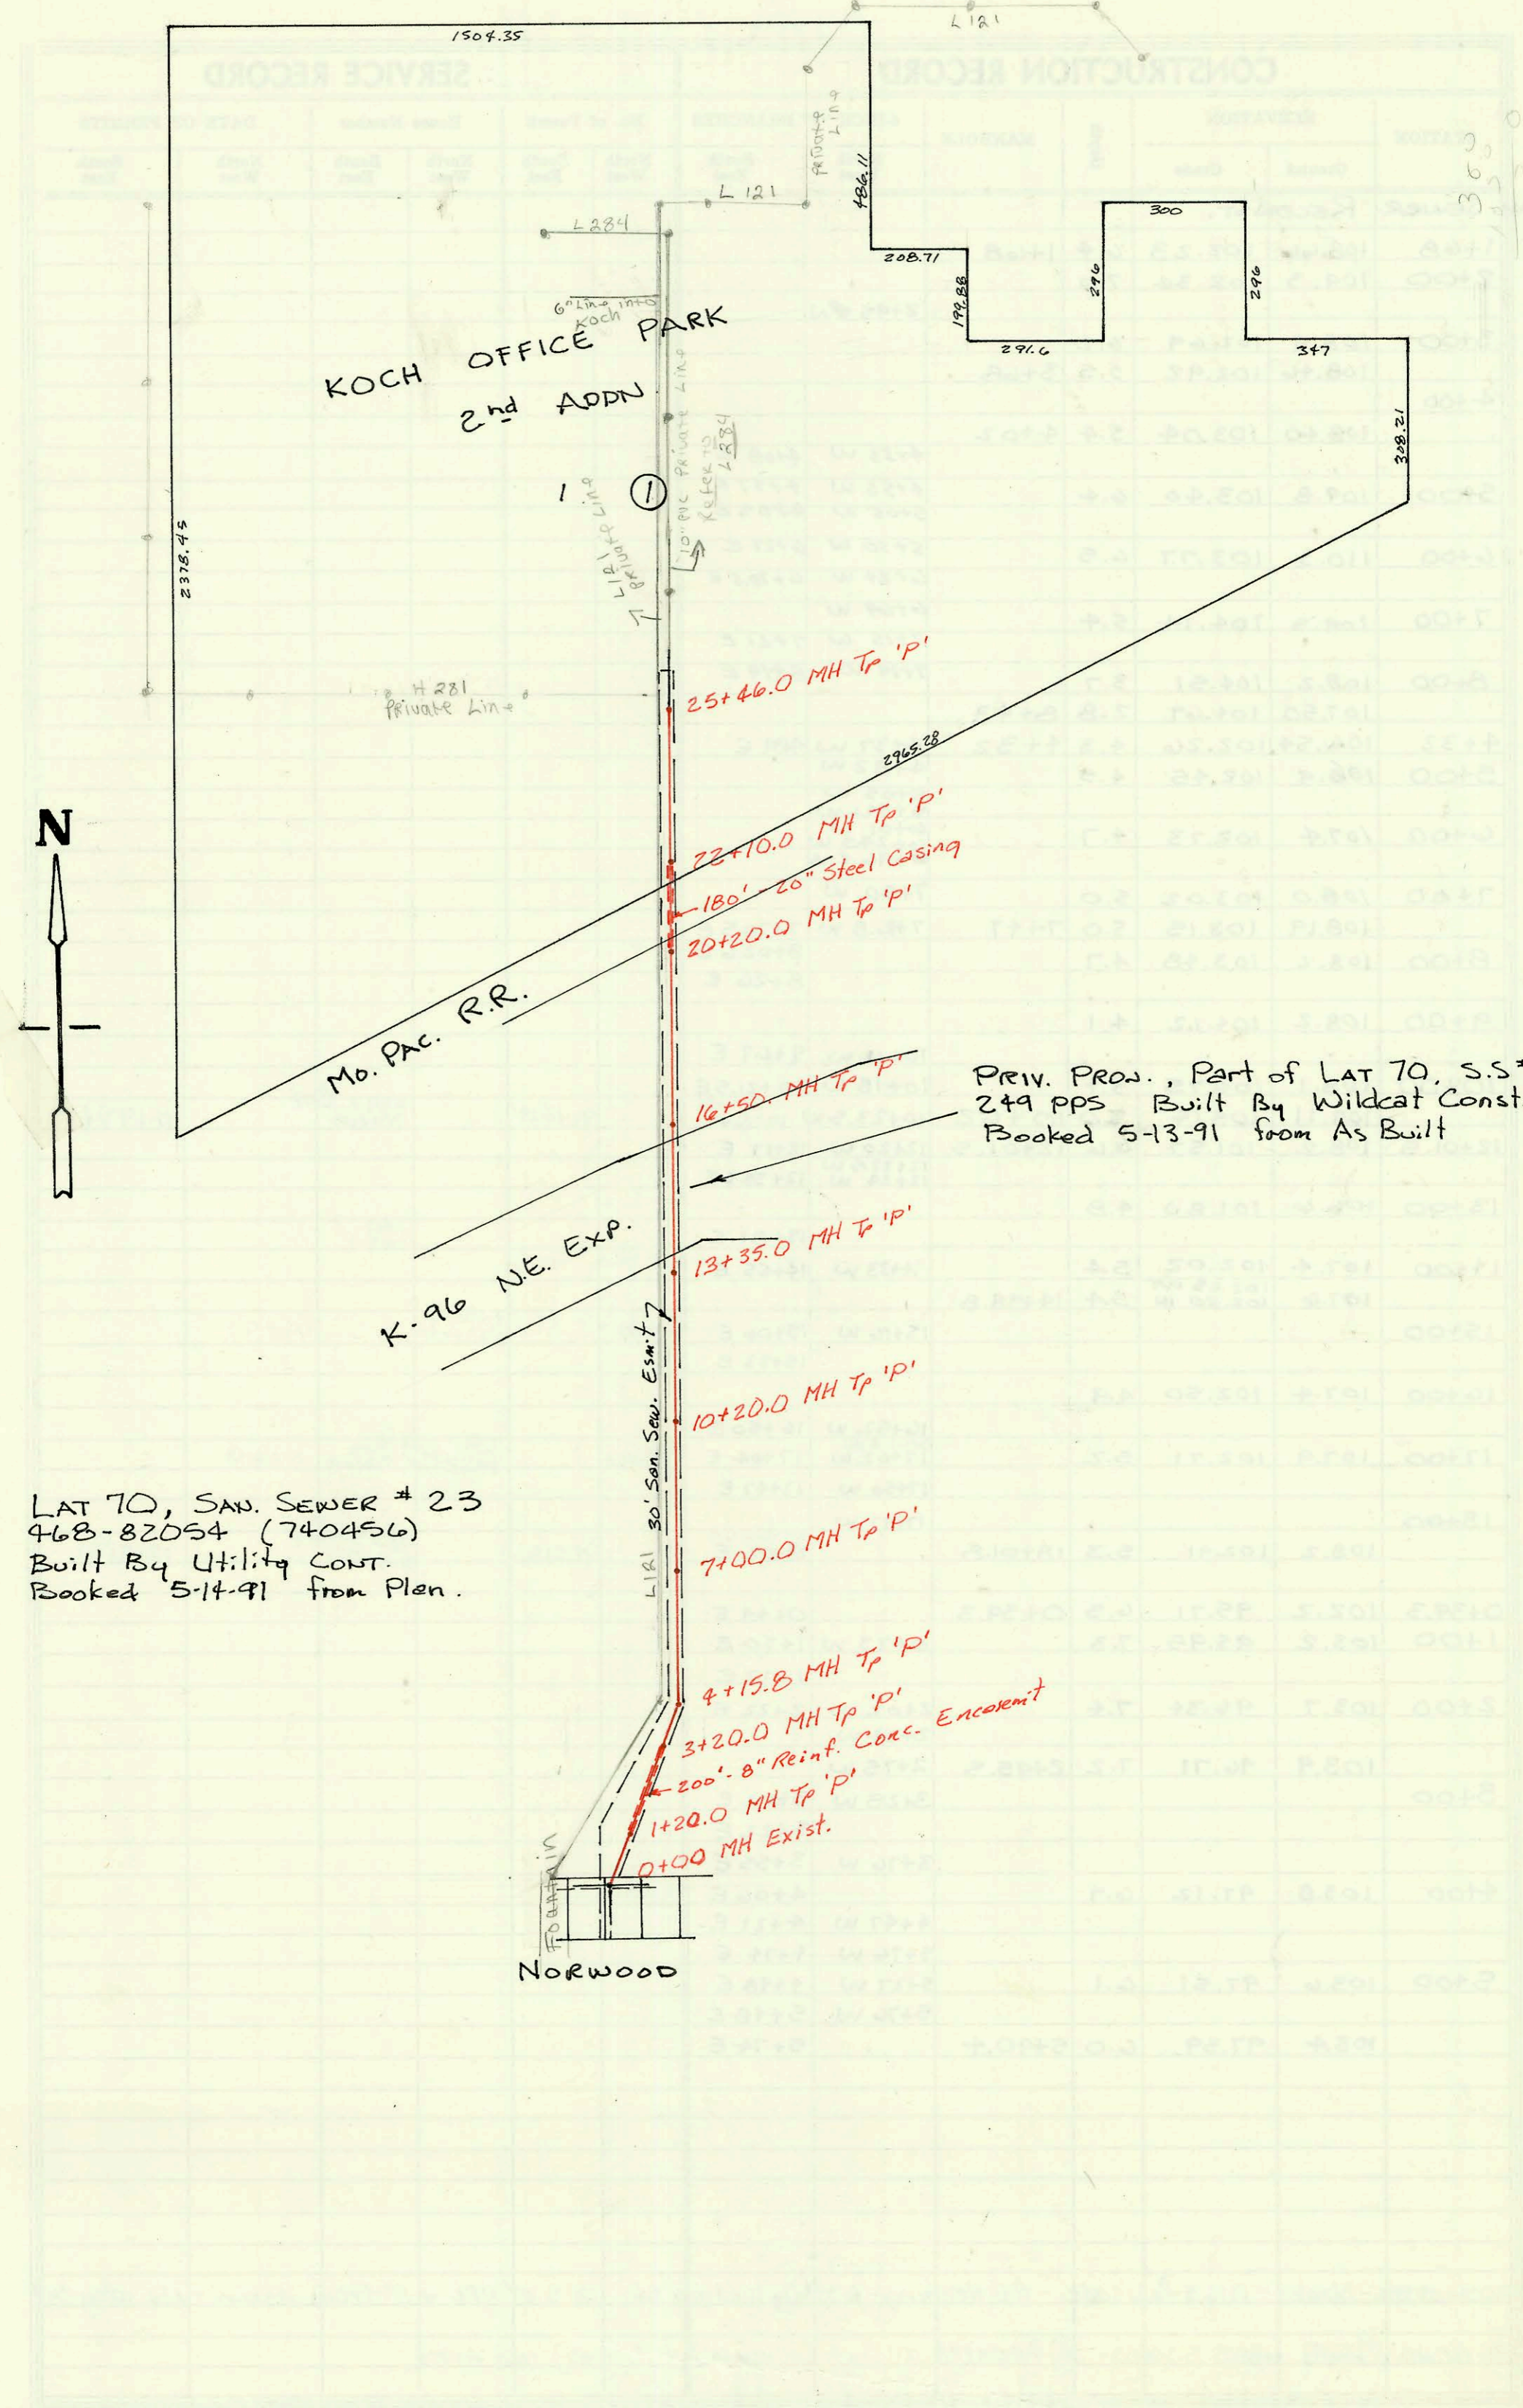

LAT 70, SAN. SEWER # 23
 468-82054 (740456)
 Built By Utility CONT.
 Booked 5-14-91 from Plan.

Priv. Prop., Part of LAT 70, S.S.#23
 249 PPS Built By Wildcat Const.
 Booked 5-13-91 from As Built

NORWOOD

CONSTRUCTION RECORD

SERVICE RECORD

LAT 70

STATION	ELEVATION		Depth	MANHOLE	4-INCH "Y" BRANCHES		No. of Permit		House Number		DATE OF PERMITS	
	Ground	Grade			North West	South East	North West	South East	North West	South East	North West	South East
S.S. # 23												
0+00	159.35	147.00	12.4	0+00								
1+00	159.2	147.50	11.7									
	159.6	147.60	12.0	1+20.0								
2+00	155.6	148.00	7.6									
3+00	159.0	148.50	10.5									
	160.1	148.60	11.5	3+20.0								
4+00	161.8	149.00	12.8									
	163.0	149.08 ^{OUT} 149.18 ^{IN}	13.9	4+15.8								
5+00	163.0	149.60	13.4									
6+00	165.1	150.10	15.0									
7+00												
	167.8	150.60	17.2	7+00.0								
8+00	166.2	151.10	15.1									
9+00	165.8	151.60	14.2									
10+00	166.1	152.10	14.0									
	166.6	152.20	14.4	10+20.0								
11+00	166.7	152.60	14.1									
12+00	166.1	153.10	13.0									
13+00	166.0	153.60	12.4									
	166.2	153.78 ^{OUT} 154.78 ^{IN}	12.4	13+35.0								
14+00	165.8	155.10	10.7									
15+00	167.0	155.60	11.4									
16+00	168.1	156.10	12.0									
	168.5	156.35	12.2	16+50.0								
17+00	168.1	156.60	11.5									
18+00	168.7	157.10	11.6									
19+00	170.1	157.60	12.5									
20+00	170.7	158.10	12.4									
	171.5	158.20 ^{OUT} 159.20 ^{IN}	13.3	20+20.0								
21+00	173.1	159.60	13.5									
22+00	171.5	160.10	11.4									
	171.8	160.15	11.7	22+10.0								
23+00	171.8	160.60	11.2									
24+00	173.0	161.10	11.9									
25+00	173.8	161.60	12.2									
	174.5	161.83	12.7	25+46.0								