
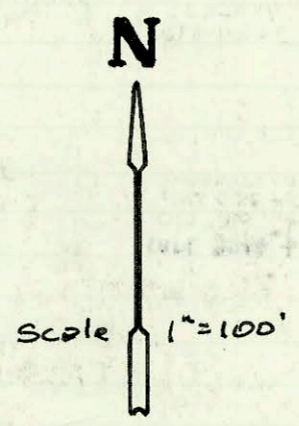


LAT 28, MAIN 12, SW I.  
468-82105 (740738)  
Built By NOWAK  
Booked 10-23-91 from Plan

119th St. W.

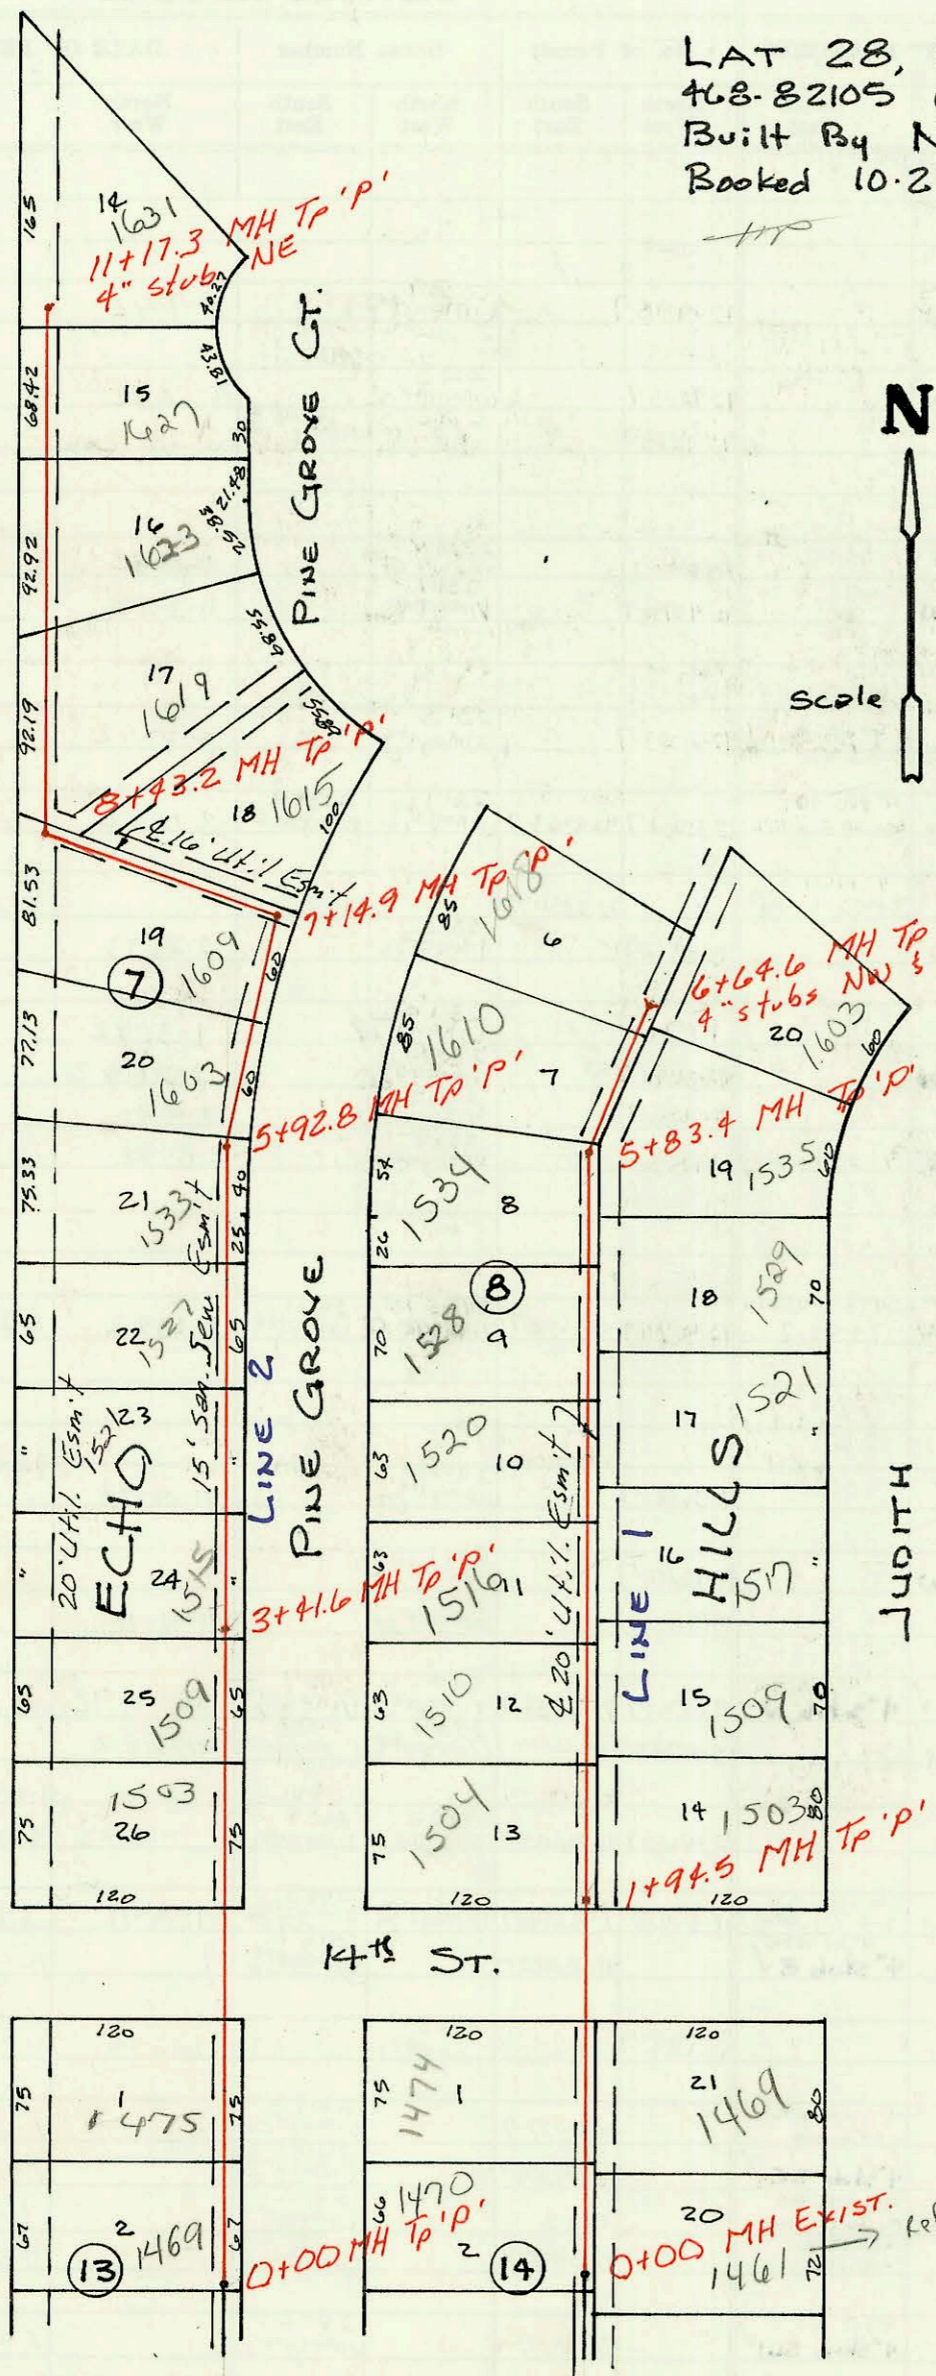

CONSTRUCTION RECORD

LINE	STATION	DATE	DESCRIPTION
Line 1	0+00		
Line 1	0+10		
Line 1	0+20		
Line 1	0+30		
Line 1	0+40		
Line 1	0+50		
Line 1	0+60		
Line 1	0+70		
Line 1	0+80		
Line 1	0+90		
Line 1	1+00		
Line 1	1+10		
Line 1	1+20		
Line 1	1+30		
Line 1	1+40		
Line 1	1+50		
Line 1	1+60		
Line 1	1+70		
Line 1	1+80		
Line 1	1+90		
Line 1	2+00		
Line 1	2+10		
Line 1	2+20		
Line 1	2+30		
Line 1	2+40		
Line 1	2+50		
Line 1	2+60		
Line 1	2+70		
Line 1	2+80		
Line 1	2+90		
Line 1	3+00		
Line 1	3+10		
Line 1	3+20		
Line 1	3+30		
Line 1	3+40		
Line 1	3+50		
Line 1	3+60		
Line 1	3+70		
Line 1	3+80		
Line 1	3+90		
Line 1	4+00		
Line 1	4+10		
Line 1	4+20		
Line 1	4+30		
Line 1	4+40		
Line 1	4+50		
Line 1	4+60		
Line 1	4+70		
Line 1	4+80		
Line 1	4+90		
Line 1	5+00		
Line 1	5+10		
Line 1	5+20		
Line 1	5+30		
Line 1	5+40		
Line 1	5+50		
Line 1	5+60		
Line 1	5+70		
Line 1	5+80		
Line 1	5+90		
Line 1	6+00		
Line 1	6+10		
Line 1	6+20		
Line 1	6+30		
Line 1	6+40		
Line 1	6+50		
Line 1	6+60		
Line 1	6+70		
Line 1	6+80		
Line 1	6+90		
Line 1	7+00		
Line 1	7+10		
Line 1	7+20		
Line 1	7+30		
Line 1	7+40		
Line 1	7+50		
Line 1	7+60		
Line 1	7+70		
Line 1	7+80		
Line 1	7+90		
Line 1	8+00		
Line 1	8+10		
Line 1	8+20		
Line 1	8+30		
Line 1	8+40		
Line 1	8+50		
Line 1	8+60		
Line 1	8+70		
Line 1	8+80		
Line 1	8+90		
Line 1	9+00		
Line 1	9+10		
Line 1	9+20		
Line 1	9+30		
Line 1	9+40		
Line 1	9+50		
Line 1	9+60		
Line 1	9+70		
Line 1	9+80		
Line 1	9+90		
Line 1	10+00		
Line 1	10+10		
Line 1	10+20		
Line 1	37+30		
Line 1	37+40		
Line 1	37+50		
Line 1	37+60		
Line 1	37+70		
Line 1	37+80		
Line 1	37+90		
Line 1	38+00		
Line 1	38+10		
Line 1	38+20		
Line 1			

CONSTRUCTION RECORD

SERVICE RECORD

LAT 28  
LINE 1

LINE 2

STATION	ELEVATION		Depth	MANHOLE	4-INCH "Y" BRANCHES		No. of Permit		House Number		DATE OF PERMITS	
	Ground	Grade			North West	South East	North West	South East	North West	South East	North West	South East
0+00	164.30	152.70	11.6	0+00	4" SDR 35 0+37.0 tap		91-35618-7		1479 Pine Grove		10-17-91	
1+00	163.8	153.10	10.7		4" sch 40 PVC 1+22.5 tap	4" SDR 35 0+96.0 tap	92-2532-7	91-27944-7	1474 Pine Grove	1469 Judith	6-11-92	11-15-91
2+00	163.5	153.48	10.0	1+94.5	4" PVC 40 2+22.5 tap	4" SDR 35 2+09.5 tap	92-00915-7	91-25508-7	1504 Pine Grove	1595 Judith	1-10-92	10-18-91
3+00	164.2	153.90	10.3		4" SDR 35 2+91.5 tap	4" SDR 35 3+12.4 tap	92-475-7	2007	1510 Pine Grove	1509 Judith	10-30-91	1-31-92
4+00	165.0	154.30	10.7		4" SDR 35 3+65.5 tap	4" PVC 40 3+92.4 tap	92-39131-7	92-25947-7	1516 Pine Grove	1517 N. Judith	12-16-91	10-29-92
5+00	165.4	154.70	10.7		4" PVC 40 4+22.5 tap	4" SDR 35 4+41.4 tap	92-1982-7	93-6620-7	1523 Pine Grove	1521 N Judith	2-11-92	3-25-93
6+00	166.6	155.10	11.5	5+83.4	4" SDR 35 5+77.4 tap	4" PVC 40 4+22.5 tap	92-1422-7	92-3126-7	1531 Pine Grove	1535 Judith	6-7-92	9-22-92
7+00	166.9	155.03	11.9		4" PVC 40 5+77.4 tap	4" SDR 35 4+22.5 tap	92-3126-7	93-7103-7	1610 Pine Grove	1535 Judith	9-22-92	2-31-93
8+00	167.3	155.36	11.9	6+64.6	4" PVC 40 6+76.6 tap	4" SDR 35 4+22.5 tap	92-4477-7	92-2447-7	1608 Pine Grove	1529 Judith	3-31-92	6-10-92
9+00	167.7	155.99	10.4	0+00	4" SDR 35 0+37.5 tap		91-35545-7		1575 Pine Grove		10-17-91	
1+00	164.2	153.49	10.7		4" SDR 35 0+13.5 tap		1659		1469 Pine Grove		12-10-91	
2+00	165.1	153.99	11.1		4" SDR 35 2+22.6 tap		91-35567-7		1500 Pine Grove		10-18-91	
3+00	165.0	154.49	10.5		4" PVC 40 3+62.9 tap		92-3463-7		1509 Pine Grove		3-11-92	
4+00	165.3	154.70	10.6	3+41.6	4" PVC 40 4+16.9 tap		2138		1521 Pine Grove		2-18-92	
5+00	165.6	155.49	10.1		4" SDR 35 5+09.7 tap		92-4267-7		1529 N Pine Grove		3-26-92	
6+00	166.1	155.95	10.2	5+92.8	4" SDR 35 5+57.9 tap		92-4266-7		1503 Pine Grove		8-26-92	
7+00	166.1	156.38	9.7		4" PVC 40 7+17.3 tap		92-35095-7		1603 Pine Grove		10-2-92	
8+00	166.3	156.44 OUT 156.64 IN	9.9	7+14.9	4" PVC 40 7+58.5 tap		92-4266-7		1609 N Pine Grove		12-2-92	
9+00	166.8	156.98	9.8		4" SDR 35 8+98.8 tap		2184		1619 N Pine Grove		9-23-92	
10+00	167.6	157.16 OUT 157.36 IN	10.4	8+43.2							2-27-92	
11+00	167.7	157.58	10.1									
12+00	168.5	157.98	10.5		4" PVC 40 10+01.3 tap		92-23732-7		1623 N Pine Grove		8-20-92	
13+00	168.0	158.38	9.6		4" PVC 40 10+69.3 tap		92-35097-7		1627 Pine Grove		10-2-92	
14+00	168.3	158.45	9.9	11+17.3	4" SDR 35 11+17.3 tap		92-43815-7		1631 Pine Grove		12-29-92	