


Lateral 31, Sub. 10, S.S. No. 22  
W.B. Carter Const. Co., Inc. Oct. 1968  
Proj. No. C 27-34 Bk. J.K. #9 Booked 11-20-68

MAP

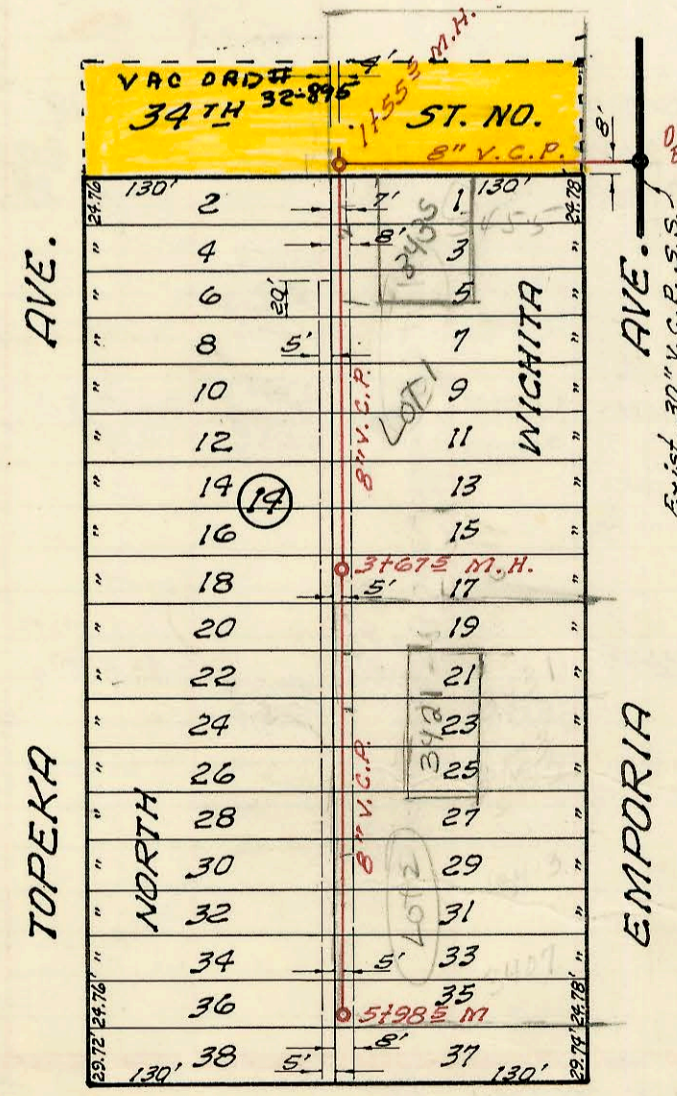

LAT. 62, SUB. 9, S.S. NO. 23  
UTILITY CONTRACTORS, INC.  
PROJ. NO. C27-8 K BOOKED 1-17-68  
11463

CONSTRUCTION RECORD						SERVICE RECORD						
STATION	ELEVATION		Depth	MANHOLE	4-INCH "Y" BRANCHES		No. of Permit		House Number		DATE OF PERMITS	
	Ground	Grade			North West	South East	North West	South East	North West	South East	North West	South East
Lateral 31, Sub. 10, S.S. No. 22												
0+00	128.6	118.97	9.6	Exist. M.H. 0+00	0+27	0+25						
1+00	127.3	119.17	8.2		0+44	0+25	C7145		2001 N. Sheridan			4-25-77
					1+48	1+01	C12638 C59051		2000 N. Gow 2006 N. Gow			2-5-69 12-13-76
2+00	127.6	119.37	8.2		1+80							
	127.8	119.43	8.4	2+24	2+04	2+02	C59052		2012 N. Gow			12-13-76
					2+40	2+38	C70541 C58161		2007 N. SHERIDAN 3013 3014			3-9-79 10-14-76
3+00	126.7	119.57	7.1									
	126.6	119.61	7.0	3+22								
		119.71	6.9									
4+00	126.2	119.87	6.3									
5+00	127.6	120.07	7.5									
	126.2	120.14	6.1	5+33								
6+00	125.6	120.27	5.3									
7+00	124.9	120.47	4.4									
8+00	126.6	120.62	6.0	7+74								
	127.0	120.67	6.3									
9+00	127.1	120.87	6.2									
10+00	127.5	121.07	6.4									
	127.4	121.11	6.3	10+21								
		121.21	6.2									
11+00	127.0	121.46	5.5									
12+00	127.8	121.76	6.0									
13+00	127.5	122.06	5.4									
	127.5	122.07	5.4	13+02								
Lat. 62, Sub. 4, S.S. 23												
0+00	130.5	120.06	10.4	Exist. 0+00								
1+00	130.0	120.46	9.5									
		out 120.68	9.3									
		in 123.22	6.8	1+55								
2+00	129.8	123.38	6.4									
3+00	129.8	123.78	6.0									
4+00	129.7	124.06	5.6	3+67								
	129.9	124.18	5.7									
5+00	129.4	124.58	4.8									
	130.2	124.98	5.2	5+98								

Dep. C 70541 - 2007 N. Sheridan - 3-9-74 (1+41.7) Sub 2003-01209 5-6-03 3421 N Emporia (bldg del) CK CONTRA