


GREEN ACRES MOBILE HOME RESORT
 SANITARY SEWER
 PRIVATE CONTRACT, BK U. K. s.s.#1
 NOV. 20, 1968


M 5 A

SERVICE RECORD

CONSTRUCTION RECORD

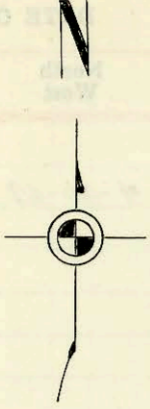

1" = 100'

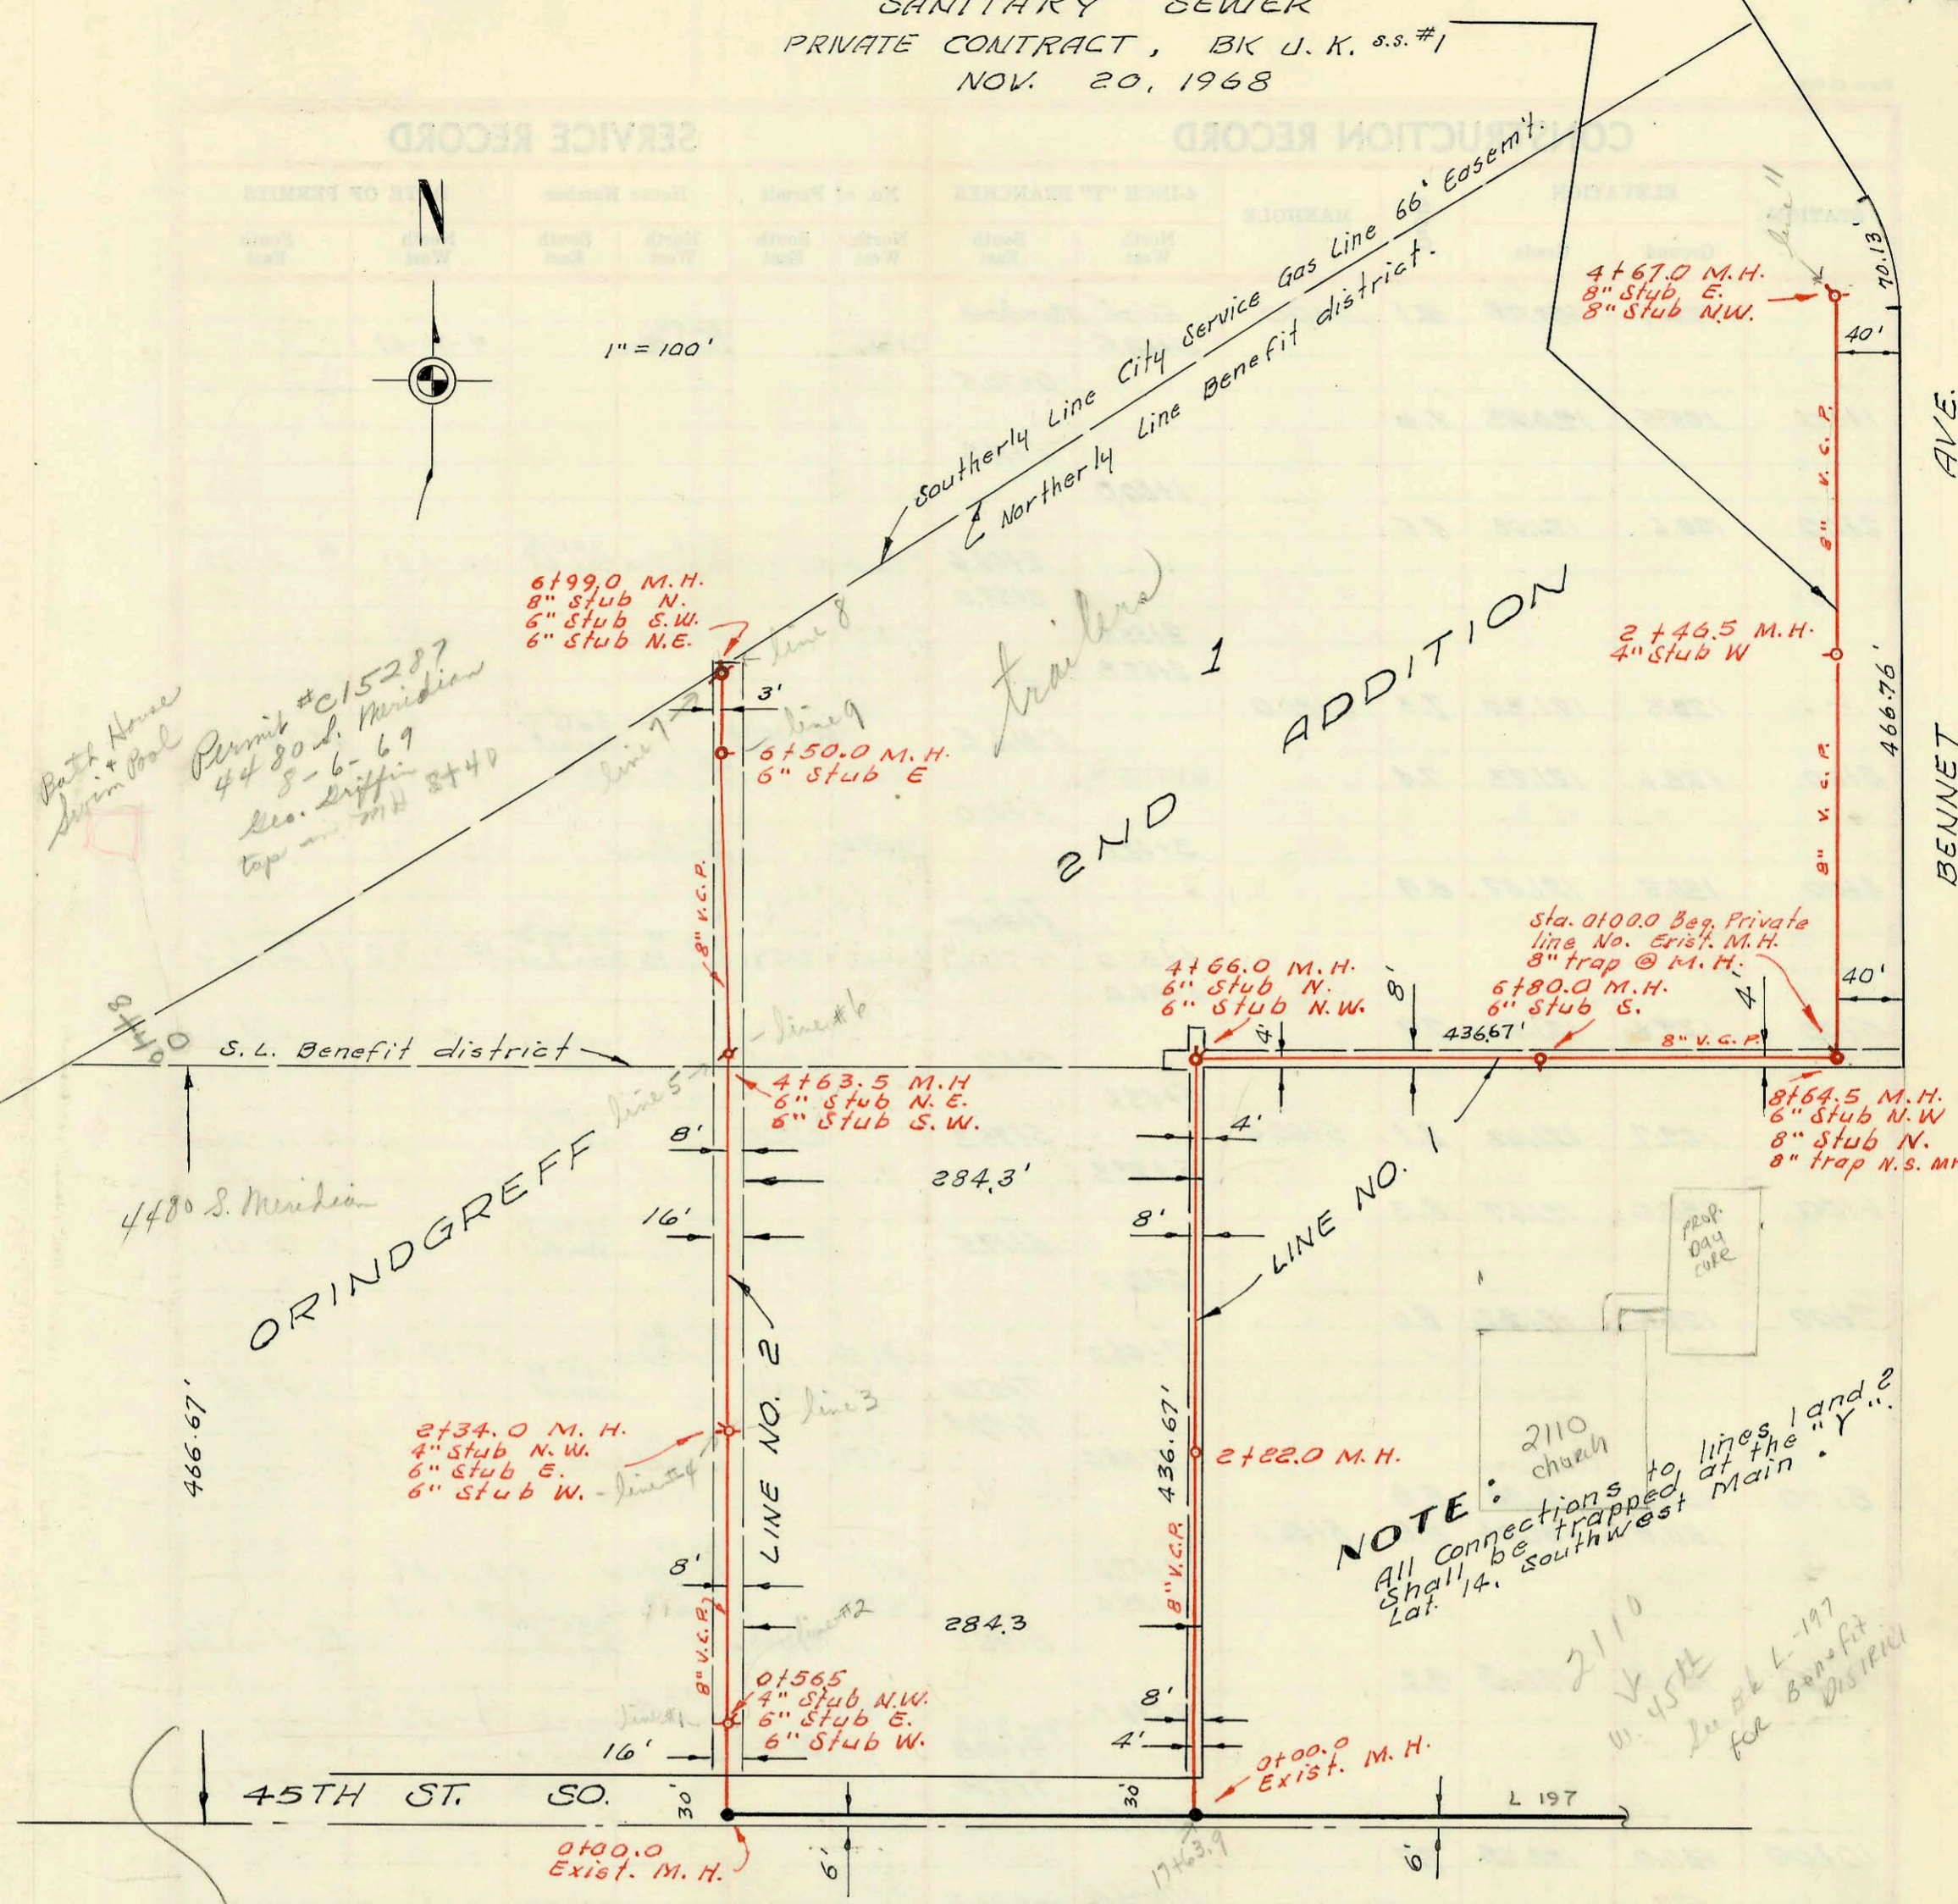

Bath House
 Permit #C15287
 4480 S. Meridian
 8-6-69
 Leo. Driffin
 top of MH 8+40

Trailers

1
 ADDITION

NOTE: 2110 chuan
 All connections to lines 1 and 2 shall be trapped at the southwest corner of the main.

2110
 V-45H
 In #6 L-197
 for Benefit District

2118/08
 4560 S Meridian
 (NE corner of Meridian + 45th)
 Verified by Chris Johnson
 with sewer maint. all
 that this address taps to
 a private line serving
 mobile home park
 just east of a private
 MH on Lot 14
 BSR
 Note 4540 S Meridian
 appears to be in
 septic system

LAT. 14, SOUTHWEST MAIN
 MID-STATES CONST. CO. INC.
 PROJ. NO. C28-66, BK. U. K. #6
 NOV. 20, 1968

CONSTRUCTION RECORD

SERVICE RECORD

STATION	ELEVATION		Depth	MANHOLE	4-INCH "Y" BRANCHES		No. of Permit		House Number		DATE OF PERMITS	
	Ground	Grade			North West	South East	North West	South East	North West	South East	North West	South East
0+00	91.1	81.60 out 81.70 in	9.5 9.3	0+00 ² Exist. M.H.					4480 S. Meridian	(Lot 77)	11-14-68	
1+00	90.5	81.90	8.6		0+32 ⁵ 0+81 ²		#C11463 #C11464		"	(Lot 78)	" " "	
2+00	90.8	82.10	8.7		1+22 ² 1+66 ²		#C11465 #C11466		"	(Lot 79)	" " "	
3+00	90.7	82.30	8.4		2+02 ² 2+44 ⁵ 2+86 ⁵		#C11467 #C11468 C11469		"	(Lot 80)	" " "	
4+00	91.3	82.50	8.8		3+28 ⁵ 3+71 ²		C11470 C11471		"	(Lot 81)	" " "	
5+00	91.9	82.63 out 82.73 in	9.3 9.2	4+66 ²	4+08 ⁵ 4+50 ⁵ 6" stub N. 6" stub NW 4+94 ⁵		C11472 C11473 C11474 C11475 C11476		"	(Lot 82)	" " "	
6+00	92.5	82.80	9.7		5+29.0 ² 5+36 ⁵ 5+74 ²		C11477 C11478	10111	"	(Lot 83)	" " "	2-3-89
7+00	92.1	83.00	9.1		6+00 ⁵ 6+16 ⁵ 6+84 ²		C11479 C11480 C11481		"	(Lot 84)	" " "	
8+00	91.8	83.16	8.8	6+80 ²	6" stub S.		C11482		"	(Lot 85)	" " "	
9+00	91.6	83.20	8.6		7+72 ²		C11483		"	(Lot 86)	" " "	
10+00	91.6	83.40	8.2		8+18 ²		C11484		"	(Lot 87)	" " "	
11+00	91.6	83.53 83.63 stub N	8.1	8+64 ⁵	6" stub NW. 8" stub N.		C11450		"	(Lot 88)	" " "	
12+00	92.0	82.18 out 82.28 in	9.8 9.7	0+00 ² Exist. M.H.								
13+00	92.0	83.39	8.6	0+56 ⁵	4" stub NW 6" stub W.	6" stub E.	C11237 C11256			(Lot 5)	(Lot 27)	" "
14+00	91.8	82.48	9.3		6" stub W.	6" stub E.	C11238 C11255					
15+00	91.6	82.68	8.9		2+34 ²		C11324 C11316			(Lot 47)	(Lot 72)	" "
16+00	91.5	82.75	8.7		4" stub NW 6" stub W.	6" stub E.	C11324 C11316					
17+00	91.2	82.88	8.3		6" stub W.	6" stub E.	C11324 C11316					
18+00	91.4	83.08	8.3		4+63 ⁵		C11448 C11442			(Lot 71)	(Lot 61)	" "
19+00	91.6	83.21	8.4	4+63 ⁵	6" stub NE	6" stub SW	C11448 C11442					
20+00	91.9	83.28	8.6		6" stub NE	6" stub SW	C11448 C11442					
21+00	92.5	83.48	9.0		6+50 ²		C11529 C11558					
22+00	92.5	83.58	8.9	6+50 ²	6" stub E.	6" stub SW	C11529 C11558					
23+00	92.8	83.68	9.1	6+99 ²	8" stub N. 6" stub NE	5" stub SW	C11516 C11528			(Lot 170)	(Lot 146)	" "
24+00	91.6	83.53 out 83.63 in	8.1 8.0	0+00 ² Exist. M.H. 8" trap @ M.H.								
25+00	92.5	84.03	8.5		0+82 ²		C11451		4430 S. Meridian	(Lot 101)	11-14-68	
26+00	92.8	84.43	8.4		1+26 ² 1+46 ² 1+78 ²		#C11453 #C11452 #C11454		4430 S. Meridian	(Lot 104)	11-14-68	
27+00	92.9	84.62	8.3	2+46 ⁵	4" stub W.		C11455		"	(Lot 103)	" " "	
28+00	93.2	84.83	8.4		2+37 ² 2+94 ²		C11455 C11456		"	(Lot 105)	" " "	
29+00	93.4	85.23	8.2		3+51 ² 3+98 ⁵ 4+00 ⁵		#C11457 #C11458		"	(Lot 106)	" " "	
30+00	93.4	85.53	7.9	4+67 ²	4+40 ² 8" stub NW	8" stub E.	C11459		"	(Lot 107)	" " "	
31+00							C11460					

LINE NO. 1

LINE NO. 2

8" lat.

GREEN ACRES MOBILE HOME RESORT
PRIVATE CONTRACT #10

M