





33 RD. ST. NO.

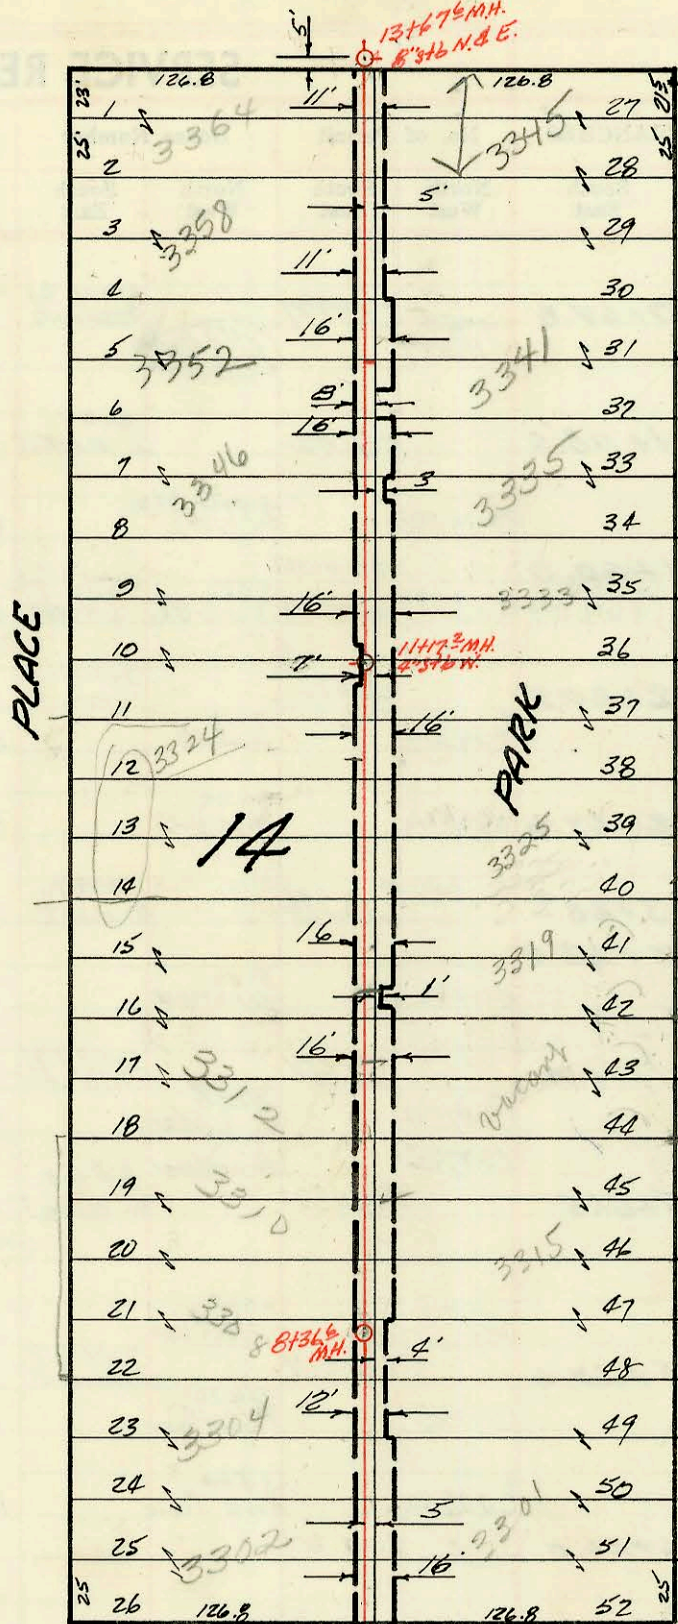

32 NO. ST. NO.

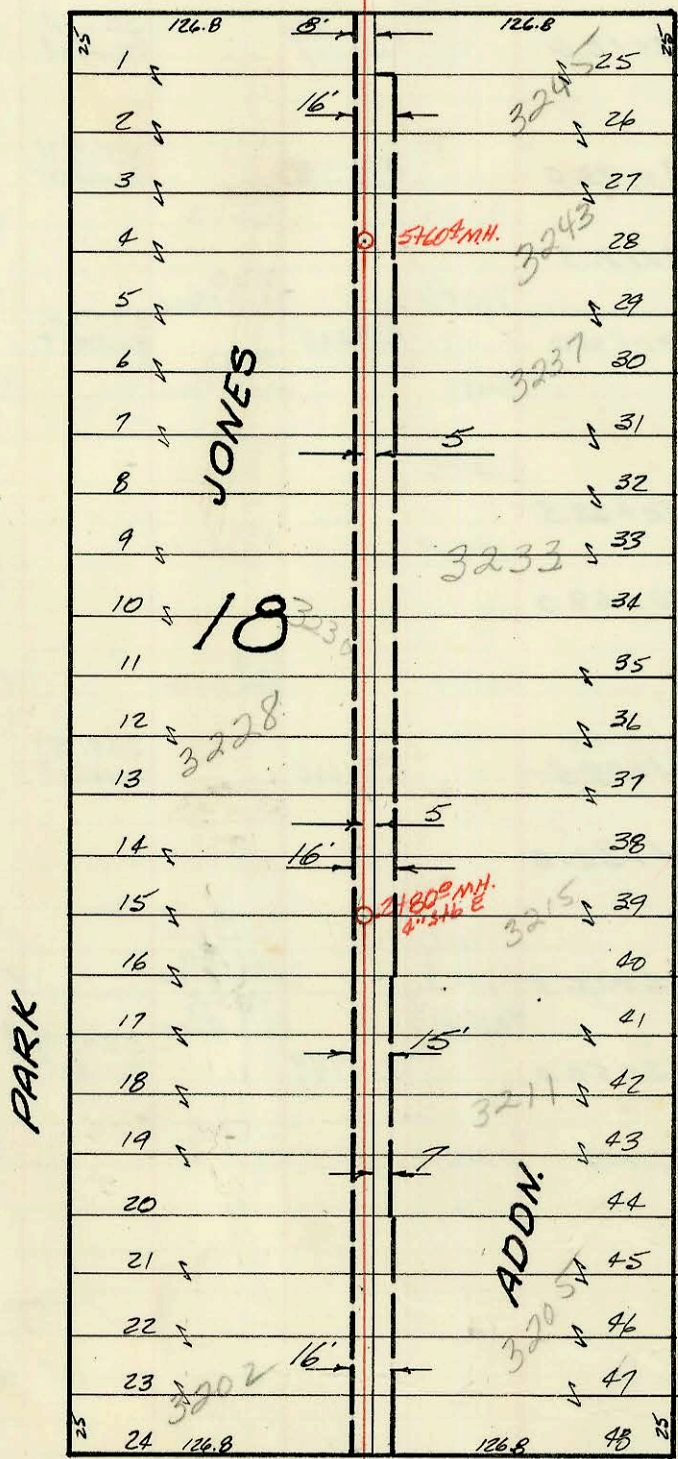

31st. ST. NO.

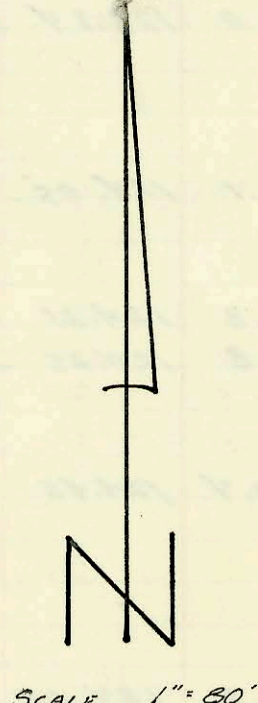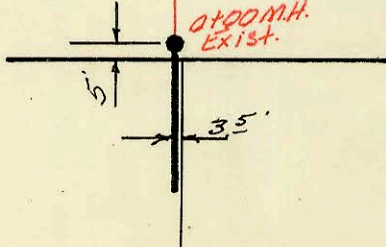

SCALE 1" = 80'

LAT. 31, DIST. "T" S.S. 20  
 W.B. CARTER CONSTR. CO Sert 68  
 Proj. C 22-34 Booked Nov. 68  
 K-82

*Handwritten signature or name*

CONSTRUCTION RECORD

SERVICE RECORD

STATION	ELEVATION		Depth	MANHOLE	4-INCH "Y" BRANCHES		No. of Permit		House Number		DATE OF PERMITS	
	Ground	Grade			North West	South East	North West	South East	North West	South East	North West	South East
	128.9	120.78	8.1	0+00	Exist. Manhole 0+68.5		C13815		3202 Park Place			4-30-69
1+00	128.5	120.93	7.6									
2+00	128.6	121.08	7.5									
	128.5	121.20	7.3	2+80.0								
3+00	128.6	121.23	7.4		3+07.5 4" Sub E.		4850	*C13518	3216 Park Place	3215 N Market		4-15-69
4+00	130.3	121.37	8.9		3+43.0		C22802		3228 Park Place			2-1-71
5+00	129.4	121.52	7.9		4+37.0 4+84.0		C22117	C21591	3230 N Park Pl	3233 N Market		12-9-70
	129.7	121.62	8.1	5+60.4								
6+00	130.0	121.67	8.3									
7+00	129.8	121.82	8.0									
	130.8	121.98	8.8									
8+00	130.8	122.04	8.8	8+36.6								
9+00	131.3	122.13	9.2									
10+00	130.0	122.28	7.7									
11+00	129.3	122.43	7.9									
	129.8	122.46	7.3	11+17.2								
12+00	129.8	122.58	7.2									
13+00	129.4	122.73	6.7									
	129.6	122.85	6.9	13+67.6								
	(122.95)											

\* C15510 - 3205 N. Market - Trailer - Bowen Pkwy. 8-21-69 - tap (1+34)  
 " C15511 - " " " " " (private line conn.) 50' E. of city main  
 " C15512 - " " " " " (private line conn.) 25' E. of city main