
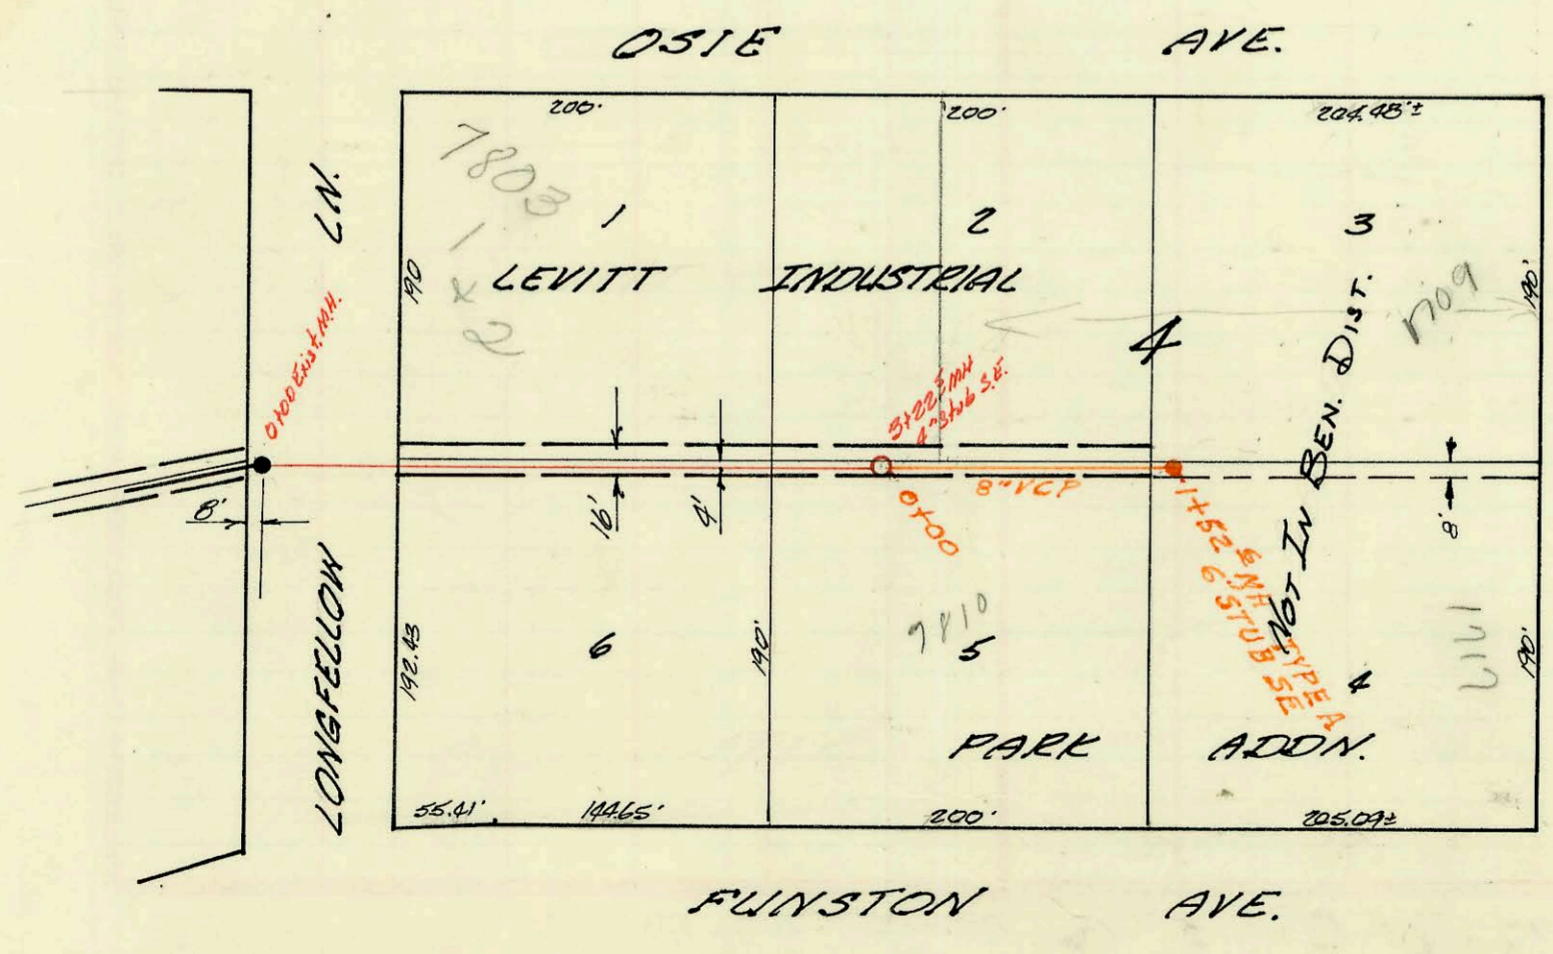


LAT. 14, SUB. 4, S.S. 22  
 W.B. CARTER CONSTR. CO.  
 S.S. JK-2, PROJ. C28-49  
 BOOKED 12-16-68  
 ON MAP

SAN SEWER FOR WALENTA 2ND ADDN  
 BUILT BY:  
 PROJ. NO. DBKW 706061  
 BOOKED 10-12-81 FROM AR 555

SCALE 1"=100'

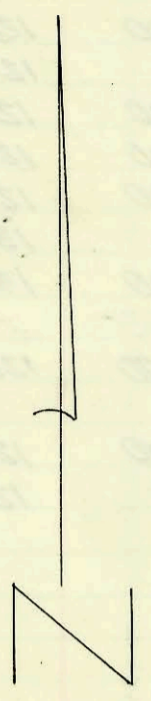

LAT. 3, SUB. 16, W.I.S.  
 W.B. CARTER CONSTR. CO  
 IH - 59 PROJ. C26-66  
 BOOKED 12-16-68  
 SAN SEWER EXT TO KANSAS  
 FEDERAL CREDIT UNION  
 BUILT BY: GEO. PEARSON EXCAV. CO.  
 PROJ. NO. DBKW 707066  
 BOOKED 11-30-78 FROM AR 92

SCALE 1"=100'



