


San. Sewer For Dillions Store #34
 Utility Contractors Inc.
 Private Proj. S.S. JK #3, 12-17-68

021 map

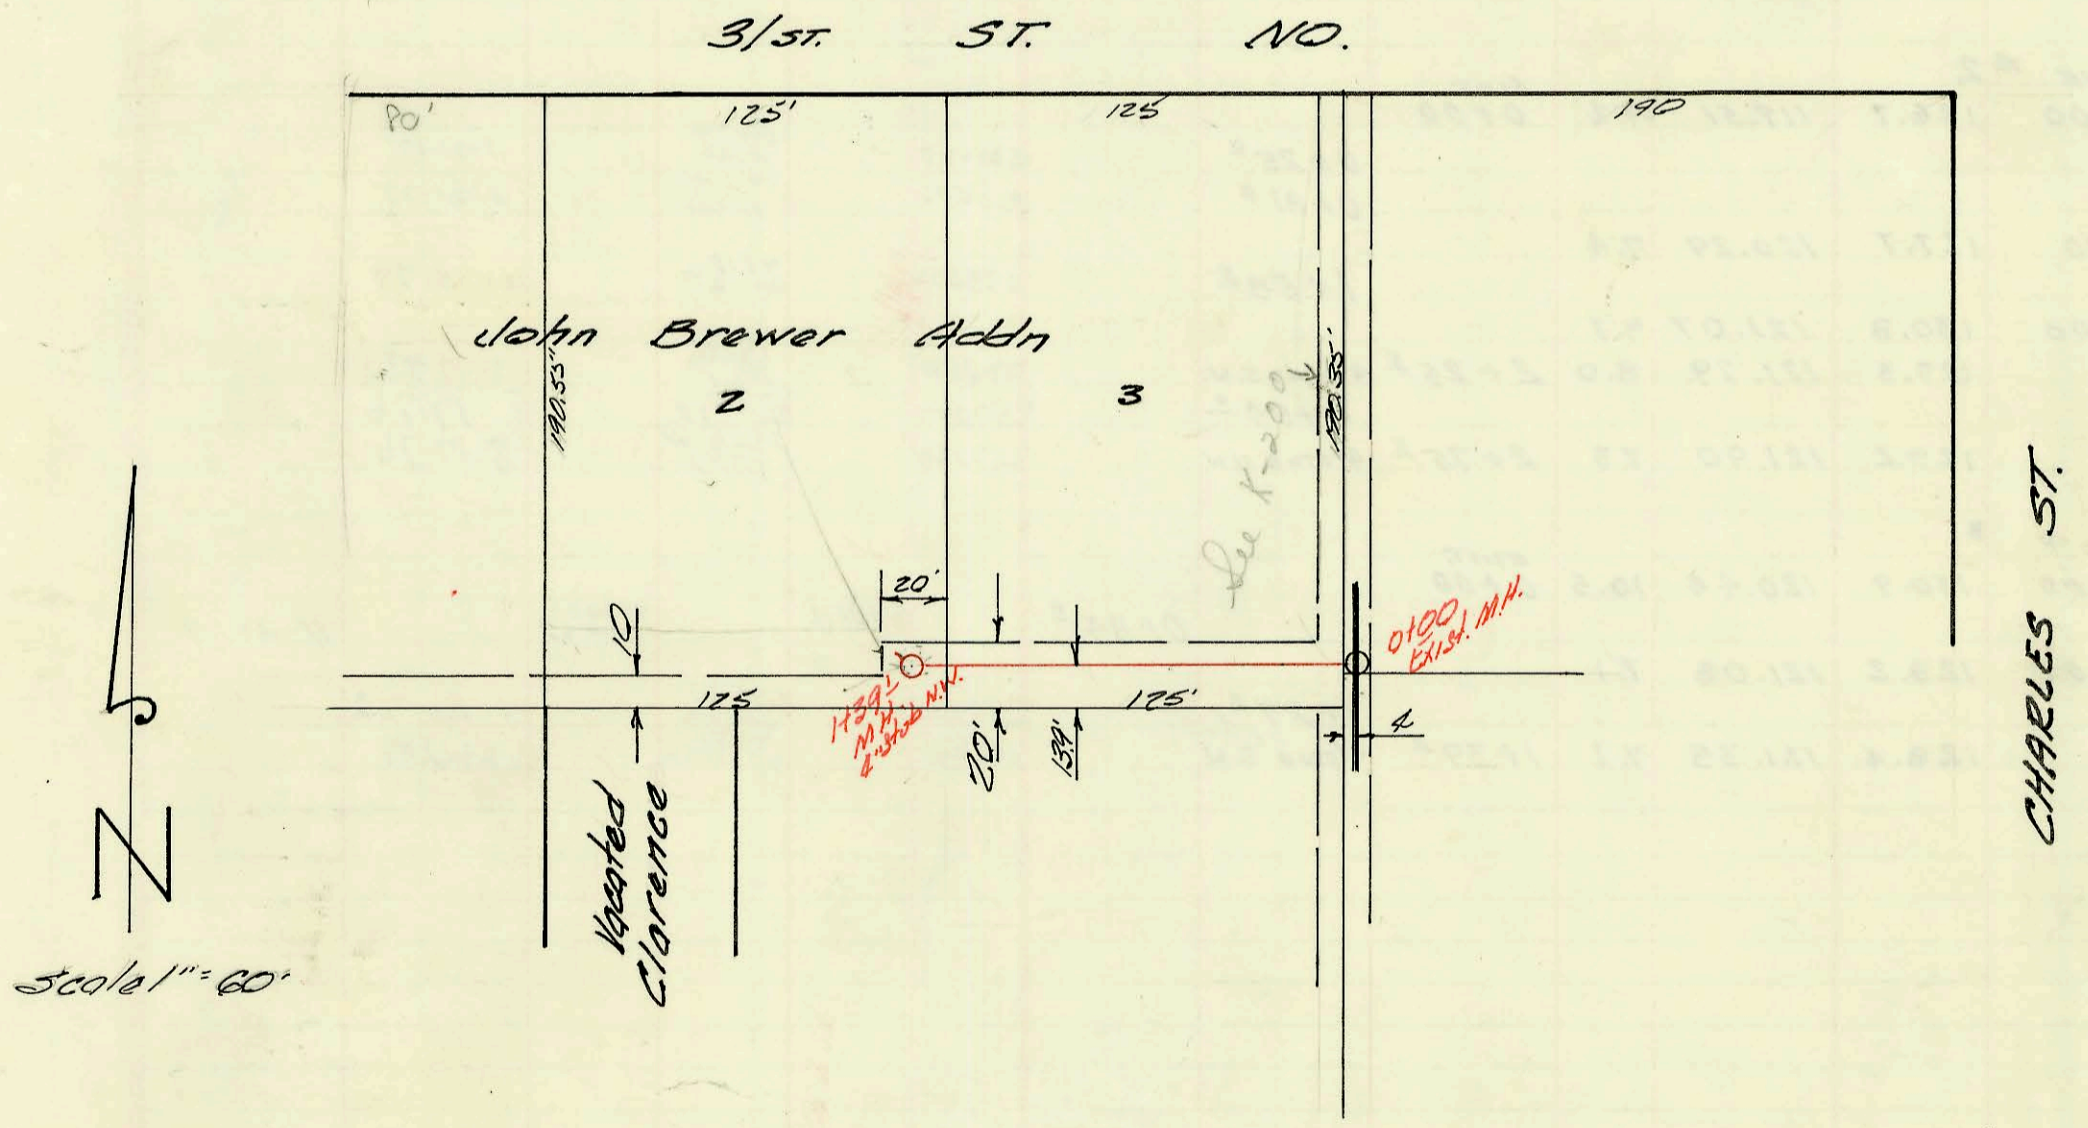

Ext. To LAT. 18, SUB. 17, S.S. #22
 MID STATES CONSTE. CO. INC.
 K-73, Priv. Proj. 12-17-68

021 map

