
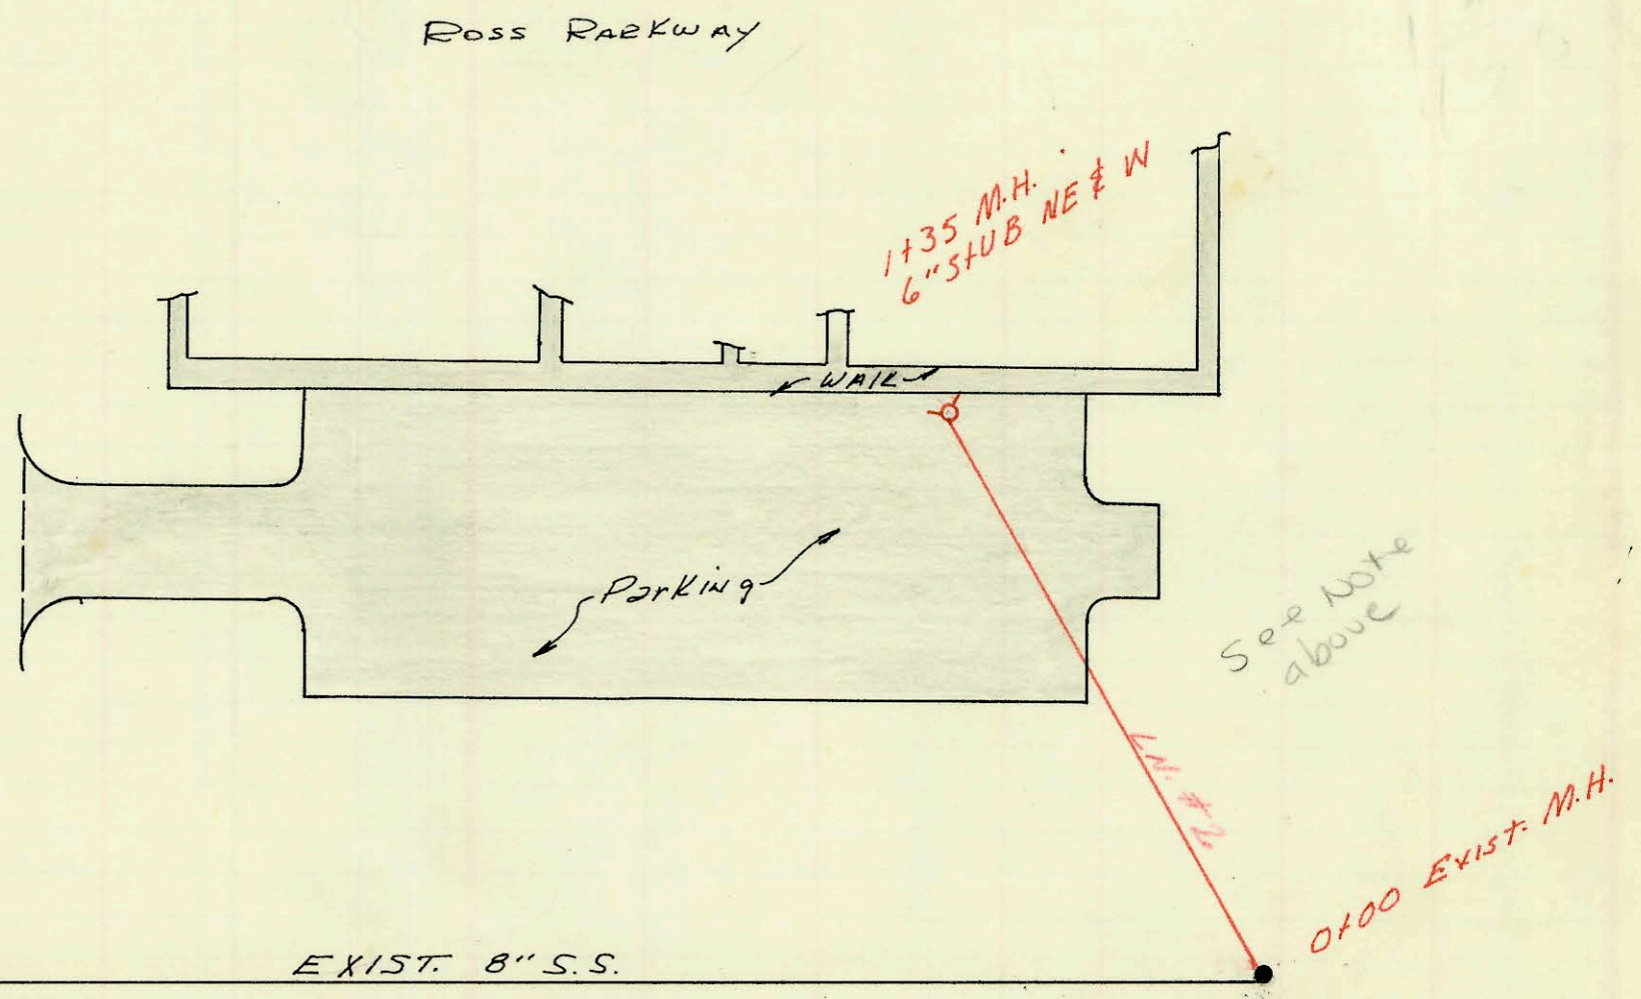
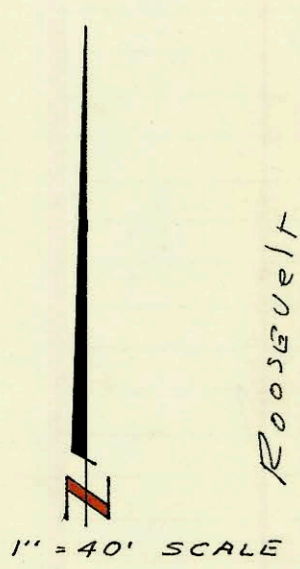


Bldgs are
9 TO 10
NOT SEEN

3703
3705

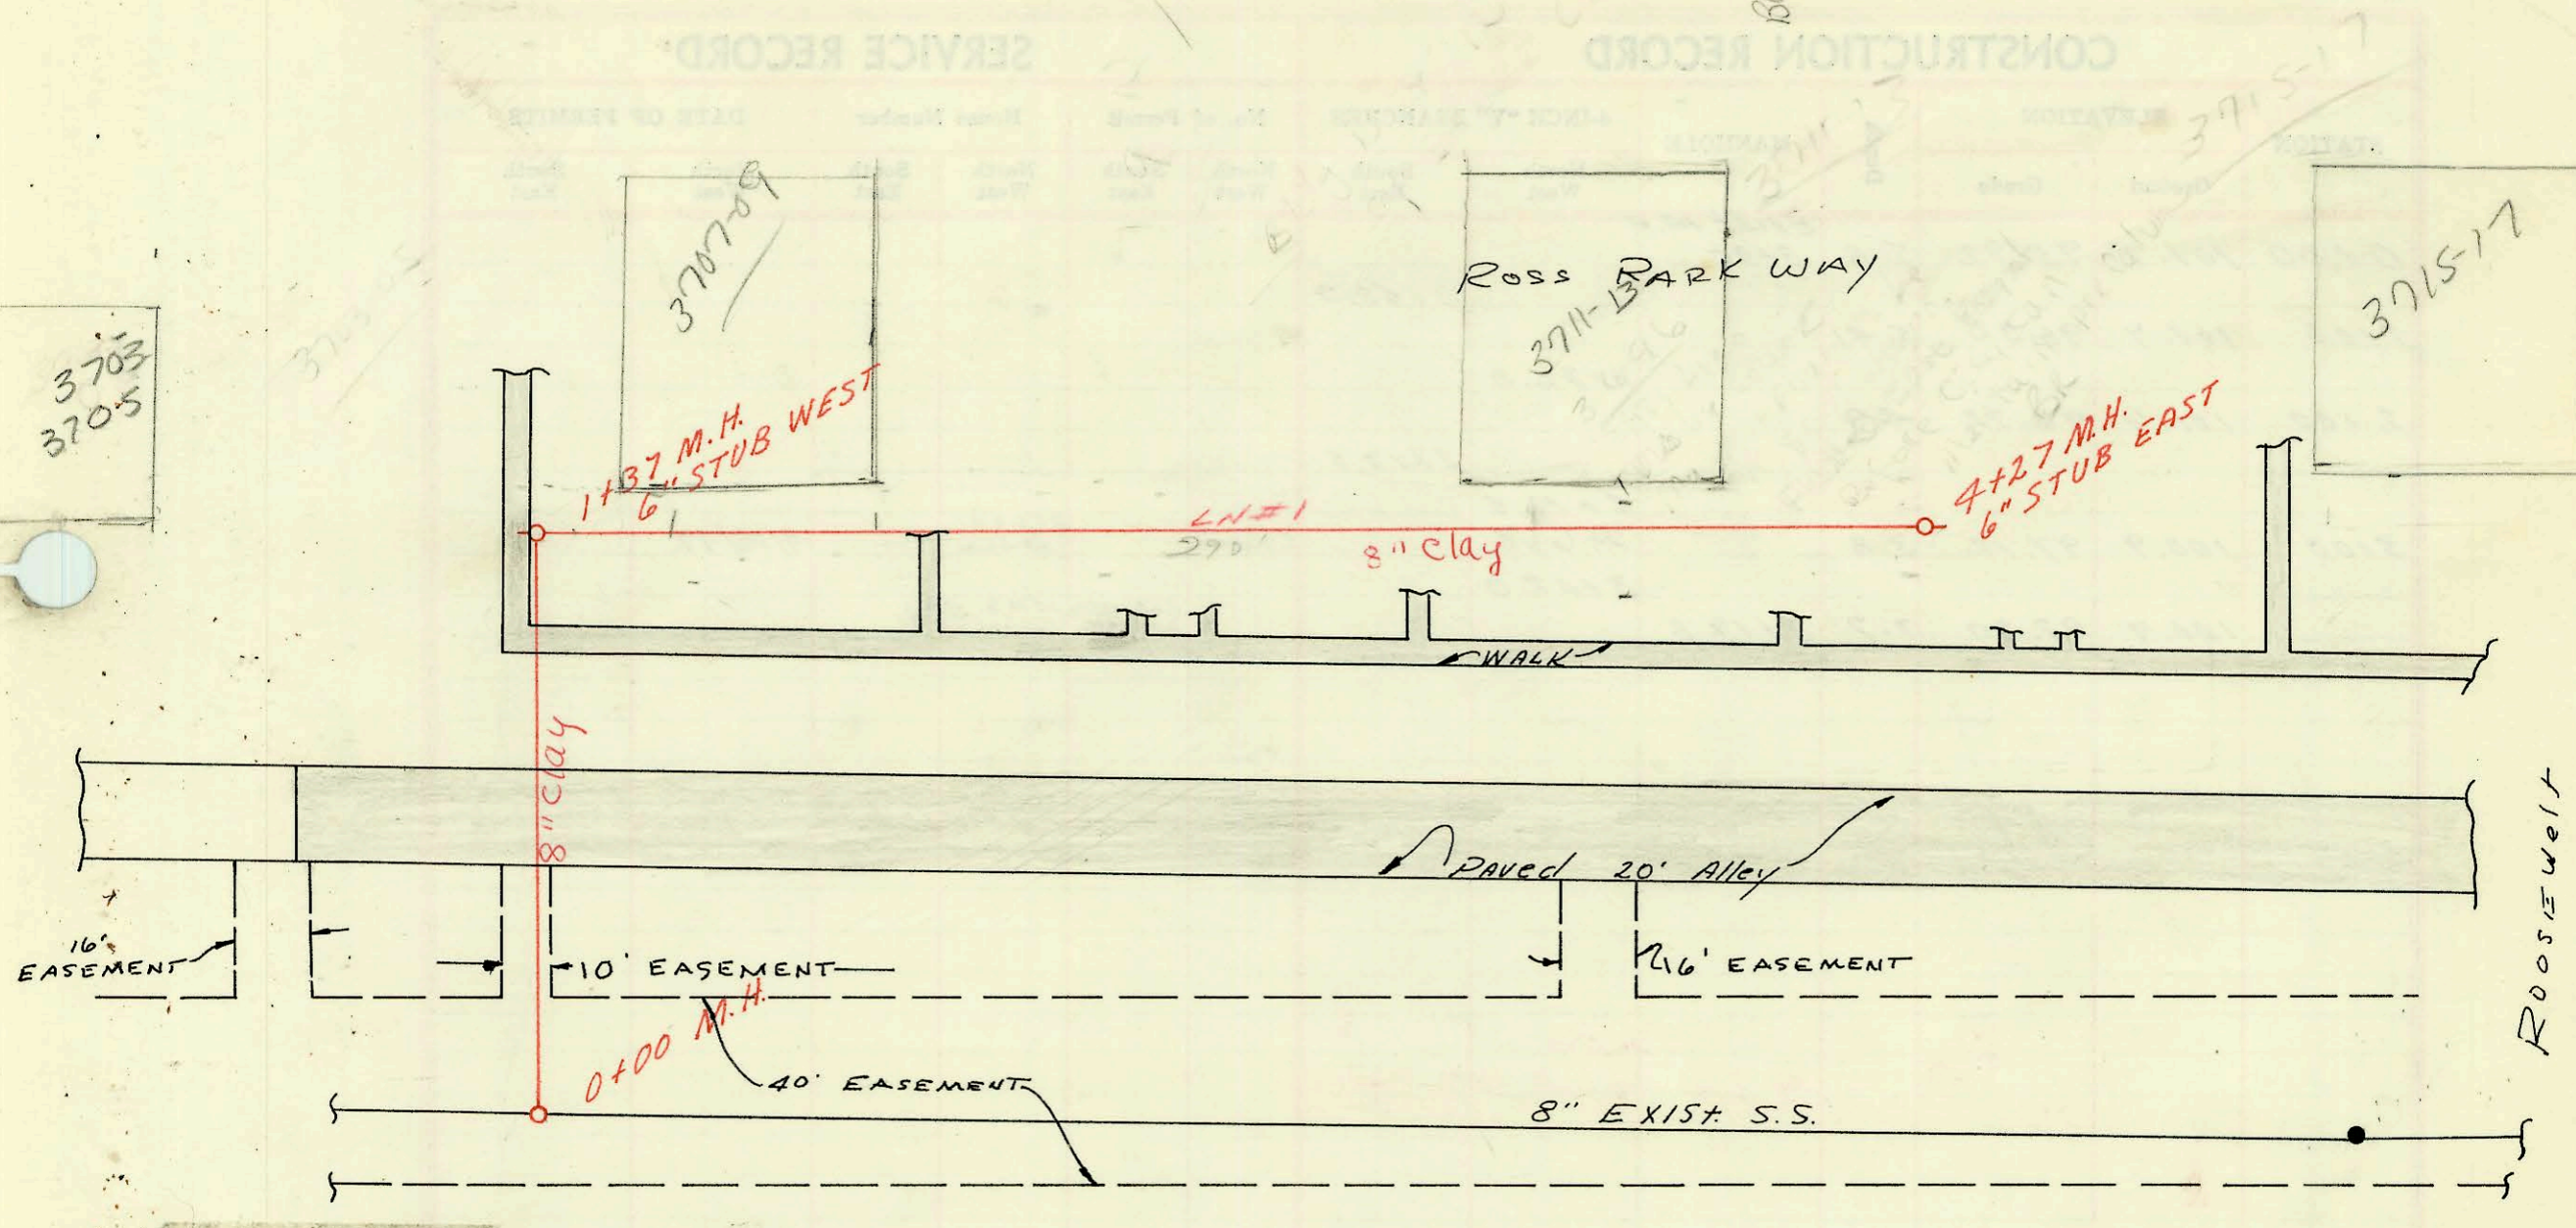

ROSS PARKWAY APARTMENTS
 SAN. SEWER
 MID STATES CONST. CO. INC.
 BOOKED-4-25-69 PRIVATE-PROJ.
 FROM PLAN & INSPECTORS CARD

M22

CONSTRUCTION RECORD

SERVICE RECORD

LN.# 1

LN.# 2

STATION	ELEVATION		Depth	MANHOLE	4-INCH "Y" BRANCHES		No. of Permit		House Number		DATE OF PERMITS	
	Ground	Grade			North West	South East	North West	South East	North West	South East	North West	South East
0+00	122.27	113.89	8.4	0+00								
1+00	121.66	115.47	6.2	1+37	6" stub West		013794		3703-05		4-29-69	
					1+66.5		013795		3707-09		4-29-69	
2+00												
3+00												
4+00												
	122.87	117.53	5.3	4+27	6" stub EAST		013796		3711-13		4-29-69	
0+00	129.17	120.75	8.7	EXIST. 0+00								
1+00	126.95	121.66	5.3	1+35	6" stub NE		013748		3804-09		4-24-69	
					lap 106 ft. W. of 0+00 → W		013749		3803-05		4-29-69	

NOTE: INFORMATION NOT SHOWN IS UNKNOWN