


EXIST. M.H. 0+00 Beg. 8\"/>

EXIST. 8\"/>

4s 0212

3+19.8 M.H.
(074)

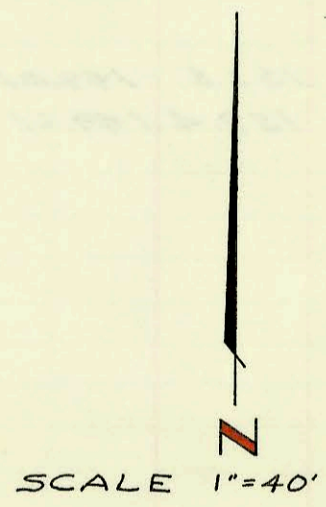

LAT. 17, SUB. 4 S.S. NO. 22
 W.B. CARTER CONST. CO. INC.
 BOOKED - 4/28/69 C29-15
 J.K. #8

ST MAP

11-23

CONSTRUCTION RECORD						SERVICE RECORD						
STATION	ELEVATION		Depth	MANHOLE	4-INCH "Y" BRANCHES		No. of Permit		House Number		DATE OF PERMITS	
	Ground	Grade			North West	South East	North West	South East	North West	South East	North West	South East
0+00	101.7	95.92	5.8	EXIST. M.H. 0+00								
1+00	101.7	96.32	5.4			0+48.0						
2+00	101.6	96.72	4.9		1+36.0							
						2+17.5						
3+00	100.9	97.12	3.8		2+19.5 2+69.8 3+02.0			C35025	2560 S. Seneca		9/25/72	
	100.9	97.20	3.7	3+19.8					Connect into M.H. Seneca 11-2-77			