


Plot Bk.
4-45

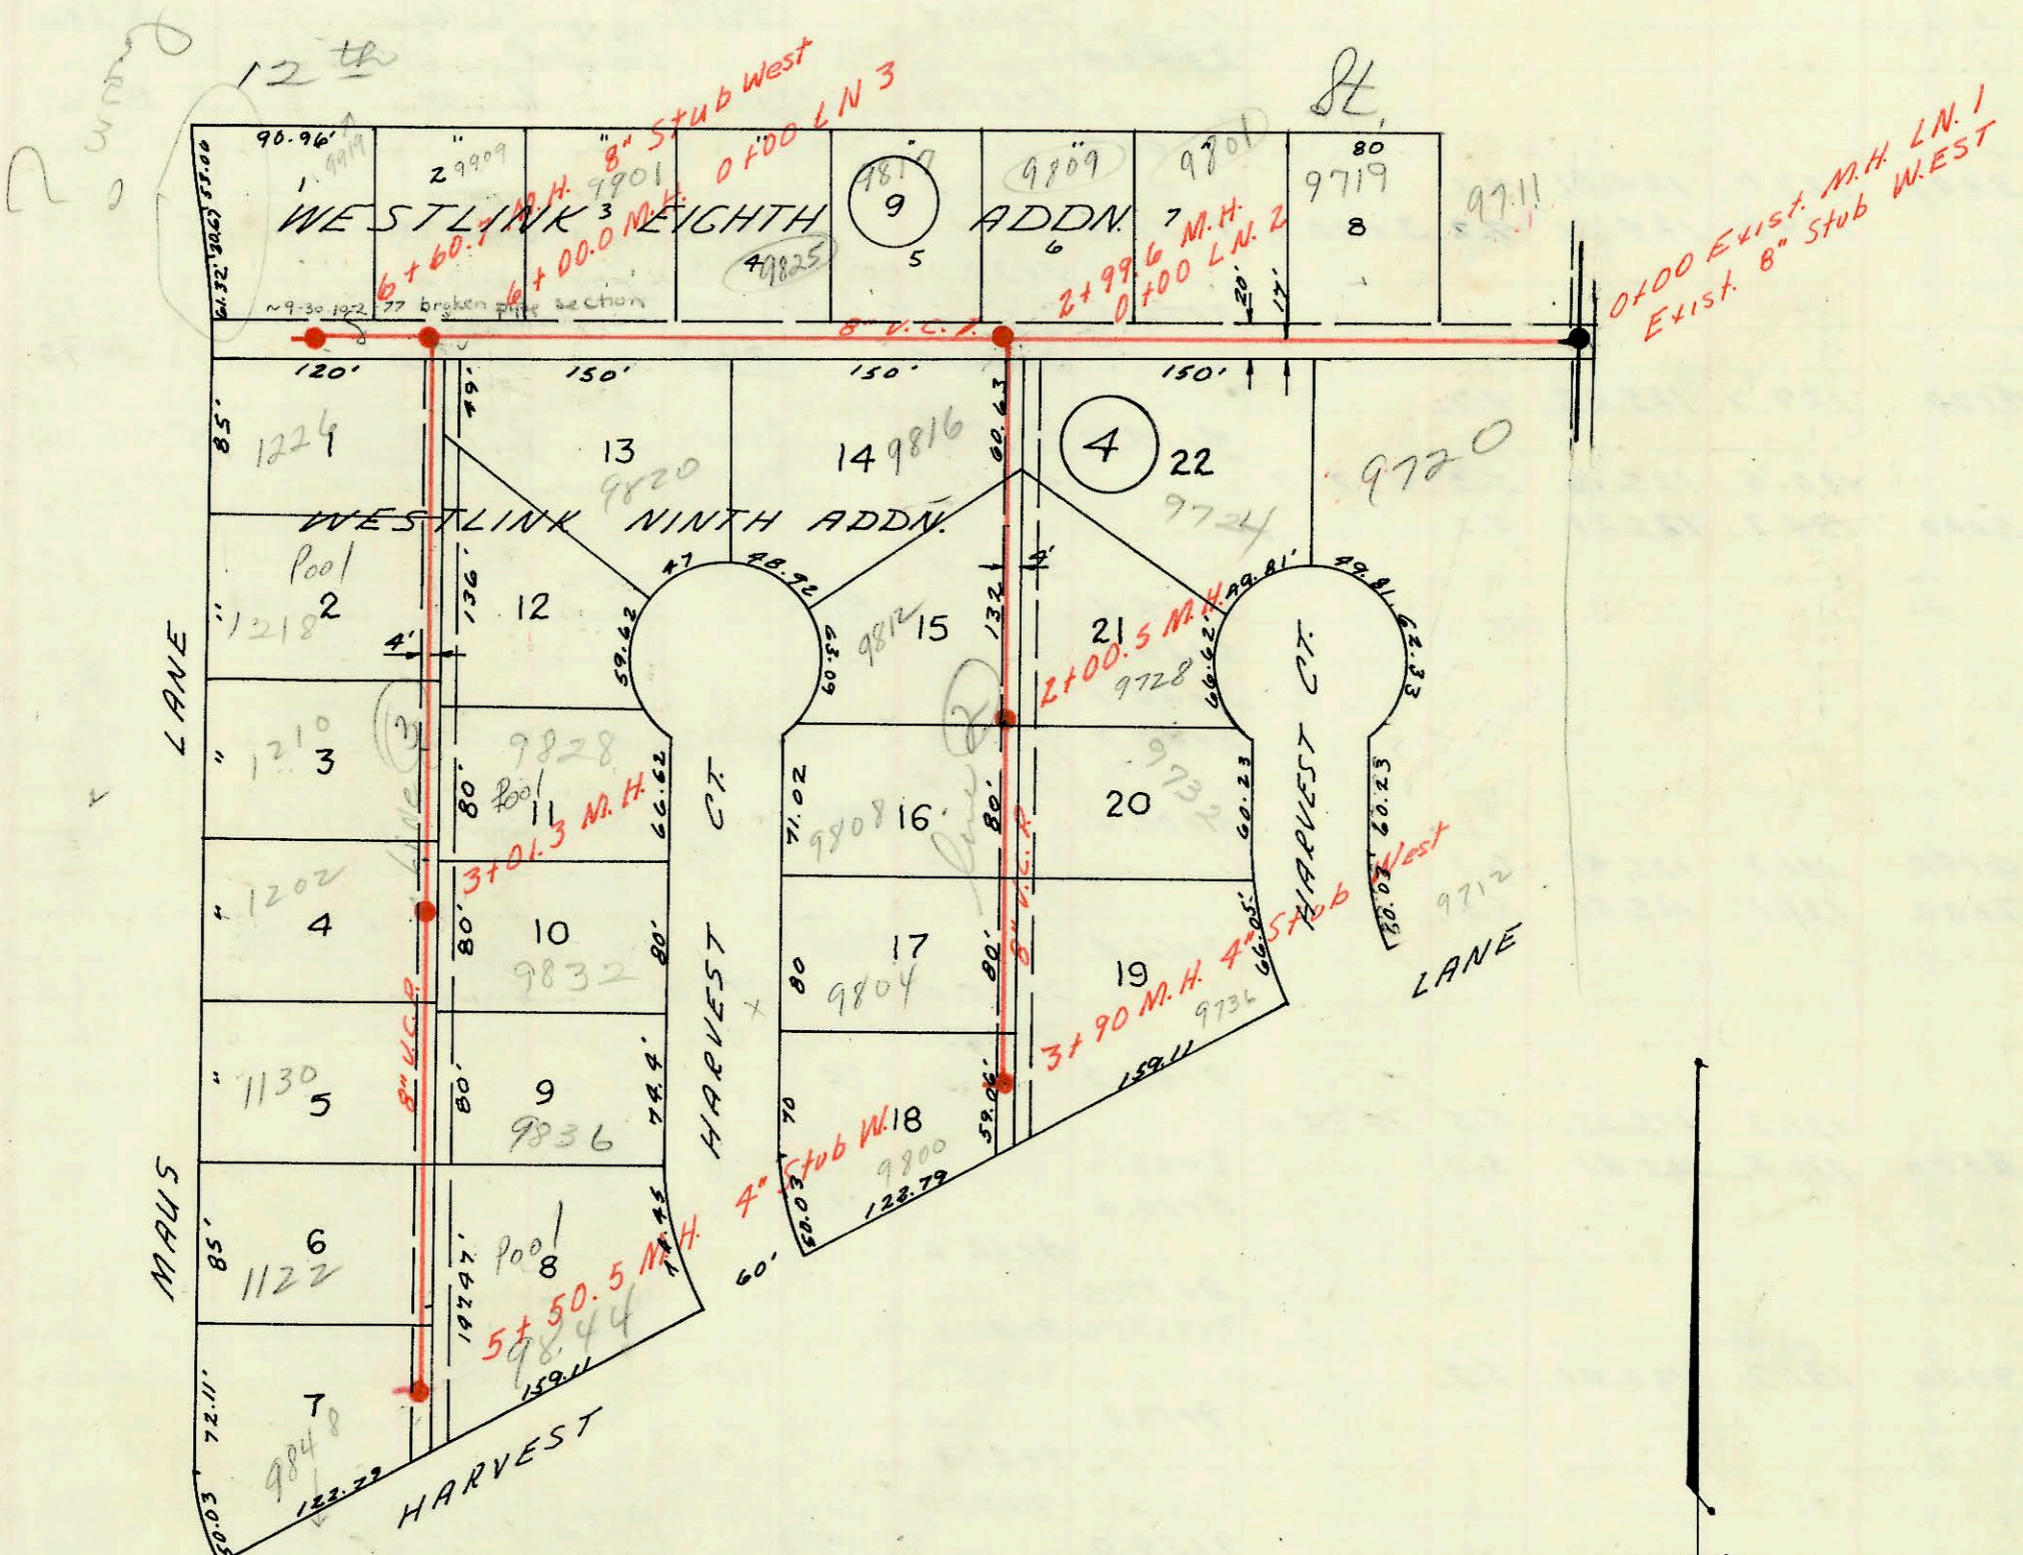

SCALE 1"=100'

Lat. 40 Westlink SEWER
 Utility Contractors Inc.
 Booked 5-6-69 Proj. C28-27
 JK #12

[Handwritten signature]

CONSTRUCTION RECORD

SERVICE RECORD

STATION	ELEVATION		Depth	MANHOLE	4-INCH "Y" BRANCHES		No. of Permit		House Number		DATE OF PERMITS	
	Ground	Grade			North West	South East	North West	South East	North West	South East	North West	South East
LN. #1 0+00	153.3	140.32	13.0	EXIST. 0+00								
					0+40.0		C17239		9771 W. 12th		12-9-69	
					top (0+21.5)		C17154		9720 Harvest Ct		4-20-72	
1+00	153.8	141.12	12.7		1+18.5		C34250		9719 W. 12th		8-14-72	
					1+61.0		C14065		9801 W. 12th St.		5-13-69	
2+00	153.3	141.92	11.4			2+28.0	C26911		9724 Harvest Ct.		8-31-71	
					2+51.0		C11328		9809 W. 12TH ST.			
IN OUT 3+00	154.4	142.71 142.81	11.7 11.6	2+99.6								
	154.4	142.81	11.6		3+37.5		C-27808		9817 W. 12TH		9-9-71	
					3+69.7		C24952		9816 Harvest Ct.		6-17-71	
4+00	155.9	144.13	11.8		4+12.6							
					4+94.8		C26909		9901 W. 12th		8-31-71	
5+00	152.3	145.53	11.8			5+01.7	C30177		9820 Harvest Ct.		1-26-70	
					5+89.3	5+97.3	C22322		9909 W. 12th		12-23-70	
					5+99.3							
6+00	159.3	147.01	12.3	6+00	6+42.6		C19546		9919 W. 12th		6-2-70	
	160.3	147.77	12.5	6+60.7	8" stub West							
LN. #2 0+00	154.5	142.81	11.7	EXIST. 0+00								
					0+95.0							
					0+97.0							
1+00	154.1	143.21	10.9		1+61.5		C23446		9812 Harvest Ct.		3-25-71	
2+00	153.8	143.61	10.2		2+16.8		C38481		9738 Harvest Ct.		4-24-73	
	153.8	143.61	10.2	2+00.5	2+39.0		C31753		9732 Harvest Ct.		4-20-72	
					2+41.0		C22331		9808 Harvest Ct.		12-23-70	
3+00	153.3	144.01	9.3		3+18.0							
					3+20.0	3+77.4	C22739	C25376	9804 Harvest Ct.	9736 Harvest Ct.	1-27-71	7-8-71
	152.5	144.37	8.1	3+90.0	4" stub West		C31266		9800 Harvest Ct.		3-30-72	
LN. #3 0+00	159.5	147.01	12.5	EXIST. 0+00								
					0+48.5		C-21872		1226 Maus Ln		11-20-70	
1+00	159.9	147.41	12.5		1+26.5		C23323		1218 Harvest Ct.		3-17-71	
2+00	160.8	147.81	13.0		2+15.5		C19012		1210 Maus Ln.		4-29-70	
					2+22.5							
					top 2+77.3		C31749		9808 Harvest Ct.		4-20-72	
3+00	160.0	148.21	11.8		3+32.3	Tap MH Tap	C18877	C37063	1202 Maus Ln	9832 Harvest Ct.	4-17-70	2-6-73
	160.0	148.21	11.8	3+01.3	3+70.0		C28962		9836 Harvest Ct.		11-12-71	
					3+72.0							
4+00	159.7	148.61	10.8		4+19.3		C18874		1136 Maus Ln		4-17-70	
					4+60.0							
					4+62.0		C14107		1122 Maus Ln		5-15-69	
5+00	152.8	149.01	8.8		TAP 5+05.7		C28024		9844 Harvest Lane		10-19-71	
	152.4	149.21	8.2	5+50.5	4" stub West		C19011		9848 Harvest Ln		4-29-70	

Tap C14066 - 9825 W 12th - 5-23-69 - Gerald Thompson (4+46.6)