


SERVICE RECORD CONSTRUCTION RECORD

STATION	ELEVATION	MARKER	ALSO IN SERVICE RECORD	DATE OF PERMIT
---------	-----------	--------	------------------------	----------------

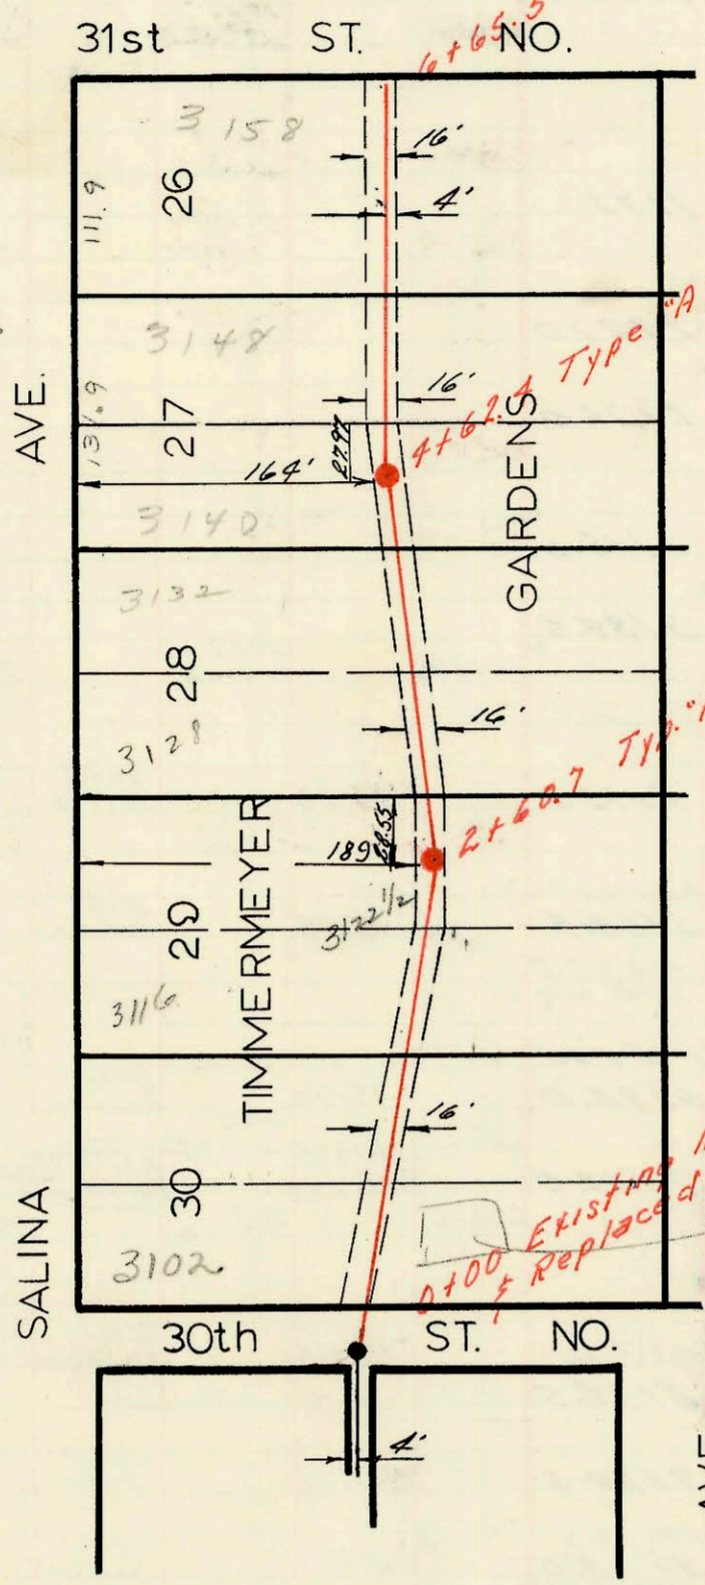

Existing M.H. Existing 8" stub W.E. Rem.
 3102 N Salina
 Sewer line for
 Garage should tap
 separate to City Main
 instead of crossing
 FSM to connect
 to house line
 BK
 5/5/03

SCALE 1"=100'

LAT. 26, SUB. 4, S.S. NO. 23
 W.B. CARTER CONST. CO. INC.
 BK. JULY 7, 1969 PROJ. C23-78
 H-89

Handwritten signature or initials

CONSTRUCTION RECORD						SERVICE RECORD						
STATION	ELEVATION		Depth	MANHOLE	4-INCH "Y" BRANCHES		No. of Permit		House Number		DATE OF PERMITS	
	Ground	Grade			North West	South East	North West	South East	North West	South East	North West	South East
0+00	128.6	122.26	6.3	EXISTING 0+00								
						0158.0						
					0+60.9		C15434		3102.71 Salina		8-15-69	
1+00	127.8	122.41	5.4			1126.6						
					1+28.6		C14811		3108 Salina		7-8-69	
2+00	128.0	122.55	5.5			2101.2						
					2+03.7		C16676		3110 Salina		6-7-78	
					2+38.5		C15850		3122 1/2 Salina		9-11-69	
	128.0	122.65	5.4	2+60.7		2+74.0		#602	3122 N Salina		6-23-80	
3+00	127.9	122.71	5.2			3137.2						
					3+39.2		C15792		3128 Salina		7-31-69	
					3+96.4		C19426		3132 Salina		5-22-70	
4+00	127.8	122.86	4.9			4+75.5						
	127.7	122.96	4.7	4+62.4		4+77.5		C15274	3140 Salina		8-5-69	
5+00	127.7	123.01	4.7			5+22.5						
					5+24.5		C15273		3148 Salina		8-5-69	
					5+84.0							
6+00	127.4	123.16	4.2			6+22.8						
					6+24.8		C15272		3158 Salina		8-5-69	
	127.6	123.26	4.3	6+65.5	Line Plugged							