


SERVICE RECORD

CONSTRUCTION RECORD

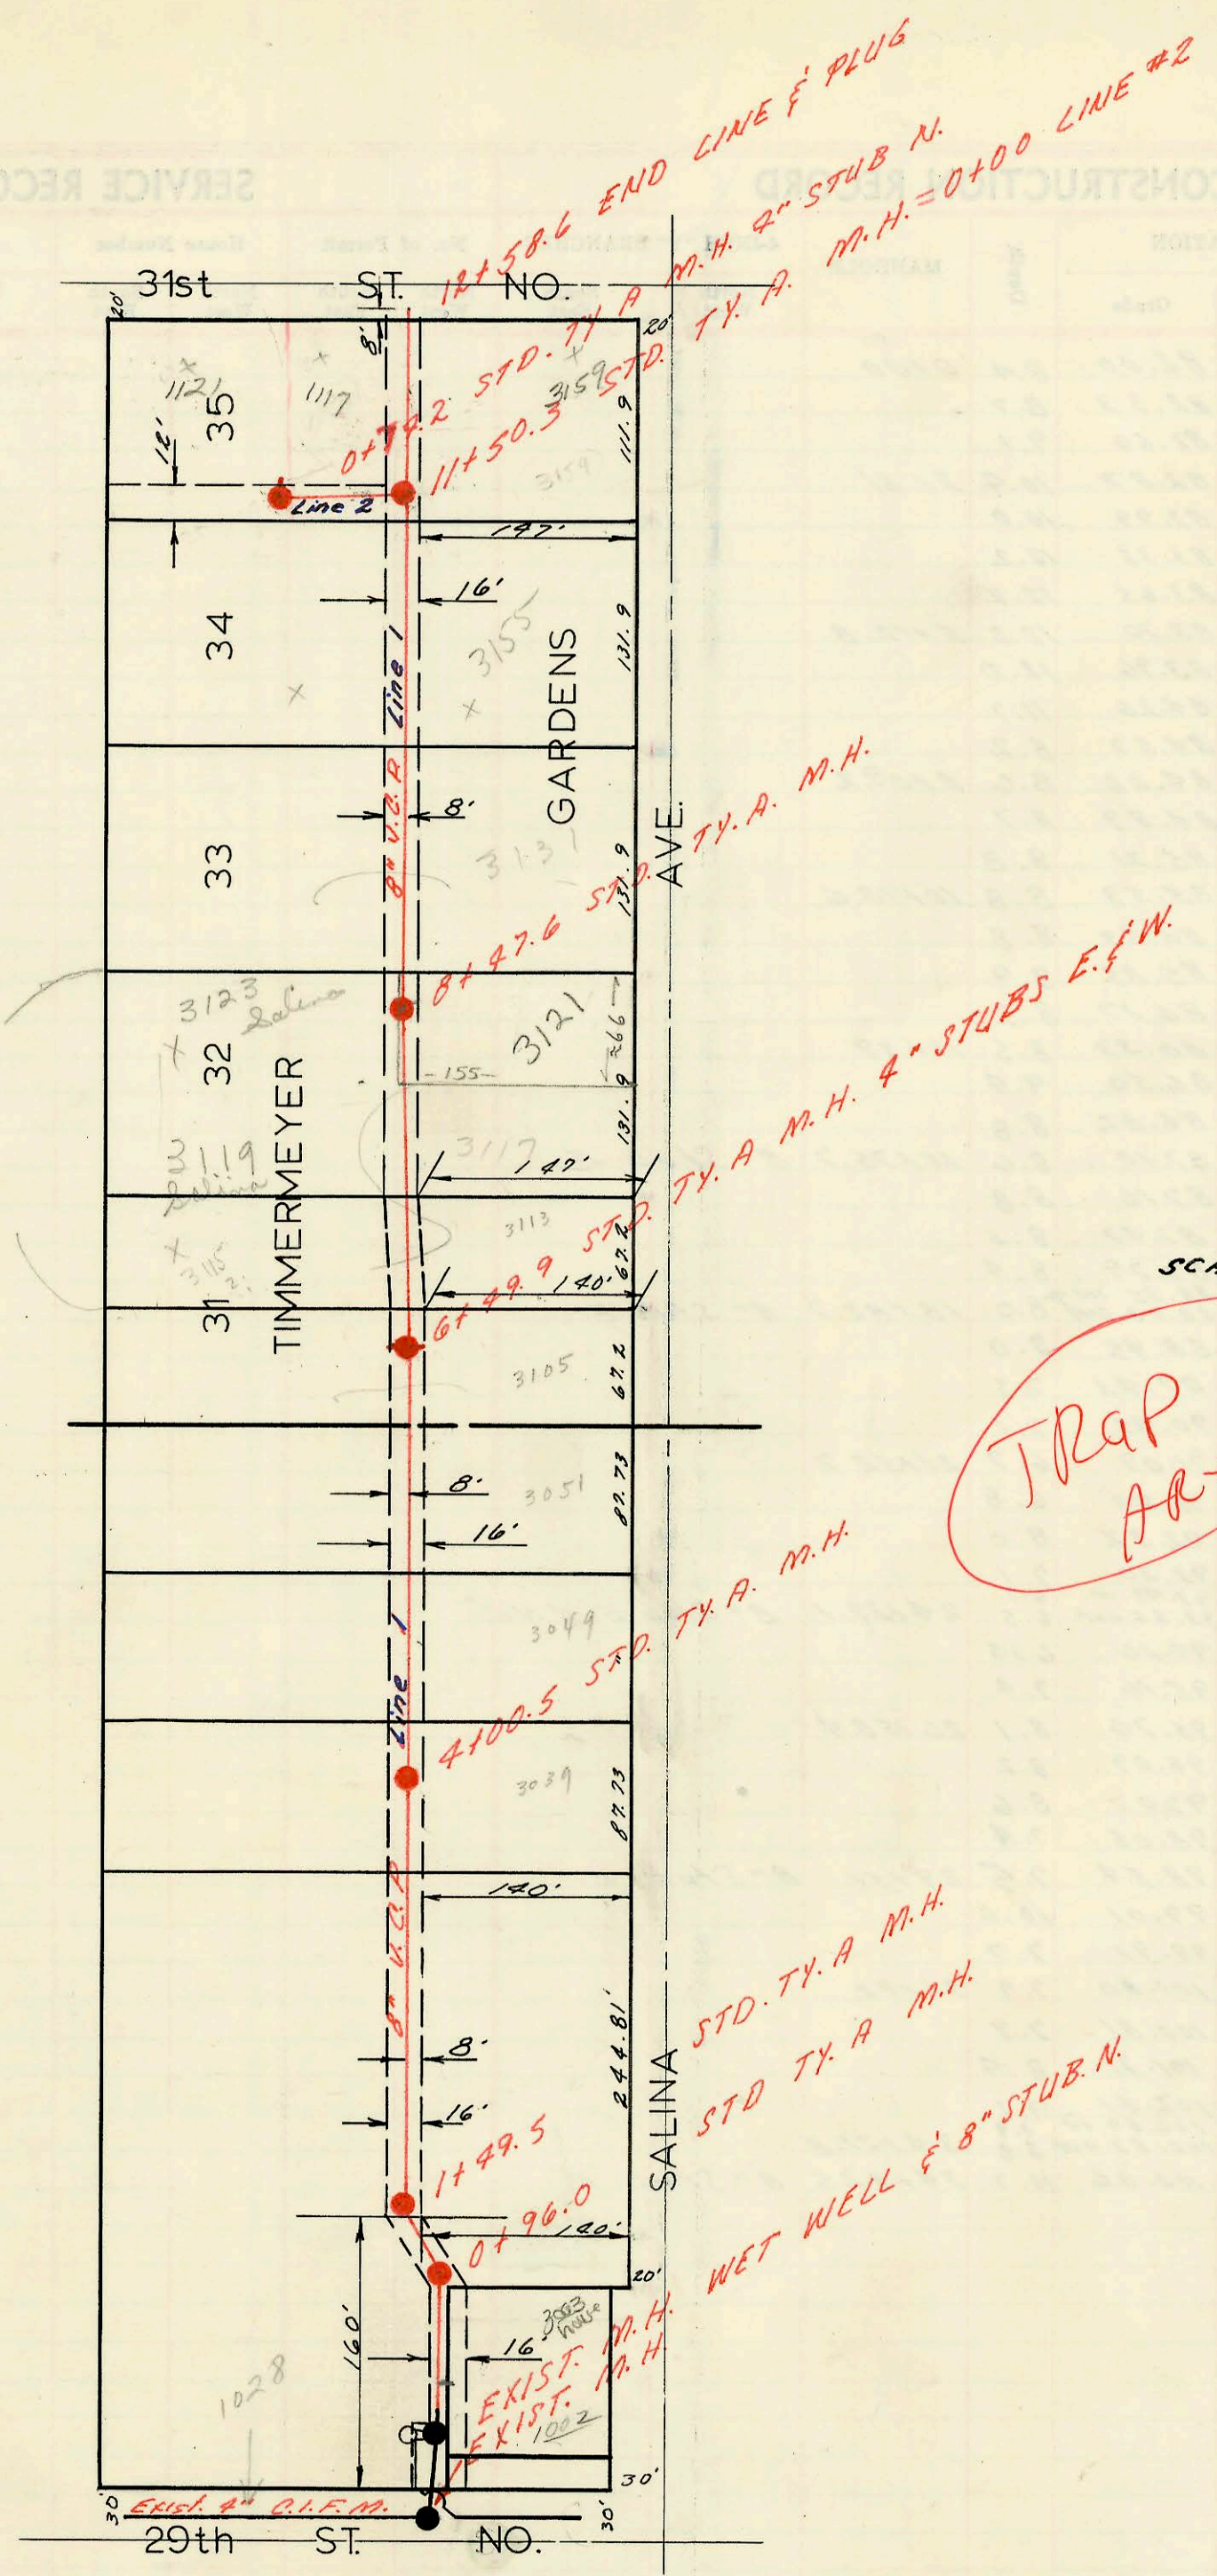

LAT. 30 SUB. 4, S.S. NO. 23
 W. B. CARTER CONST. CO. INC.
 BOOKED 7/18/69 PROJ. C23-82
 K-79-A

CONSTRUCTION RECORD						SERVICE RECORD						
STATION	ELEVATION		Depth	MANHOLE	4-INCH "Y" BRANCHES		No. of Permit		House Number		DATE OF PERMITS	
	Ground	Grade			North West	South East	North West	South East	North West	South East	North West	South East
Line 1 0+00	128.0	116.00	12.0	EXIST. 0+00								
	0+02	128.0	116.00	12.0	8" V.C.P. Tap 4' SW	0+16		2006-1086 99-317-7	3003 Salina 310		4/25/06 8-23-94	
					0+29		C39312	7-29-72			6-1-73	
					0+31							
					0+63							
					0+65		C42729	1028 W. 29th St. No.			12-13-73	
1+00	129.1	116.29	12.8	0+96.0								
	128.2	116.55	11.7	1+49.5								
					1+73							
					1+75							
2+00	128.1	116.80	11.3									
					2+27.0							
					2+29.0							
					2+76.0							
					2+78.0							
3+00	128.0	117.10	10.9									
					3+15.0							
					3+17.0							
					3+84.5							
					3+86.5		C14893	3029 SALINA			7/11/69	
4+00	117.40	128.4	11.0									
	117.40	128.4	11.0	4+00.5								
					4+73.5		C15020	3049 SALINA			7-21-69	
					4+75.5							
5+00	128.2	117.70	10.5									
					5+58.5		C15105	3051 Salina			7-25-69	
					5+95.0							
6+00	128.2	118.00	10.7									
	128.3	118.15	10.2	6+49.9	4" Stubs E & W							
					6+98.0							
7+00	128.3	118.30	10.0									
					7+00		C15242	3113 Salina			8-4-69	
					7+62.0		C20235	3115 Salina			7-27-70	
					7+64.0		C42655	3117 Salina			8-4-69	
							C15243	3119 Salina			8-4-69	
							C13665	3119 Salina			4-6-70	
8+00	128.2	118.60	9.6									
	128.3	118.75	9.6	8+17.6	MH Tap		C15244	3121 Salina			8-4-69	
					8+74.5							
9+00	128.2	118.90	9.3									
					9+20.6		C22718	3131 Salina			9-28-71	
					9+22.6							
					9+78.0		C2271	3131 Salina			9-28-71	
10+00	128.2	119.20	9.0									
					10+31.6							
					10+73.3		C15223	3155 Salina			8-1-69	
11+00	128.9	119.50	9.4									
	129.0	119.66	9.3	11+50.3	11+99.5		C37195	1117 W. 31st St. No.			2-14-73	
12+00	129.2	119.80	9.4									
					12+38.0		C15289	3159 Salina			8-6-69	
					12+58.6	Line Plugged						
Line 2 0+00	129.2	119.76	9.4	EXIST. 0+00								
	128.3	120.56	7.7	0+74.2	4" Stub N.		C15275	1121 W. 31st St.			8-5-69	

slp
 3003 N Salina - Computer Records show a slp permit & re connect permit by Buck's Backhoe - NO TRAP on slp permit. Reconnect permit shows trap at 16'5".
 4" MH - 4" sch 40 pipe
 slp @ 15' south of MH + 4' from man - A. Henning - 5/2/04 2004-01086