
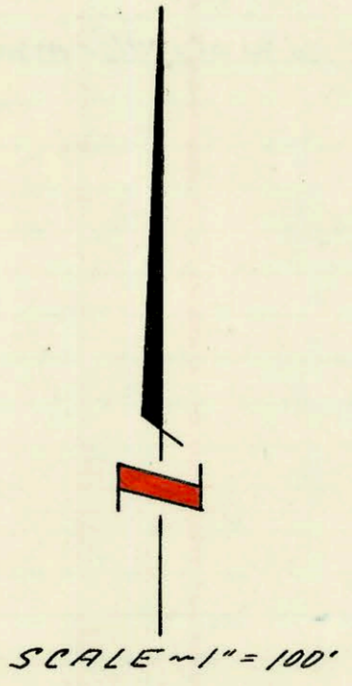


SERVICE RECORD CONSTRUCTION RECORD

EASTLINK VILLAGE FOURTH ADDITION

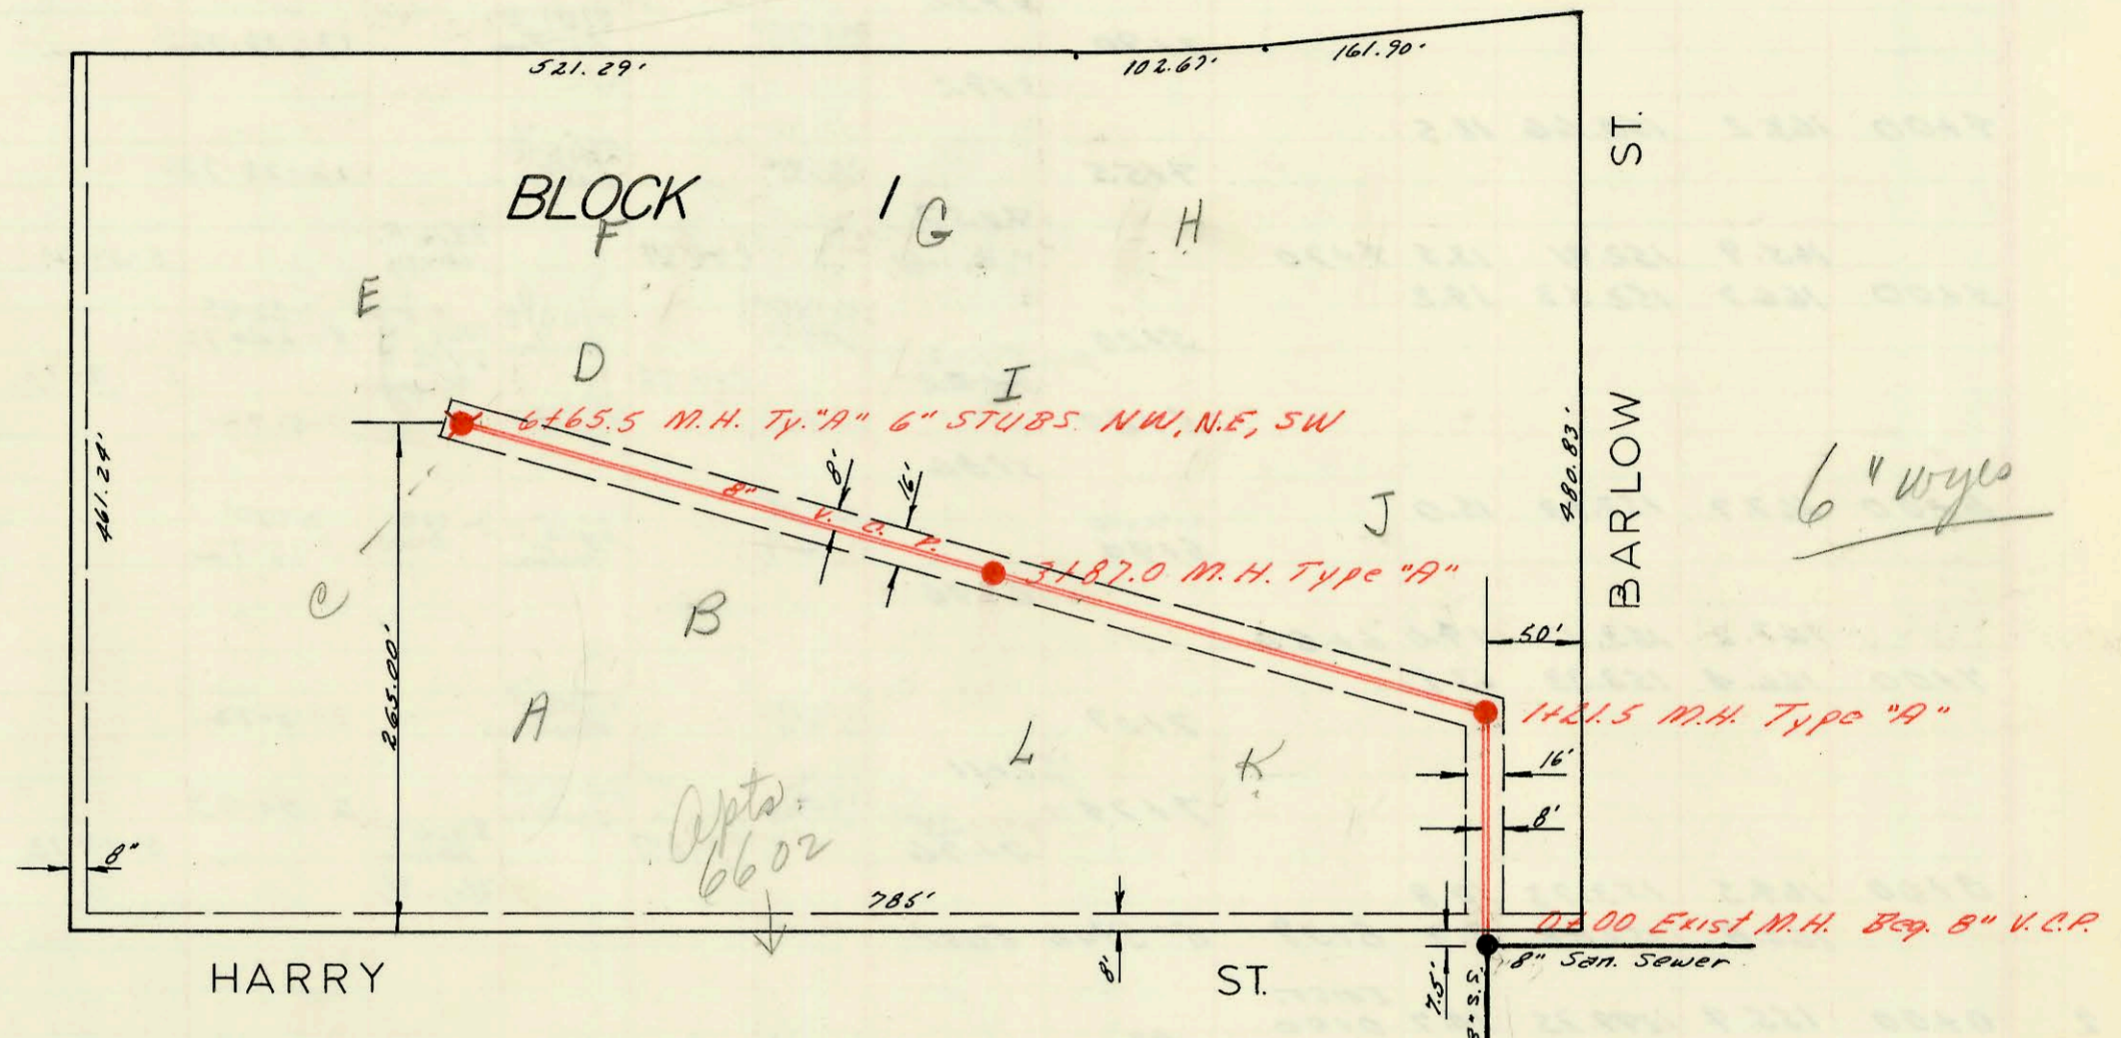

LAT. 41, WAR INDUSTRIES SEWER
 W.B. CARTER CONST. CO. INC.
 BOOKED 8-8-69 PROJ. C27-46

264-Y

On map

CONSTRUCTION RECORD						SERVICE RECORD						
STATION	ELEVATION		Depth	MANHOLE	4-INCH "Y" BRANCHES		No. of Permit		House Number		DATE OF PERMITS	
	Ground	Grade			North West	South East	North West	South East	North West	South East	North West	South East
0+00	139.3	131.00	8.3	EXISTING 0+00	All y's ARE 6"							
1+00	141.6	131.80	9.8									
	141.5	131.96	9.5	1+21.5								
2+00	142.3	132.20	9.6			1+94.5	#C15429		6602 (R) E. Harry		8-15-69	
				2+36.0			#C15428		6602 (S) E. Harry		8-15-69	
3+00	143.3	133.50	9.8	2+48.0 wye		3+26.0	C15426		6602 E (H) Harry		8-15-69	
						3+29.0	#C15430		6602 (D) E. Harry		8-15-69	
4+00	145.6	134.18	11.4	3+82.0								
	145.9	134.30	11.6									
				4+40.0			#C15427		6602 (I) E. Harry		8-15-69	
				4+51.0			#C15425		6602 (C) E. Harry		8-15-69	
5+00	147.1	135.10	12.0			4+89.0	#C15419		6602 (E) E. Harry		8-15-69	
				5+04.0			#C15424		6602 (F) E. Harry		8-15-69	
				5+68.0			C15420		6602 (B) E. Harry		8-15-69	
6+00	147.8	135.90	11.9				#C15423		6602 (E) E. Harry		8-15-69	
	147.5	136.42	11.1	6+65.5	6" Stubs	NW, NE, SW E D C	#C15422	#C15421	6602 (D) E. Harry	6602 (A) E. Harry	8-15-69	8-15-69

2000-01772-6602 E Harry (P) Wichita Eye