



SERVICE RECORD				CONSTRUCTION RECORD			
DATE OF PERMIT	ISSUE NUMBER	NO. OF PAGES	4-INCH T. DIMENSIONS	MANHOLE	ELEVATION	STATION	

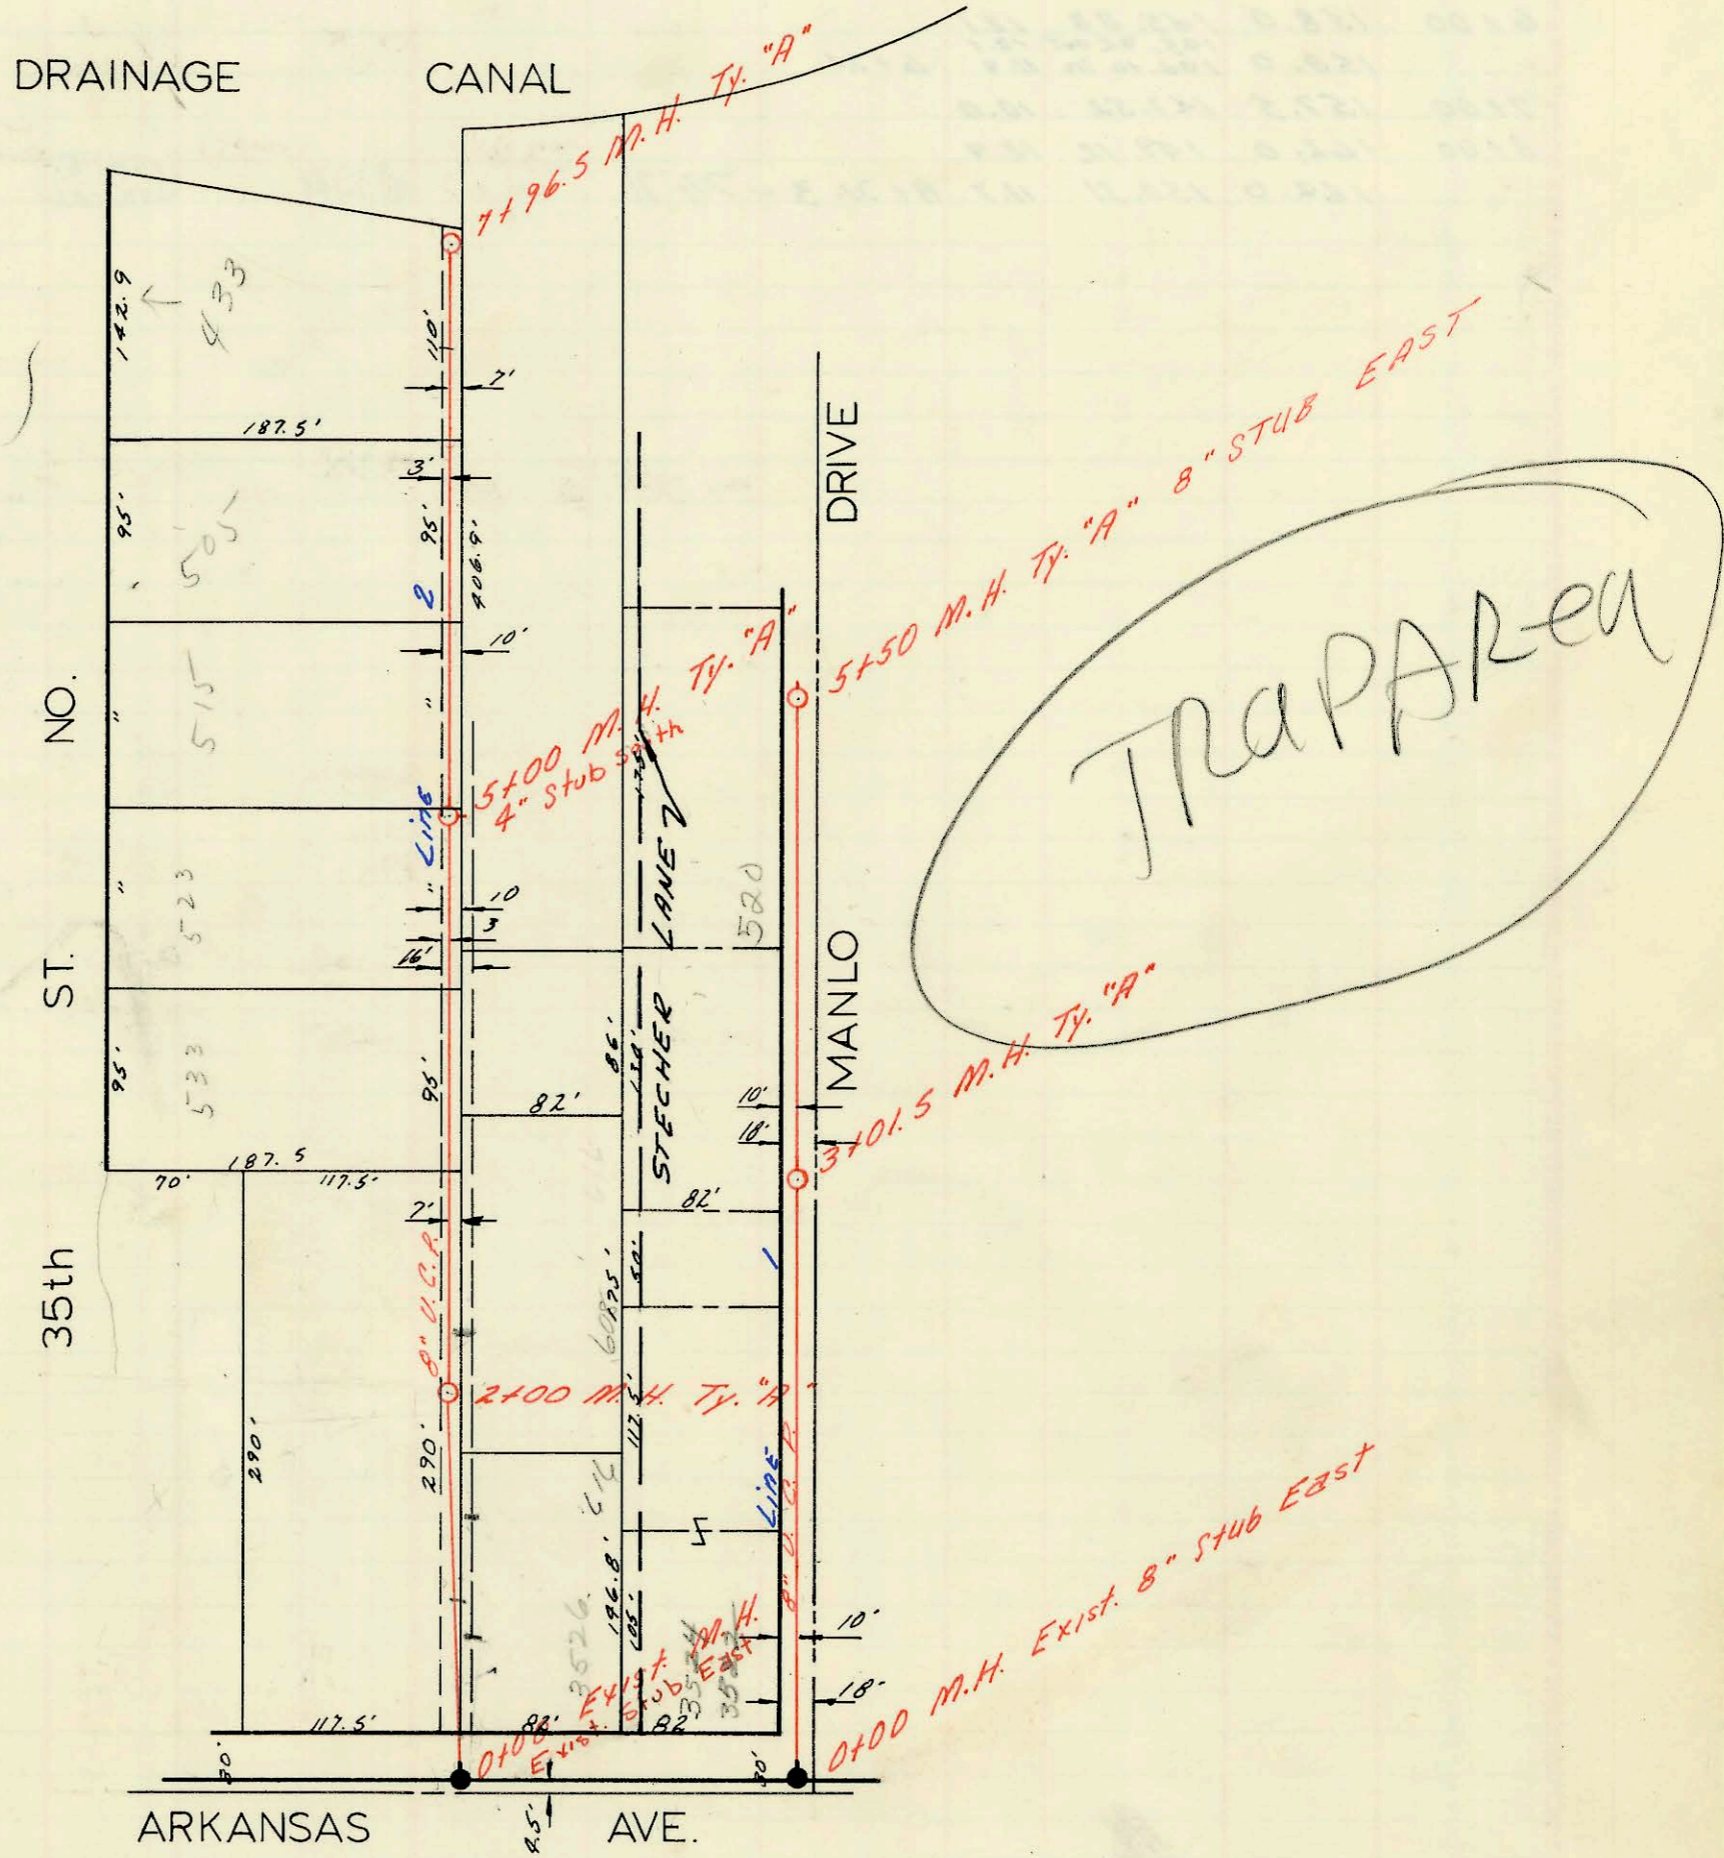

7796.5
2247 S.
[Handwritten notes]

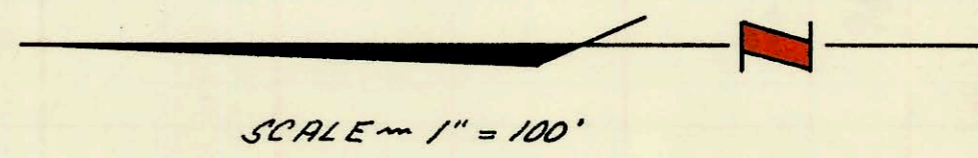

LAT. 6, SUB. 4, S. S. NO. 23
 W. B. CARTER CONST. CO.
 8-11-69
 PROJ. C23-58
 I.H.7

ON MAP

CONSTRUCTION RECORD						SERVICE RECORD						
STATION	ELEVATION		Depth	MANHOLE	4-INCH "Y" BRANCHES		No. of Permit		House Number		DATE OF PERMITS	
	Ground	Grade			North West	South East	North West	South East	North West	South East	North West	South East
Line 1	0+00	129.4	121.12	8.3	EXISTING 0+00							
	0+02	beg. Project			0+60		C49448		3522-24 N. Arkansas		5-12-75	
	1+00	129.2	121.42	7.8								
	2+00	129.6	121.72	7.9	1+64 2+64		C17921		609-11 Stecher Lane		2-9-70	
	3+00	131.7	122.02	9.7								
		131.7	122.02	9.7	3+01.5							
					3+92 3+78.8		99-46101 C14582		435 R Stecher Ln		3-17-69 8-19-69	
	4+00	133.9	122.32	11.6								
					4+51	4+52.7		C59393		520 manila		8-25-76
	5+00	133.1	122.62	10.5								
					5+18							
		132.3	122.77	9.5	5+50	8" Stub East						
Line 2	0+00	129.5	121.52	8.0	EXISTING 0+00							
	0+02	beg. Project										
	1+00	130.7	121.82	8.9	0+89.9	0+76	C62780	C17944	3530 N. Arkansas	3526 Arkansas	7-31-55 8-27-77	2-10-70
					1+33							
						1+35		C49449		614 Stecher Ln		5-12-75
	2+00	129.6	122.12	7.5	2+00							
					2+91.5							
						2+93.5		C15290		608 STECHEE		8-7-69
	3+00	130.1	122.92	7.7								
					3+55	3+57	C19169		533 W. 3526 N.		5-7-70	
	4+00	130.0	122.72	7.3								
					4+49		C17938		523 W. 3526 N.		2-10-70	
	5+00	130.7	123.02	7.7	5+00	4" Stub South		C15292		512 STECHEE		8-7-69
					5+36.6		C29787		515 W. 3526 N.		1-3-72	
	6+00	130.4	123.32	6.7								
					6+39		C44230		505 W. 3526 N.		4-1-74	
						6+41						
	7+00	130.5	123.62	6.9								
					7+29.4		C16318		433 W. 3526 N.		10-15-69	
		130.2	123.92	4.1	7+96.5							