


2nd ST. 12" V.C.R. 12" V.C.R.

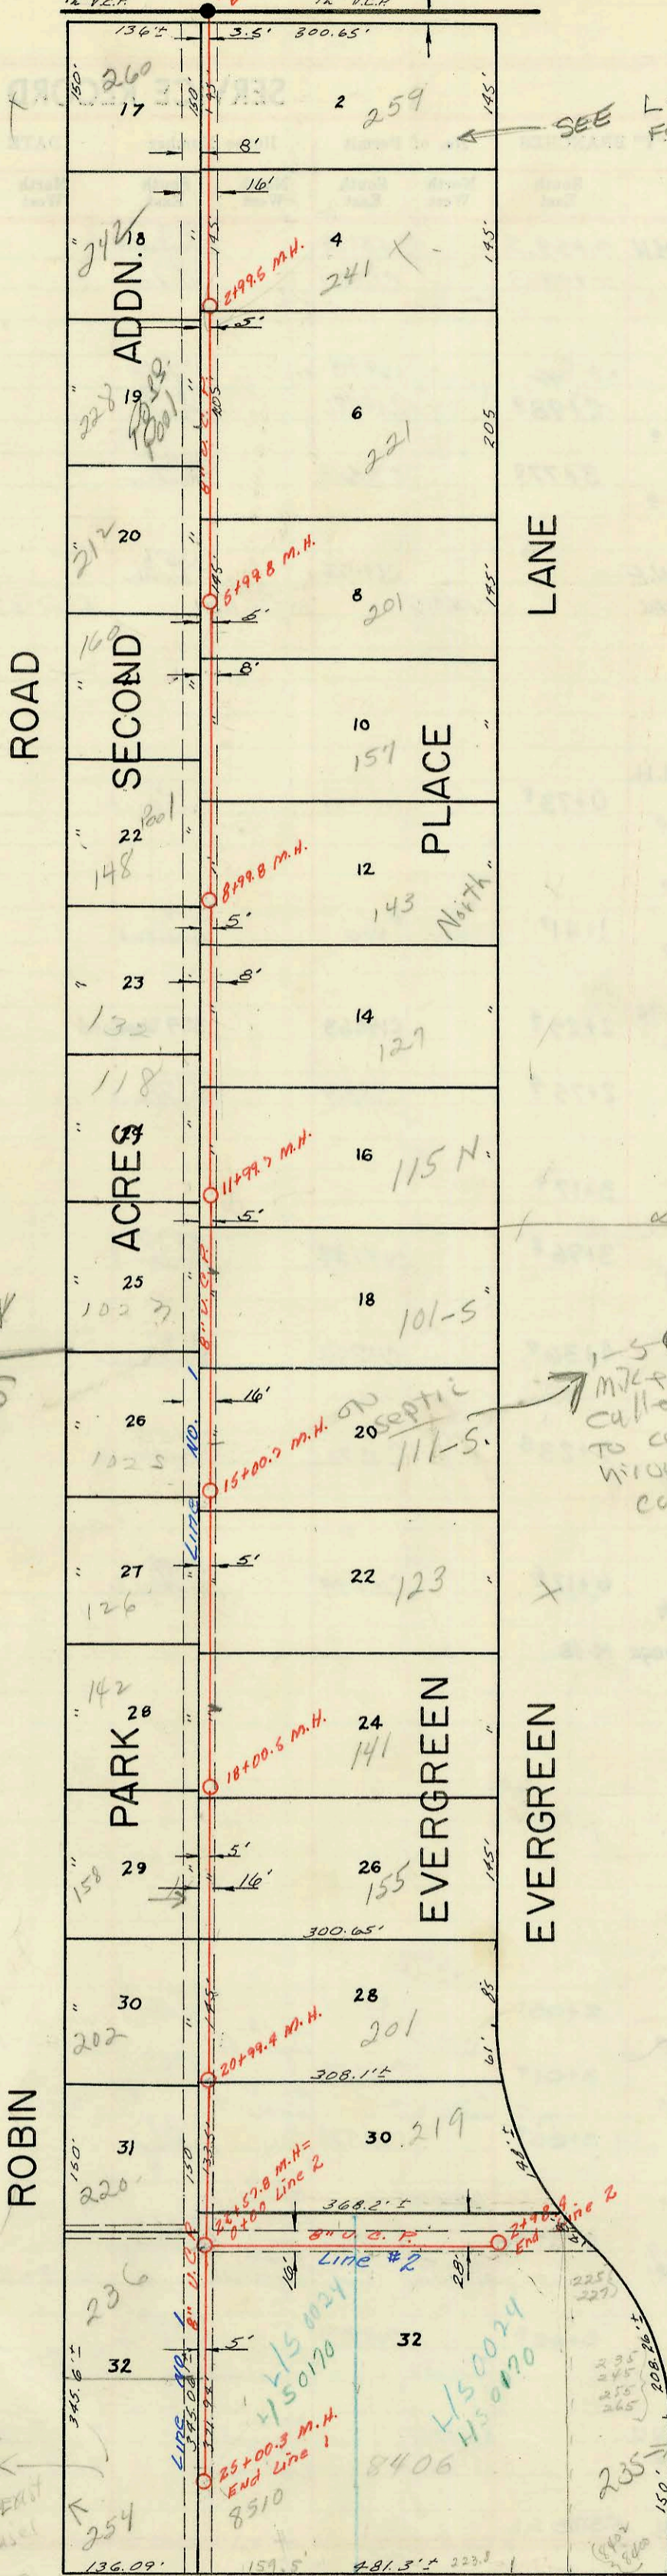

SEE L-66 FOR CONNECTION ON THIS LOT

LANE

PLACE

EVERGREEN

ROAD

ACRES

PARK

ROBIN

MAPLE ST.

EVERGREEN

1-5-64
 MR. & MRS. GERR, owner,
 called 1-5-64 - wanted
 to connect to sewer via
 window. Actual removal
 contract
 Need
 ① P/bq ok for panel
 ② equity



SCALE - 1" = 150'

Room add -
 Homeowner cut
 service line
 as S-side drain
 house. D.L. advised
 p/bq needs to
 re-route line to
 rear before
 line can be
 connected to
 main sewer

L.A.T. 5, SUB. 1, WESTLINK SEWER
 MID-STATES CONST. CO. INC.

BOOKED - 8-15-69

PROJ. C26-61

K-87

M-95

| CONSTRUCTION RECORD | | | | | SERVICE RECORD | | | | | | | |
|---------------------|-----------|--------|-------|---------------|---------------------|------------|---------------|------------|--------------|------------|-----------------|------------|
| STATION | ELEVATION | | Depth | MANHOLE | 4-INCH "Y" BRANCHES | | No. of Permit | | House Number | | DATE OF PERMITS | |
| | Ground | Grade | | | North West | South East | North West | South East | North West | South East | North West | South East |
| 0+00 | 139.8 | 134.44 | 5.4 | EXIST 0+00 | | | | | | | | |
| | | | | | | 0+70 | | | | | | |
| 1+00 | 140.0 | 132.59 | 7.4 | | | | | | | | | |
| 2+00 | 139.9 | 132.74 | 7.2 | | | | | | | | | |
| | | | | | | 2+08.7 | | | | | | |
| | 140.0 | 132.89 | 7.1 | 2+99.5 | | | | | | | | 5-8-80 |
| 3+00 | 140.0 | 132.89 | 7.1 | | | | | | | | | 5-8-80 |
| 4+00 | 139.2 | 133.04 | 6.2 | | | | | | | | | |
| | | | | | | 4+19.5 | | | | | | |
| 5+00 | 140.1 | 133.19 | 6.9 | | | | | | | | | |
| | | | | | | 4+21.5 | | | | | | |
| | 140.2 | 133.34 | 6.9 | 5+99.8 | | | | | | | | |
| 6+00 | 140.2 | 133.34 | 6.9 | | | | | | | | | |
| 7+00 | 140.8 | 133.49 | 7.3 | | | | | | | | | |
| | | | | | | 7+105.5 | | | | | | |
| 8+00 | 140.8 | 133.64 | 7.2 | | | | | | | | | |
| | | | | | | 8+17.5 | | | | | | |
| | 140.4 | 133.79 | 6.6 | 8+99.8 | | | | | | | | |
| 9+00 | 140.4 | 133.79 | 6.6 | | | | | | | | | |
| | | | | | | 8+155.0 | | | | | | |
| | 140.4 | 133.79 | 6.6 | 9+58.5 | | | | | | | | |
| 10+00 | 140.3 | 133.94 | 6.3 | | | | | | | | | |
| | | | | | | 9+169.5 | | | | | | |
| 11+00 | 140.2 | 134.09 | 6.1 | | | | | | | | | |
| | | | | | | 10+11.7 | | | | | | |
| | 140.4 | 134.24 | 6.2 | 11+99.7 | | | | | | | | |
| 12+00 | 140.4 | 134.24 | 6.2 | | | | | | | | | |
| | | | | | | 11+108.8 | | | | | | |
| | 140.4 | 134.24 | 6.2 | 11+99.7 | | | | | | | | |
| 13+00 | 140.7 | 134.44 | 6.3 | | | | | | | | | |
| 14+00 | 141.0 | 134.64 | 6.4 | | | | | | | | | |
| | | | | | | 12+164.5 | | | | | | |
| | 140.7 | 134.44 | 6.3 | | | | | | | | | |
| 15+00 | 141.2 | 134.84 | 6.4 | | | | | | | | | |
| | 141.2 | 134.84 | 6.4 | 15+00.7 | | | | | | | | |
| | | | | | | 12+181.8 | | | | | | |
| | 141.9 | 135.04 | 6.9 | | | | | | | | | |
| 16+00 | 141.9 | 135.04 | 6.9 | | | | | | | | | |
| 17+00 | 142.2 | 135.24 | 7.0 | | | | | | | | | |
| | | | | | | 14+27.5 | | | | | | |
| | 142.2 | 135.44 | 6.8 | 18+00.5 | | | | | | | | |
| 18+00 | 142.2 | 135.44 | 6.8 | | | | | | | | | |
| | 142.2 | 135.44 | 6.8 | | | 17+17.2 | | | | | | |
| | 142.6 | 135.64 | 6.8 | | | 18+97.0 | | | | | | |
| 19+00 | 142.6 | 135.64 | 6.8 | | | | | | | | | |
| | 142.2 | 135.84 | 6.4 | | | 19+15.6 | | | | | | |
| 20+00 | 142.2 | 135.84 | 6.4 | | | | | | | | | |
| | 142.1 | 136.01 | 6.1 | 20+99.4 | | | | | | | | |
| 21+00 | 142.1 | 136.04 | 6.1 | | | | | | | | | |
| | | | | | | 20+110.0 | | | | | | |
| | 141.7 | 136.24 | 5.5 | 21+99.4 | | | | | | | | |
| 22+00 | 141.7 | 136.24 | 5.5 | | | | | | | | | |
| | 140.8 | 136.45 | 4.4 | 22+57.8 | | | | | | | | |
| 23+00 | 140.8 | 136.48 | 4.3 | | | | | | | | | |
| | | | | | | 21+166.2 | | | | | | |
| | 141.0 | 136.78 | 4.2 | | | | | | | | | |
| 24+00 | 141.0 | 136.78 | 4.2 | | | | | | | | | |
| | 141.0 | 137.08 | 3.9 | | | 24+94.4 | | | | | | |
| 25+00 | 141.0 | 137.08 | 3.9 | | | | | | | | | |
| | 141.3 | 136.47 | 4.8 | 25+00.3 | | | | | | | | |
| 0+00 | 141.3 | 136.47 | 4.8 | EXIST 0+00 | | | | | | | | |
| 1+00 | 141.5 | 136.75 | 4.8 | | | | | | | | | |
| | | | | | | 1+67.0 | | | | | | |
| 2+00 | 144.0 | 137.05 | 7.0 | | | | | | | | | |
| | 143.4 | 137.35 | 6.1 | 2+98.4 | | | | | | | | |

Line 2

2000-01841-8/17/00-Morris Ditch-4" SCH 40, 1 TWN CO, 1 HAZ, 1 H45, 8406 W Maple
 2-4" comb- Addition to house - Added to exist house line w/combo
 2001-01861-7-30-01 8406 W Maple-3" D. plog: 4" SCH 40, Tied into existing bldg SWR - SERVES NEW ADDITION

- #C22570-8400-8402 W. Maple - 1-15-71 (m. H. tap 2+98.4)
- #C22571-225-227 So. Evergreen 1-15-71 (m. H. tap 2+98.4)
- #C22572-235-245-255-265 So. Evergreen 1-15-71 (m. H. tap 2+98.4)

