



CONSTRUCTION RECORD

33 40 ST. NO. 31 41 ST. NO.

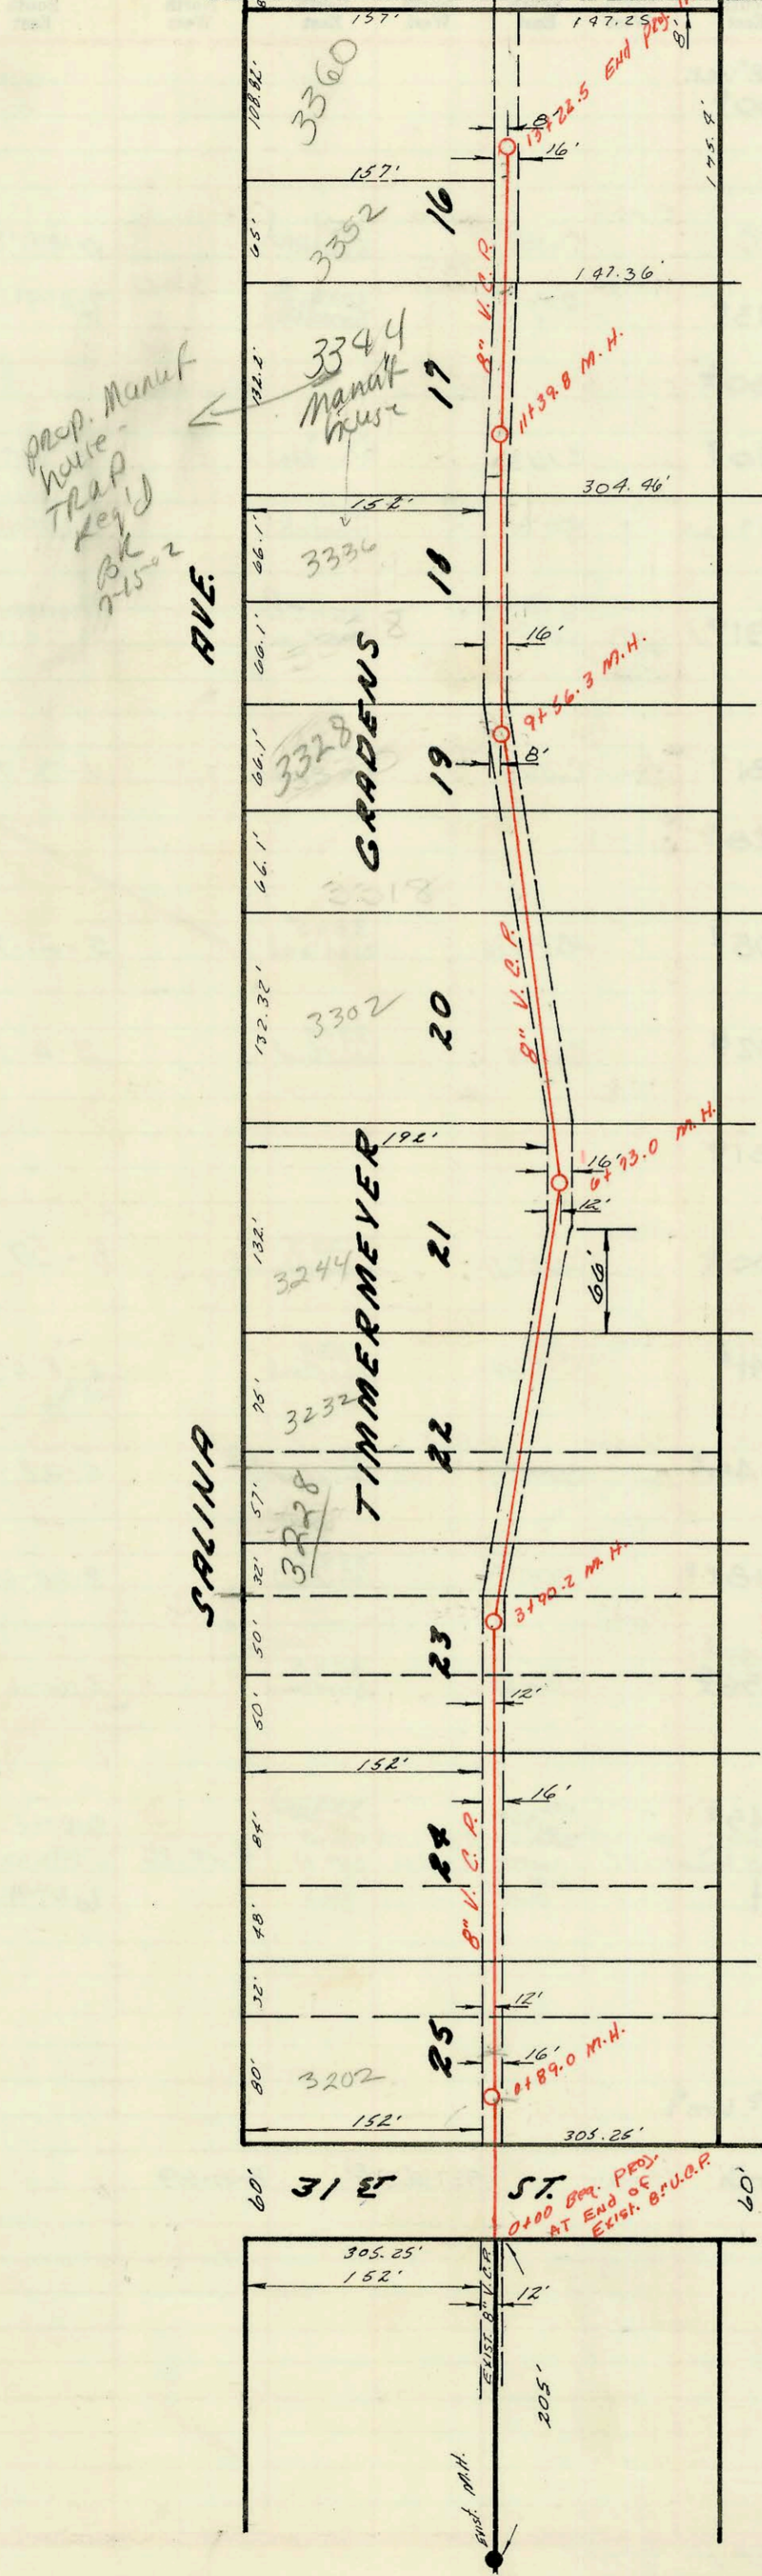

Prop. Manuf
White
Trap
Key'd
BK
715-2

Trap
Area

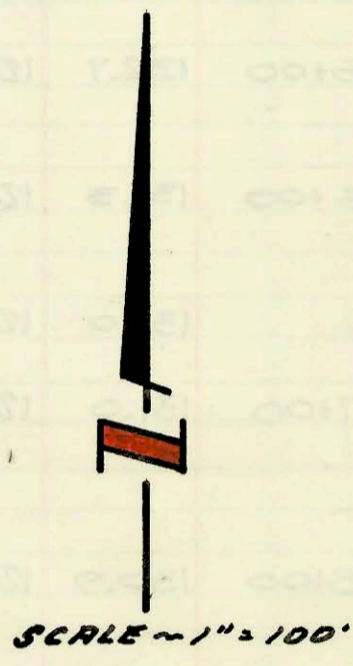

LAT. 16, SUB. 4, S.S. NO. 23

Mid States Const. Co. Inc.

BOOKED 8/19/69

PROJ. C23-68

I.H. 63

