


Refer to M-258 for line on w. side of Hood St.

Case file of
no sewer available for Hood

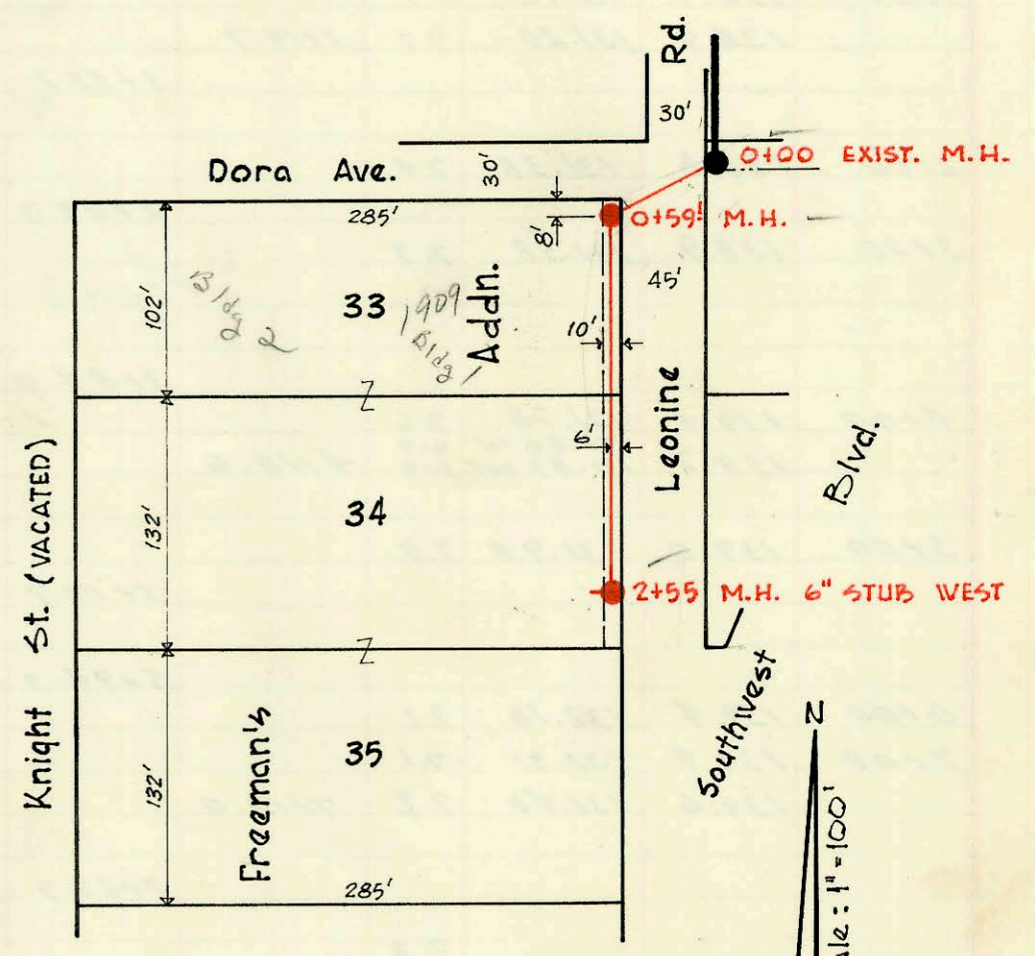

Ext. of Lat. 12, S.S. 22
Utility Contractors Inc.
Aug. 26, 1969 Private Project
Book S.S. JK 8

Scale: 1"=100'

Scale: 1"=100'

TRAP AREA

Lat. 15, Sub. 4, S.S. 23
Mid-States Construction Co., Inc.
Aug. 26, 1969. Proj. No. C23-67
Book I.H. 69

Flowers

CONSTRUCTION RECORD

SERVICE RECORD

STATION	ELEVATION		Depth	MANHOLE	4-INCH "Y" BRANCHES		No. of Permit		House Number		DATE OF PERMITS	
	Ground	Grade			North West	South East	North West	South East	North West	South East	North West	South East
0+00	128.8	119.99	8.8									
					0+64 ⁵	0+62 ⁵		263857	3201 Salina			11-3-77
1+00	129.6	120.29	9.3									
	129.6	120.44	9.2	1+50 ²								
					1+80 ²	1+78 ²		C15418	3207 Salina			8-15-69
2+00	129.5	120.59	8.9									
					2+79 ¹	2+77 ¹		C15869	3215 N SALINA			9-11-69
3+00	129.3	120.89	8.4									
					3+42 ⁵	3+42 ⁵		*C15807	3219 SALINA			9-8-69
4+00	128.9	121.19	7.7									
	128.7	121.25	7.5	4+20 ⁶								
					4+40 ⁰	4+28 ⁰		C15731	3229 Salina			9-4-69
5+00	128.8	121.49	7.3									
					5+74 ⁴	5+72 ⁴						
6+00	129.0	121.79	7.2									
					6+23 ⁰	6+21 ⁰		C128192	3237 N Salina			10-27
	129.7	122.00	7.7	6+70 ³								
7+00	129.2	122.09	7.1									
					7+00	7+03.3 ^{7AP}		18793	3305 Salina			7-30-87
8+00	130.4	122.39	8.0									
					8+10 ²							
9+00	130.2	122.68	7.5	8+96 ⁰								
	130.2	122.69	7.5									
					9+04 ⁰	9+70 ⁰		*C18012 C15710	3315 Salina 3333 N Salina			2-17-70 9-3-69
10+00	130.3	122.99	7.3									
					10+21 ²	10+19 ⁵		C15711	3337 N Salina			9-3-69
11+00	130.7	123.29	7.4									
					11+10 ²	11+08 ²						
	130.6	123.35	7.3	11+20 ⁸								
12+00	130.5	123.59	6.9									
					11+65.5 ⁵	11+67 ⁵		*C17211 C68258	3345 SALINA Salina (Dams)			12-5-69 9/8/78
13+00	130.8	123.89	6.9									
	131.3	124.04	7.3	13+50 ⁴								
					6" stub west			C1556A	1901 Av. Blvd.			8-22-69

s.s. 23
 Sub. 4
 Lat. 15

s.s. 22
 Ext. Lat. 12