
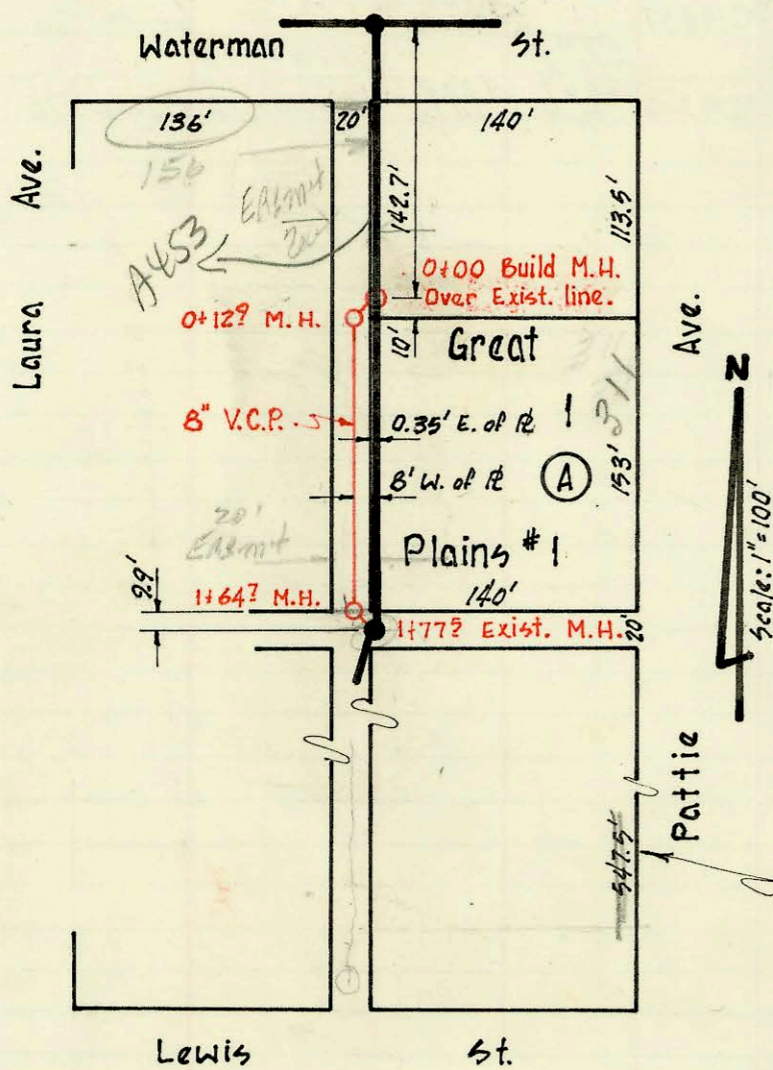


1/2 16' Sewer Easement acq. 2-20-75 on Lot 50, W.S.

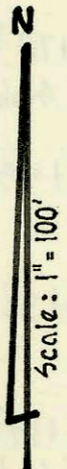


Lat. 49, Westlink Sewer
 Mid - States Construction Company, Inc.
 Date: 9-16-69 Project No. C28-69
 Book I.H.-64

oh map

Relocation of part of **Lat. 10, S.S. 4.**
 Utility Contractors Inc.
 Date: Oct. 23, 1969. Private Project
 Book I.H.-62

oh map

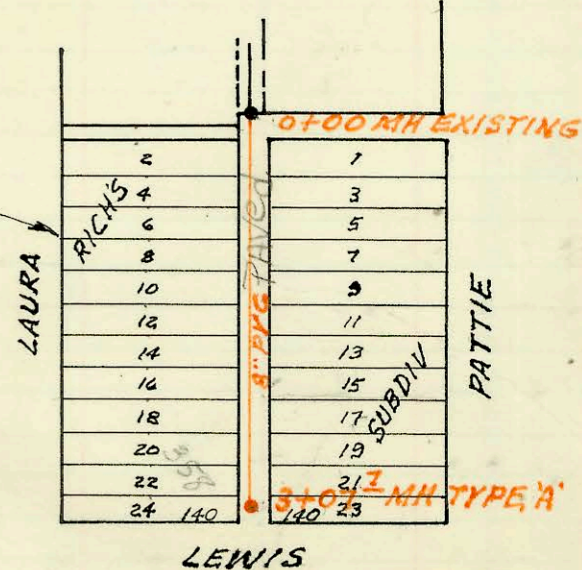

RECONSTRUCTION OF LAT 10 SS N20
 IN ALLEY BTW LAURA & PATTIE - N. LEWIS to N. RICH'S SUB
 BUILT BY: W.B. CARTER CONST. CO.
 PROJ. N° 542-80-245-80024-000-000-001
 BOOKED 1-15-80 FROM JLA 31

CONSTRUCTION RECORD

SERVICE RECORD

STATION	ELEVATION		Depth	MANHOLE	4-INCH "Y" BRANCHES		No. of Permit		House Number		DATE OF PERMITS	
	Ground	Grade			North West	South East	North West	South East	North West	South East	North West	South East
Line 1												
0+00	152.3	145.19	7.1	Exist. M.H.								
1+00	152.8	145.39	7.4									
	152.8	145.97 in 145.47 out	7.3	1+40°	= 0+00 Line 2	1+87°		C54198	1304 Sunset	1315 Palmer		3-15-76
2+00	153.3	145.69	7.6									
3+00	153.9	145.89	8.0									
4+00	153.0	146.09	6.9									
	152.6	146.16	6.4	4+35°	= 0+00 Line 3	4+63°						
5+00	152.0	146.29	5.7									
	152.5	146.48 in 146.37 out	6.1	5+43°	4" stub E.	5+62°		C51886	1252 Sunset	1335 Wilbur		10-14-75
6+00	152.6	146.99	6.0									
7+00	153.0	146.79	6.2									
8+00	153.3	146.95	6.3	7+82°								
	153.5	146.99	6.9									
9+00	153.1	147.19	5.9									
10+00	152.9	147.39	5.5									
	152.7	147.41	5.3	10+11°								
Line 2												
0+00	152.8	145.47	7.3	Exist. M.H.	1+40° Line 1							
0+85°	153.2	145.73	7.5	Plug	10+10			C65104	1310 Sunset			2-22-78
Line 3												
0+00	152.8	146.26	6.6	Exist. M.H.	4+35° Line 1							
0+95	153.8	146.45	7.4	Plug	0+57			C51623	1262 Sunset Dr.			9-30-75
Lat. 49, Westlink Sewer												
	107.7	102.38	5.3	0+00	New M.H. over exist. line.							
	107.7	102.40	5.3	0+12°								
1+00	107.5	102.54	5.0									
	107.5	102.64	4.8	1+64°	1+30°							
	107.5	102.66	4.8	1+77°	Exist. M.H.			C32260	320 Laura			5-16-72
Lat. 10, S.S. 4.												
LATERAL 10 SS N²⁰ RECON IN ALLEY BTW LAURA & PATTIE N LLEWIS - N L RICH'S SUB												
0+00	107.7	102.75	5.0	EXISTING	6" TRAP & CLEANOUT							
1+00	107.4	102.95	4.5		1+44 10° W 1+25 12° E							
2+00	107.1	103.15	4.0		2+02 8° W 2+50 9° E 2+53 9° W 2+67 8° E			1248	351 S Pattie			9-15-80
3+00	106.7	103.35	3.4		2+56.7			1249	358 S Laura			9-15-80
	106.7	103.36	3.3	3+07.7				8659				7-7-83

C54198 - 1315 71 Sunset - 3-15-76
 Jap C54199 - 1304 71 Sunset Dr. - 3-15-76
 C51886 - 1252 " " - 10-14-75
 Jap C71720 311 Pattie - 5-14-79 (0+58.9)