


**Lat. 25, S.S. No. 23**  
 W. B. Carter Construction Co., Inc.  
 Date: 10-3-69 Proj. No. C29-37  
 Book I.H.70

*OH map*

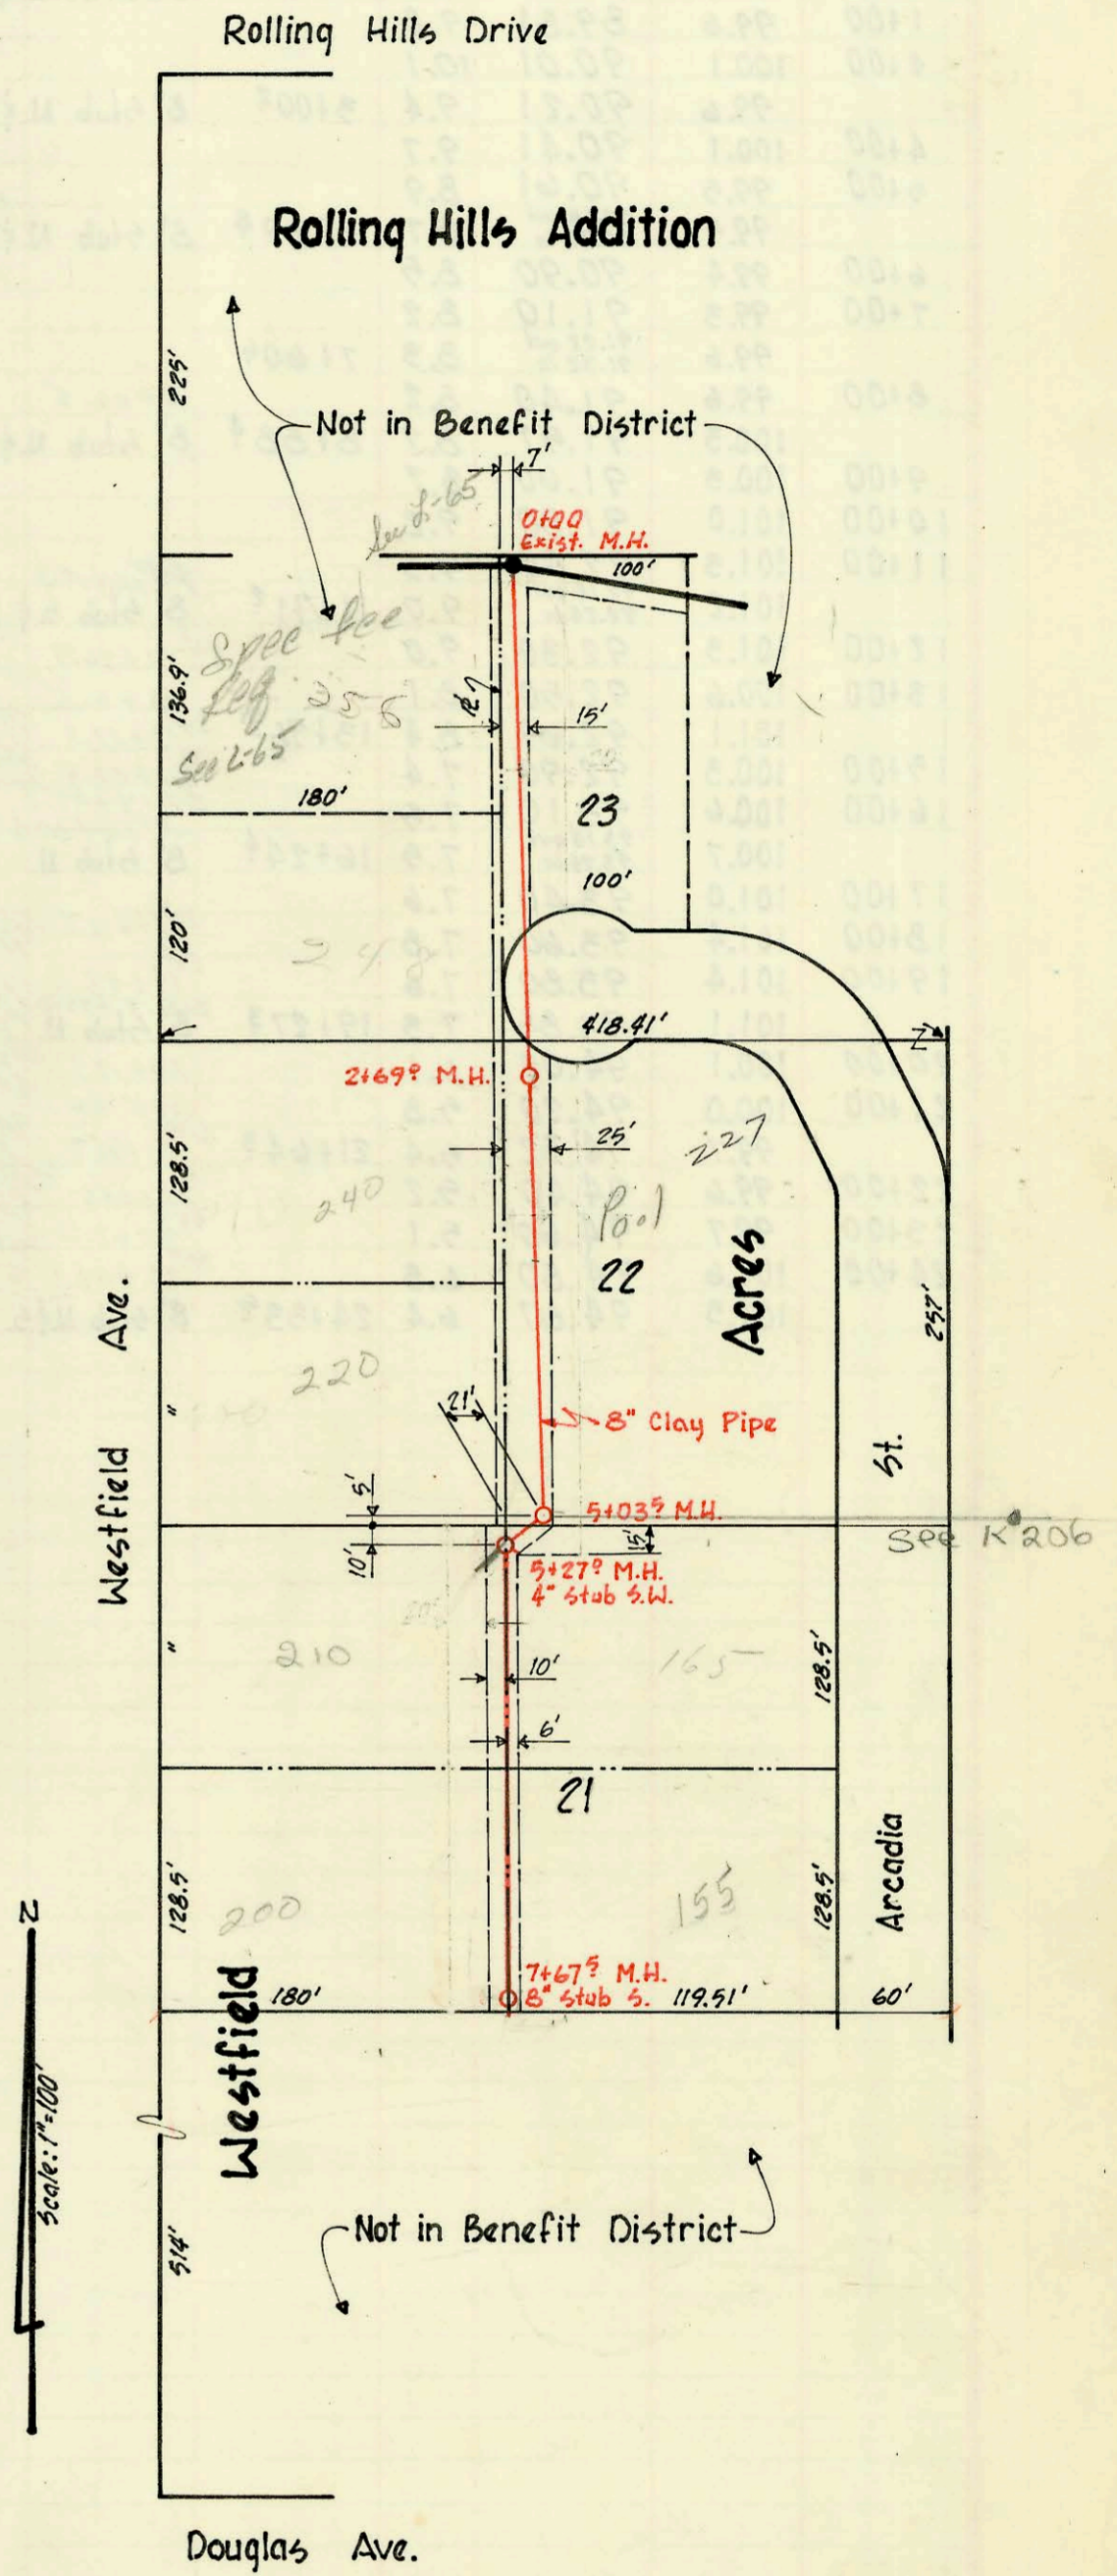

**Lat. 7, Sub. 1, Westlink**  
 W.B. Carter Construction Company, Inc.  
 Date: Oct. 8, 1969 Project No. C26-73  
 Book K-89

*OH map*

