
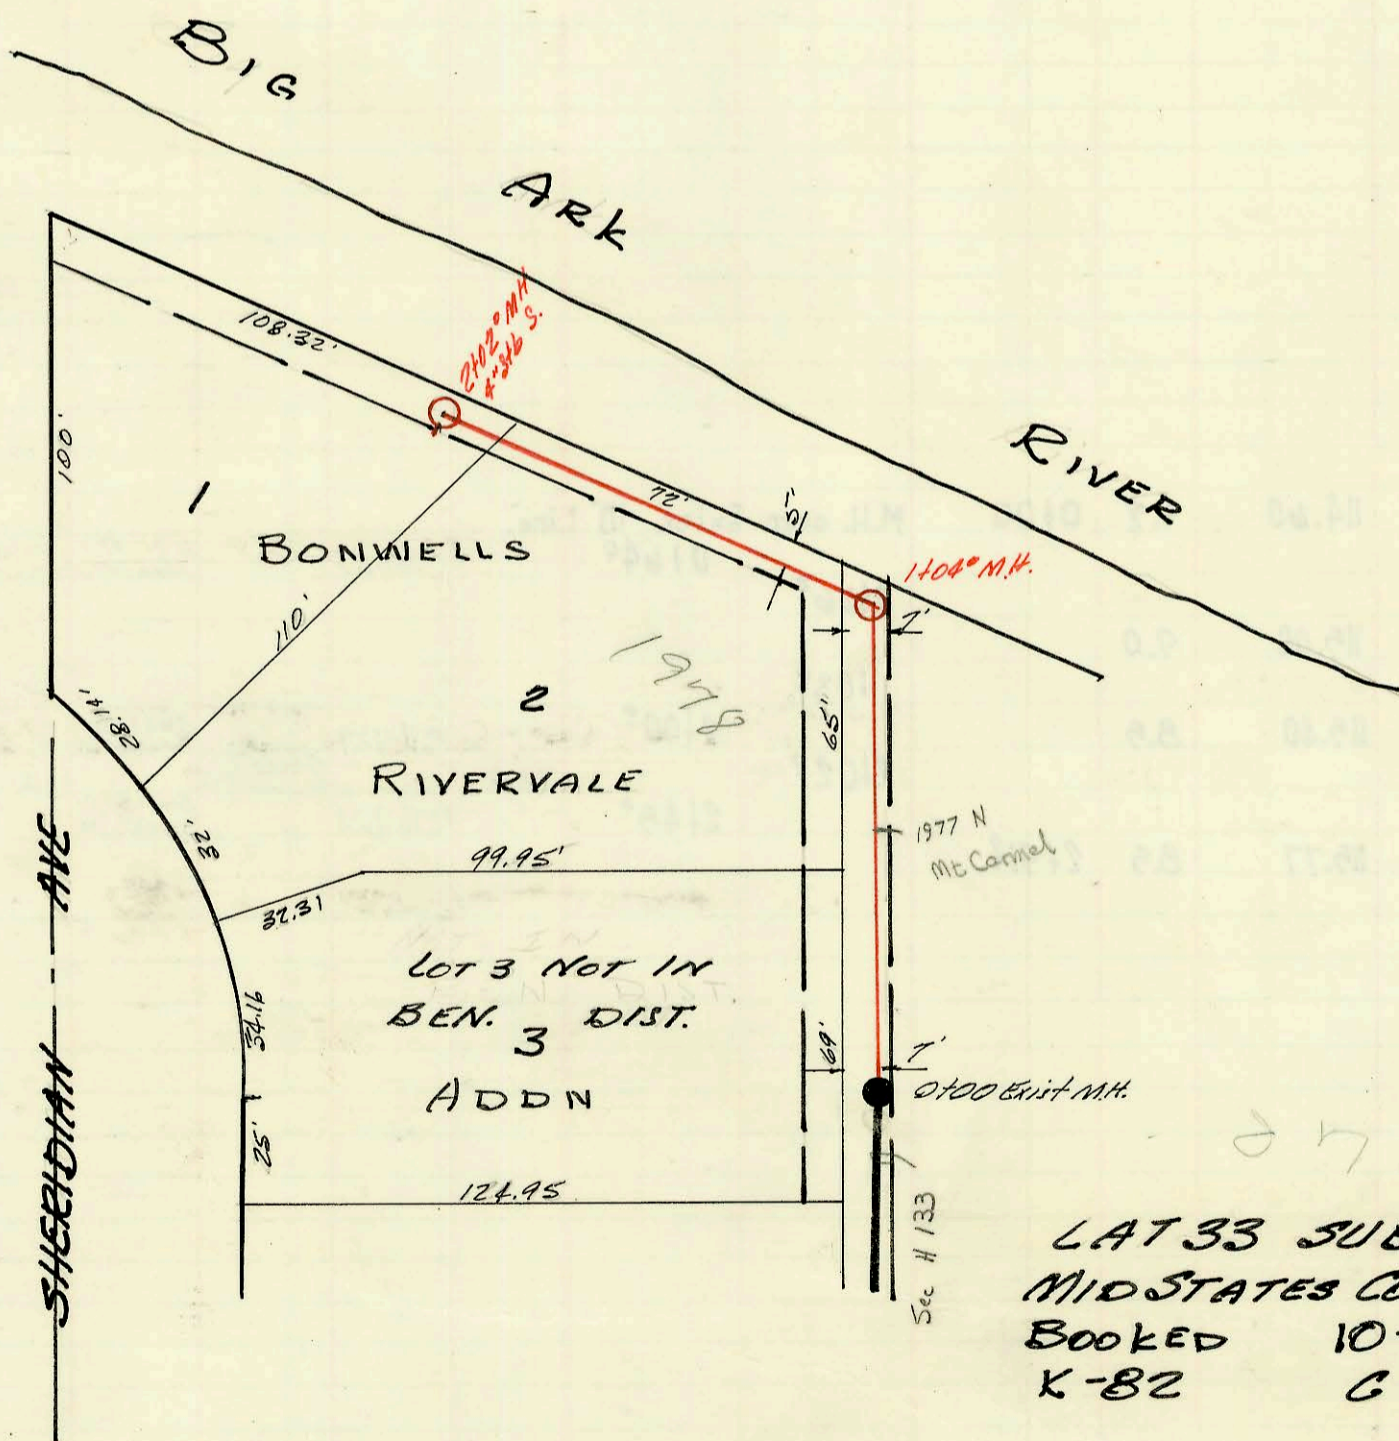


LAT 32 SUB 10 53*22
 MID STATES CONSTR CO. INC.
 BOOKED 10-22-69
 K-82 C 29-13

on map

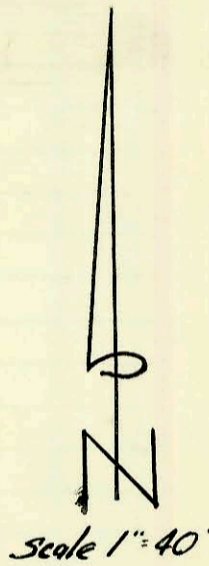

LAT 33 SUB 10 55*22
 MID STATES CONSTR CO. INC.
 BOOKED 10-22-69
 K-82 C 29-31

on map

CONSTRUCTION RECORD						SERVICE RECORD						
STATION	ELEVATION		Depth	MANHOLE	4-INCH "Y" BRANCHES		No. of Permit		House Number		DATE OF PERMITS	
	Ground	Grade			North West	South East	North West	South East	North West	South East	North West	South East
	124.0	119.60	4.4	0+00	Exist. M.H. 0+23.5				1938 N. Richmond		5-13-74	
1+00	124.6	120.00	4.6		1+07.5 1+05.5							
	124.6	120.12	4.5	1+30°	4" Sub. E. & W.		2003- 01650		1946 N Richmond		6-24-03	
0+00	127.1	119.42	7.7	0+00	Exist. M.H. 0+58 0+54.5 top		10545	061916	1978 Sheridan	1977 McConnell	4-3-84	7-1-77
1+00	127.4	119.830W 119.935N	7.6	1+04°								
2+00	127.8	120.32	7.5	2+02°	4" Sub. So.		10545 015810		1978 N Sheridan 1978 N Sheridan		4-3-84	9-10-69