


Scale: 1" = 100'

Lat. 202, Sm. 5, S.S. 22.

W. B. Carter Construction Company, Inc.
 Date: Oct. 23, 1969 Proj. No. C29-12
 Book K-89

on map

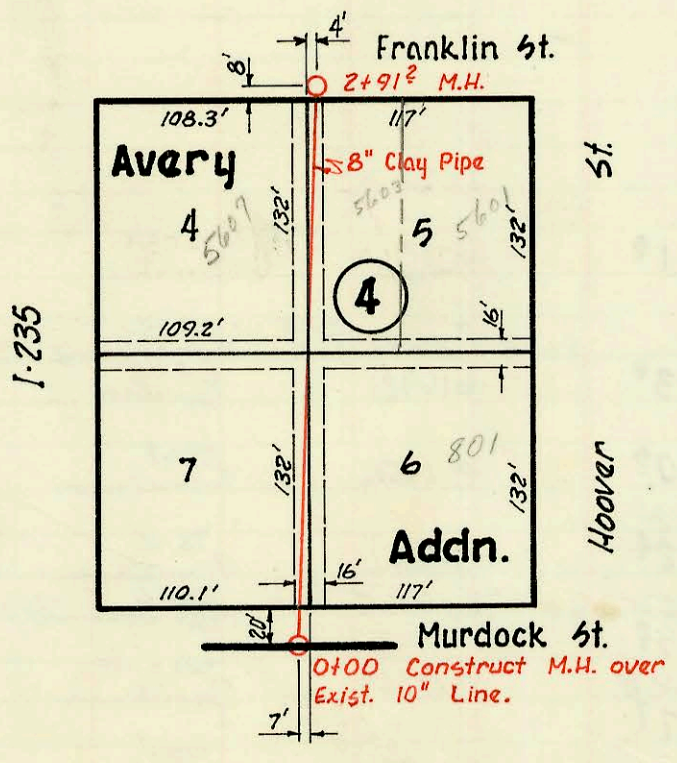

Scale: 1" = 100'

Lat. 201, Sub 5, S.S. No. 22

W. B. Carter Construction Company, Inc.
 Date: Nov. 13, 1969 Project No. C29-7
 Book: K-90

Form 212

CONSTRUCTION RECORD

SERVICE RECORD

Lat. 202, Sub. 5, S.S. No. 22

Lat. 201, Sub. 5, S.S. No. 22

STATION	ELEVATION		Depth	MANHOLE	4-INCH "Y" BRANCHES		No. of Permit		House Number		DATE OF PERMITS	
	Ground	Grade			North West	South East	North West	South East	North West	South East	North West	South East
	128.9	120.45	8.4	0+00	Exist. M.H.							
1+00	127.3	120.65	6.6		0+53.1 1+65.6	0+19 ⁵	C68454 C24452	1649 1652 HARLAN	1701 Westlyn	9-20-78	5-19-71	
	127.6	120.85	6.8	1+98 ⁰	4" stub E.	1+11 ⁸	C80271 C30853	1701 Westlyn	1715 Westlyn	2-1-72	3-8-72	
3+00	128.0	121.05	7.0		2+50.2	2+84 ⁰	*01061 C34025	1658 HARLAN	1731 Westlyn	8-22-80	8-1-72	
4+00	128.4	121.25 121.39 out 121.49 in	7.2	4+68 ⁰		3+63 ⁰	C45949	1662 HARLAN	1727 Westlyn	5-18-83	7-29-74	
5+00	129.2	121.55 121.73 out 121.83 in	7.6	5+89 ¹	5+03.3		*0187	1663 HARLAN		9-30-80		
6+00	128.7	121.85	6.8		Top 7+01.6 6+32.3	6+30 ³	C39094	1667 HARLAN	1733 Westlyn	5-21-80	5-18-73	
	129.9	121.95	7.6	7+13 ⁶	4" stub E.		379 C54971	1739 Westlyn		4-26-76		
	123.8	114.60	9.2	0+00	M.H. over Exist. 10" Line.	0+64 ⁰	C8628		801 N. HARLAN		4-1-70	
1+00	124.0	115.00	9.0		0+66 ⁰	1+03 ⁰						
2+00	123.9	115.40	8.5		2+02 ⁰	2+00 ⁰	C16727 7281	5607 Franklin	5001 W. Franklin	12-30-82	11-14-69	
	124.3	115.77	8.5	2+91 ⁰		2+45 ⁰	C16728	5603 W. Franklin			11-14-69	